


PARENT PARCEL: 04-00-024-116-208, -142


CHILD PARCEL: 04-00-024-116-209, -210

STARTING POINT: WESTERLY SIDE OF CROWN COLONY DR IN RED TAIL SUBD NO 4

11-02895

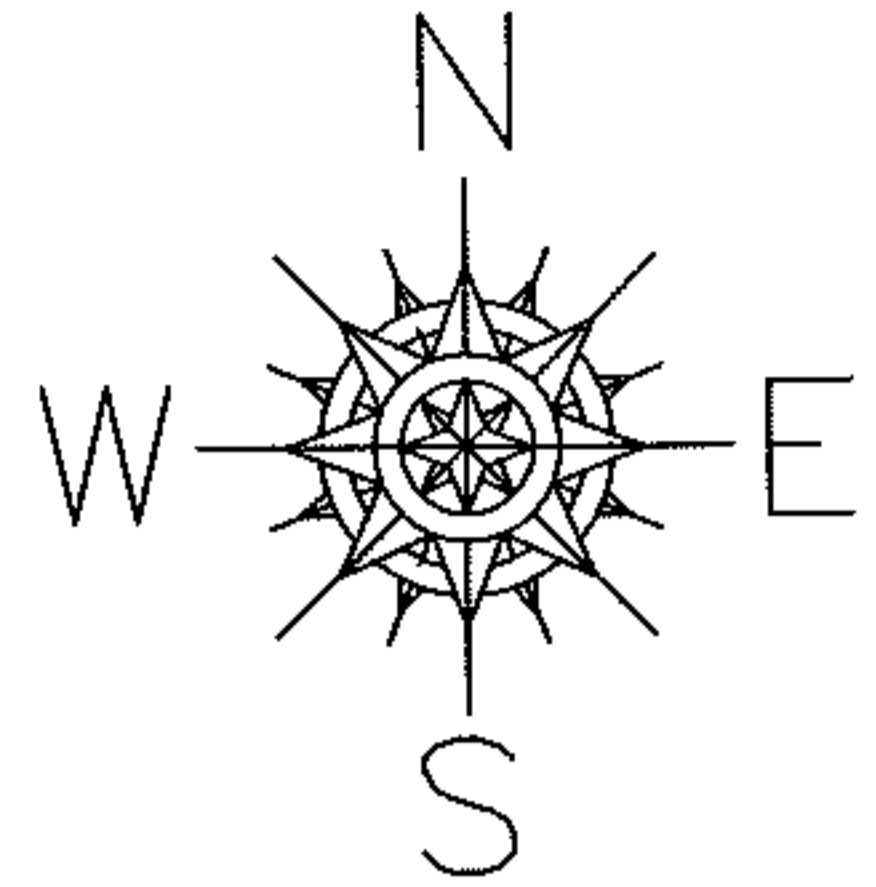

RED TAIL DEV. NO 4  
VOL 60 PG 62

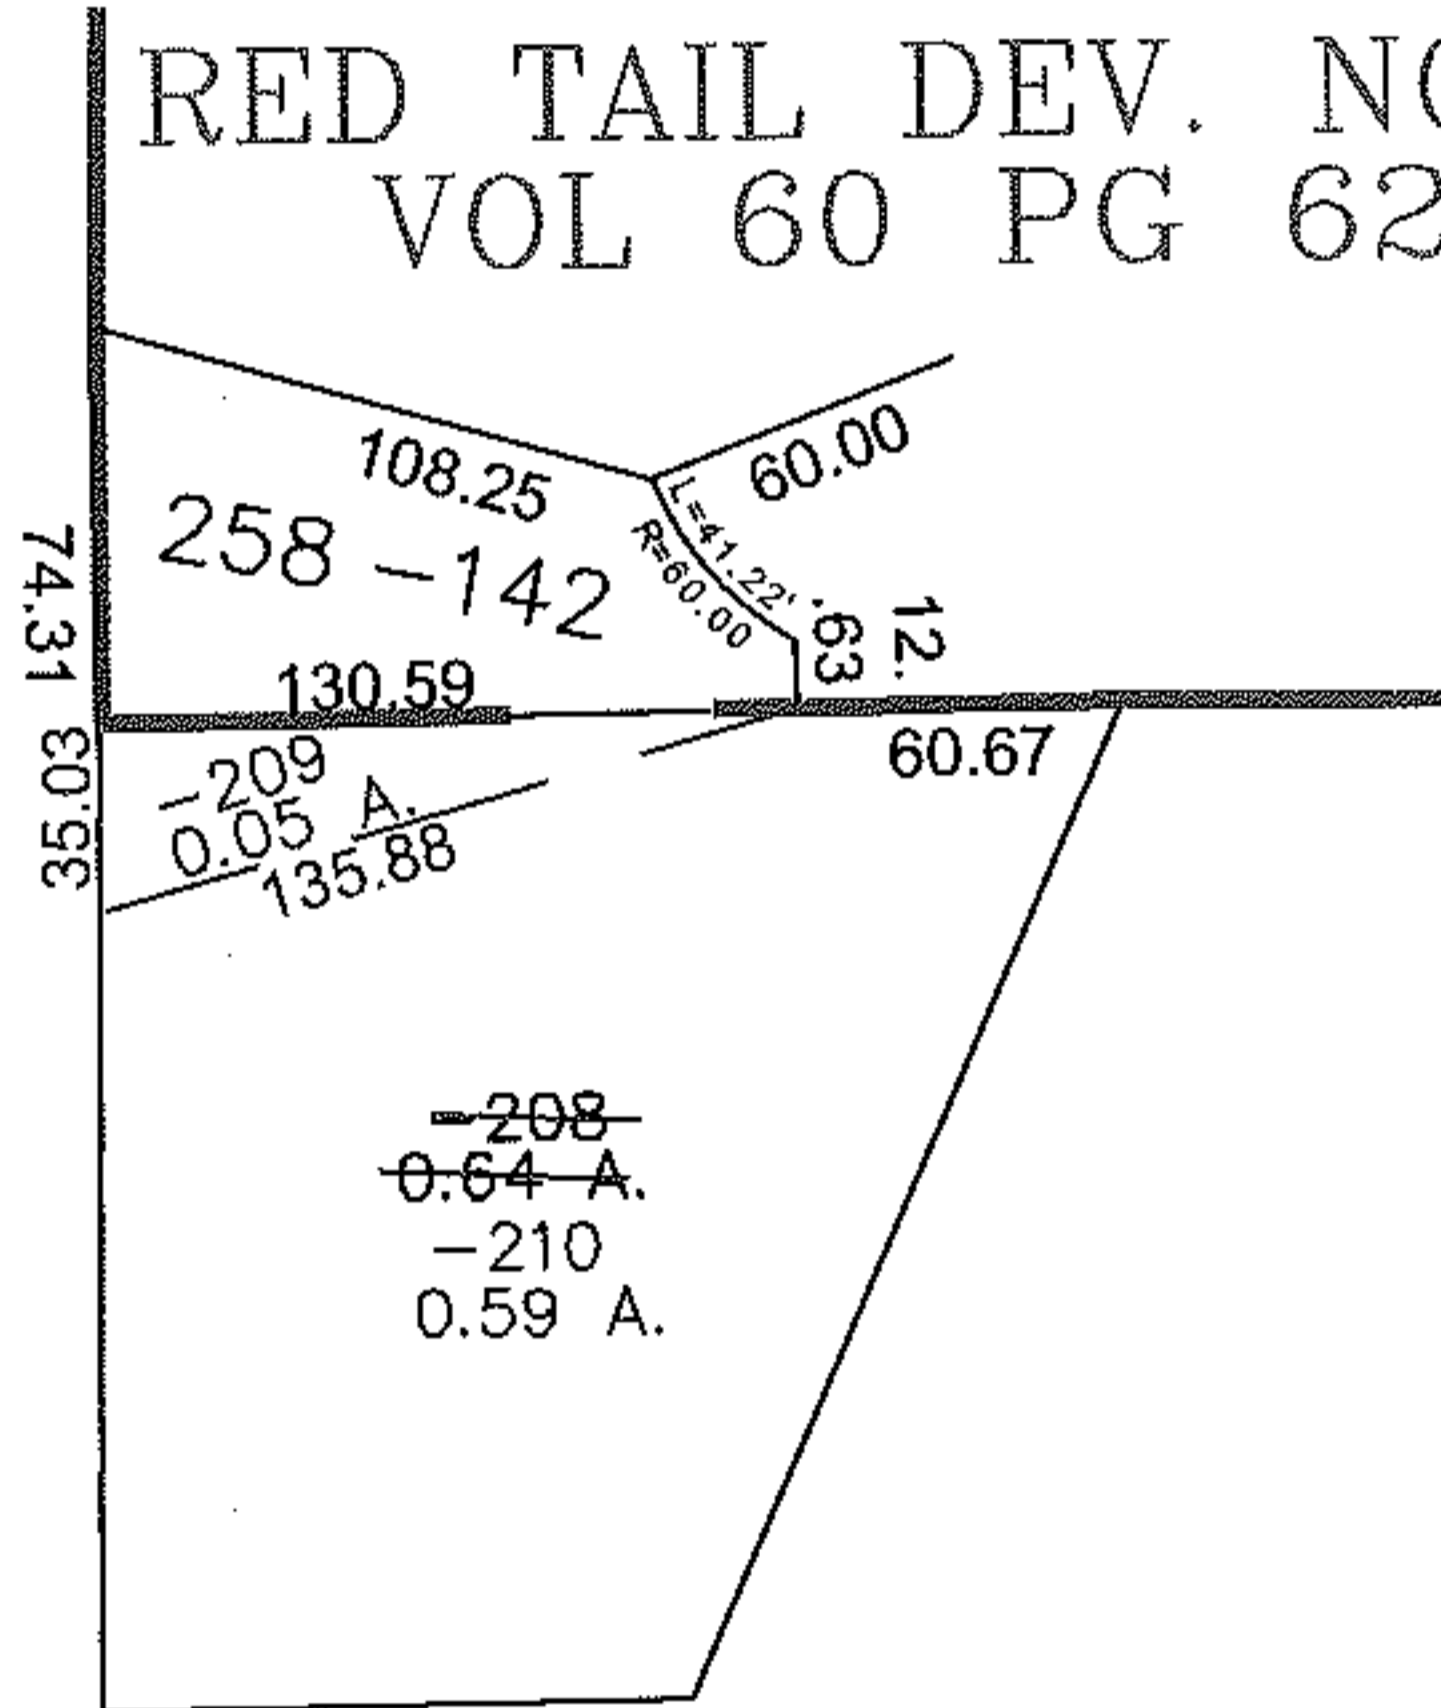

SPLITS/DEEDS PROCESSED

LORAIN COUNTY TAX MAP DEPARTMENT  
226 MIDDLE AVE. ELYRIA, OHIO

SURVEYED BY: MICHAEL SPELLACY

CLOSURE: 0.00 : 10,000

MAP PAGE(S): 04-00-024-G

APPROVED BY: JAH DATE: 2/14/2011

SCALE: 1" = 100 PRIOR INSTRUMENT: 20040036824