



PARENT PARCEL: 14-00-028-000-011, 14-00-033-000-008

CHILD PARCEL: 14-00-028-000-011, -018, 14-00-033-000-008

14-02896-C

STARTING POINT: _____

ADD TO DUP.
14-00-028-000-018
0.58 A.
IN THE NAME OF
ADELAIDE M. JOHNSON
LAST CONVEYED IN
DV 704/272

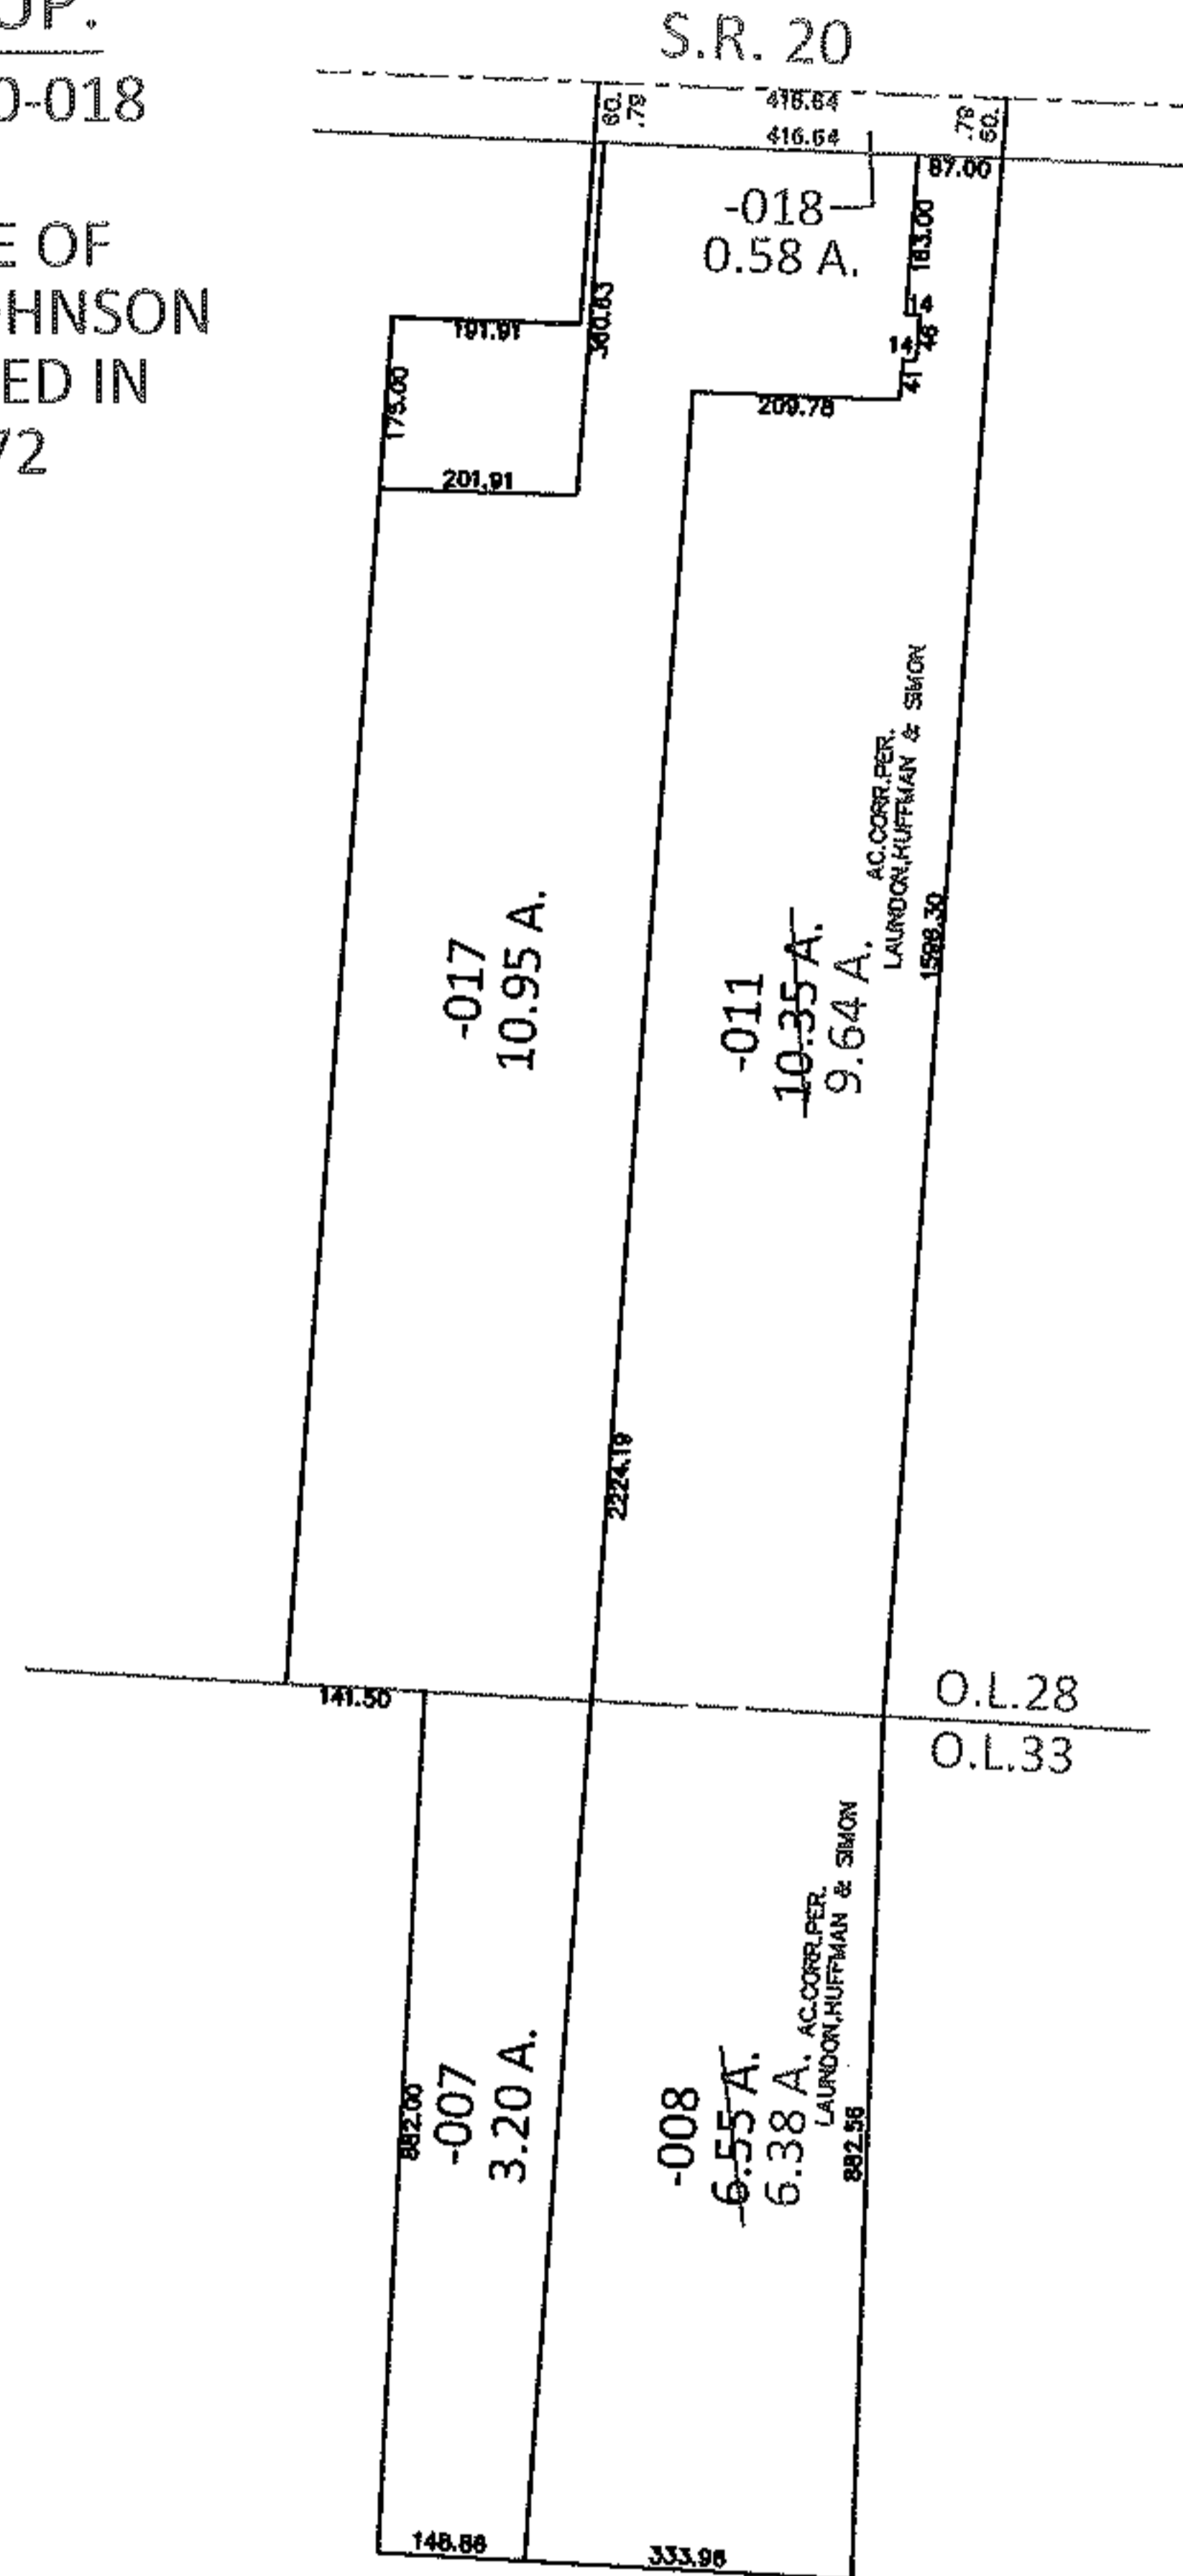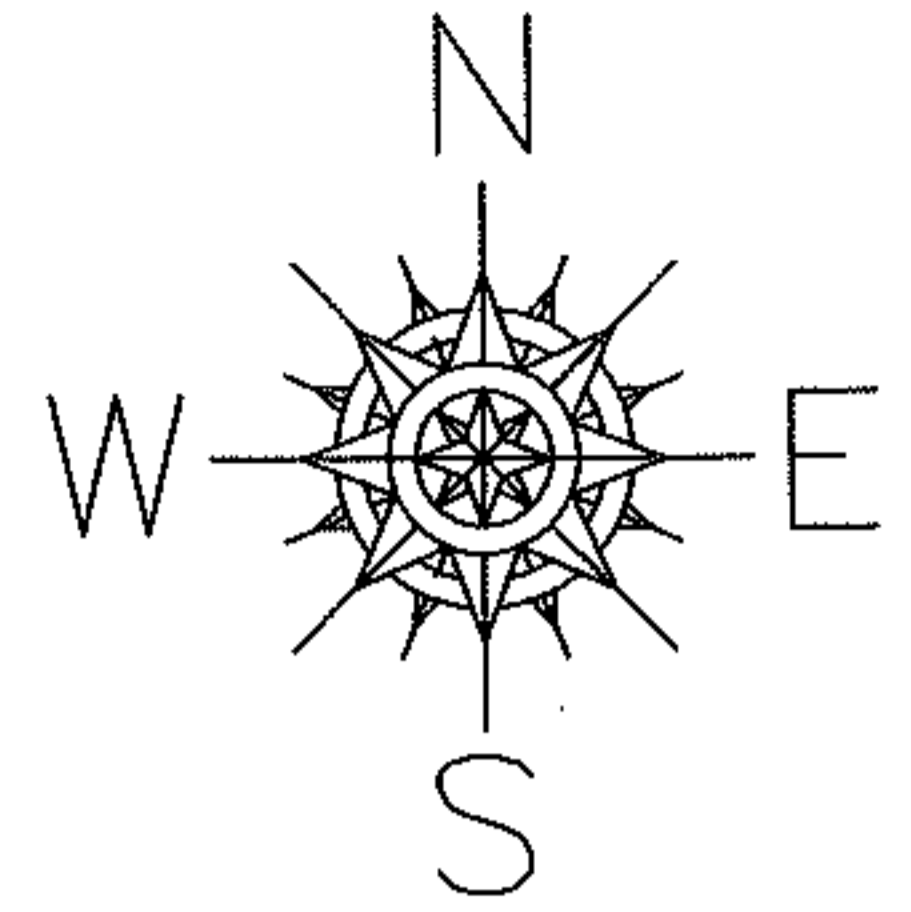

MAP CORRECTION ONLY

14-00-028-000-011

~~10.35 A.~~
9.64 A.

14-00-033-000-008

~~6.55 A.~~
6.38 A.

SPLITS/DEEDS PROCESSED

LORAIN COUNTY TAX MAP DEPARTMENT
226 MIDDLE AVE. ELYRIA, OHIO

SURVEYED BY: LAUNDON, HUFFMAN & SIMON

CLOSURE: .01:10,000

MAP PAGE(S): 14-B

APPROVED BY: RRM DATE: 2-25-14

SCALE: 1"= 400 PRIOR INST.: DV 704/272