
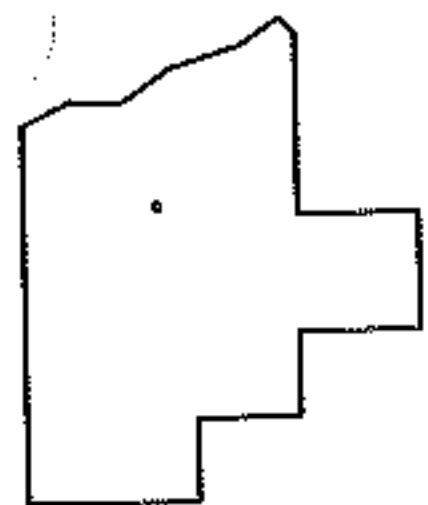
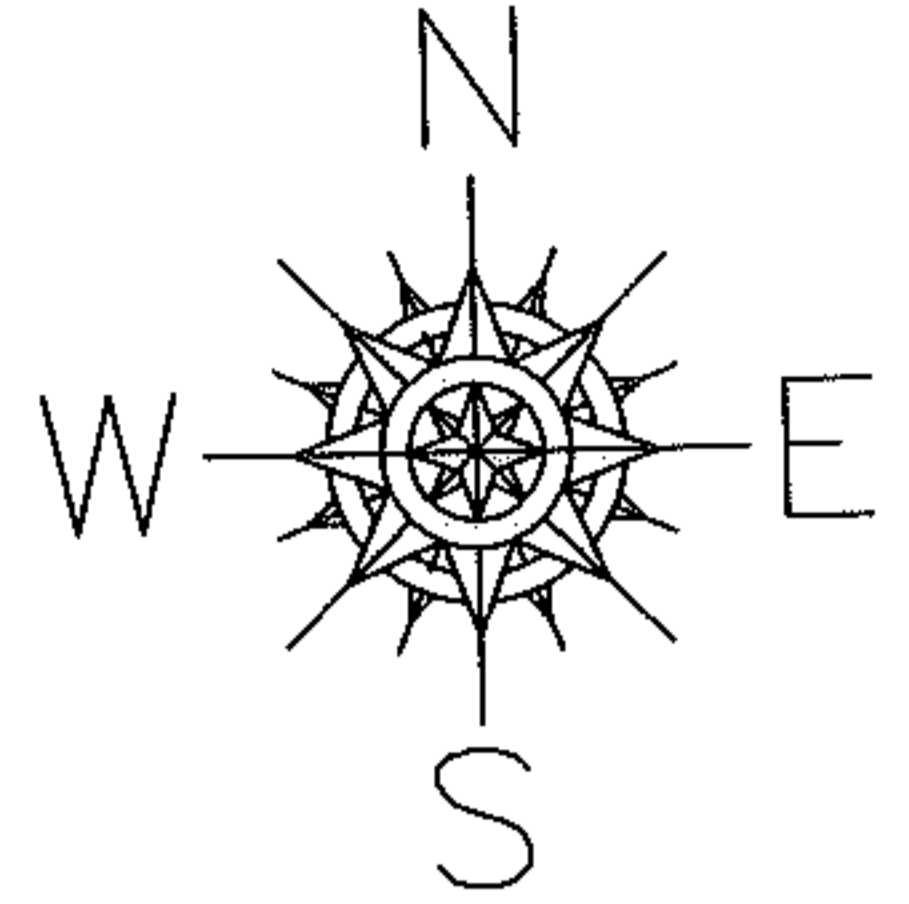


PARENT PARCEL: 12-00-001-000-006

CHILD PARCEL: \_\_\_\_\_

14-02897-C

STARTING POINT: AT A MON BOX AT THE NORTHWEST CORNER OF O.L.1

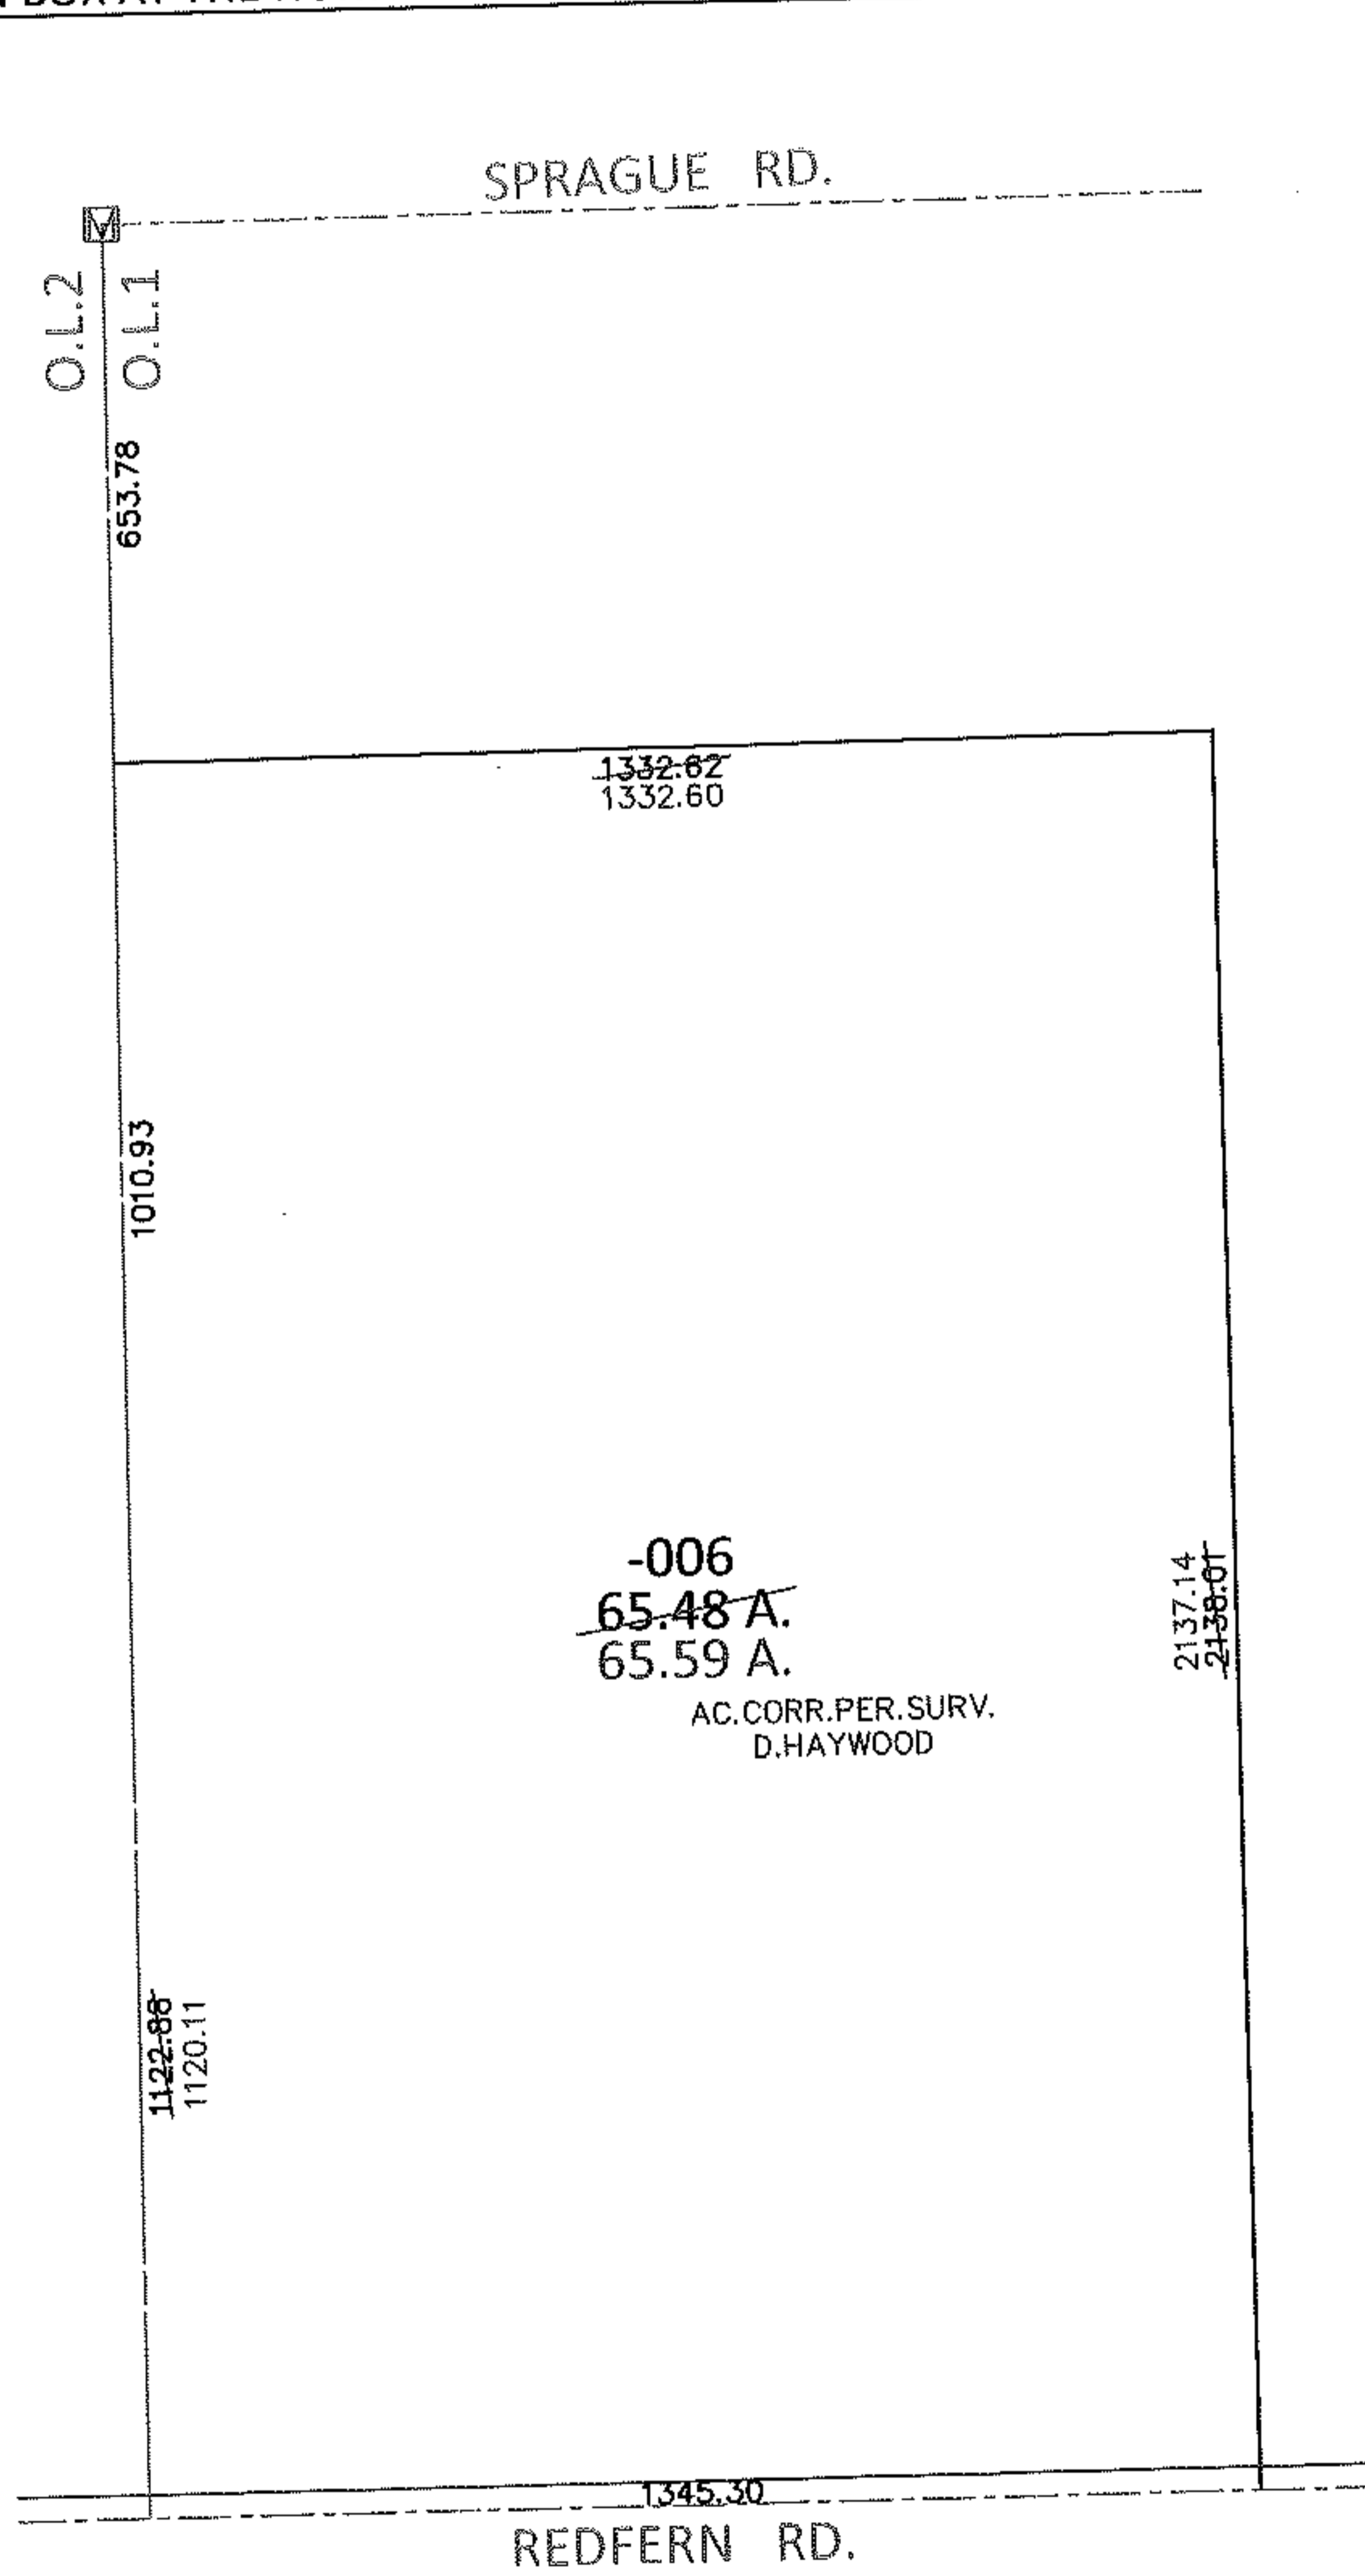

SPLITS/DEEDS PROCESSED

LORAIN COUNTY TAX MAP DEPARTMENT  
226 MIDDLE AVE. ELYRIA, OHIO

SURVEYED BY: DALE R. HAYWOOD

CLOSURE: .01:10,000

MAP PAGE(S): 12-00-001-A

APPROVED BY: RRM DATE: 3-5-14

SCALE: 1"= 400 PRIOR INST.: OR 807/813