
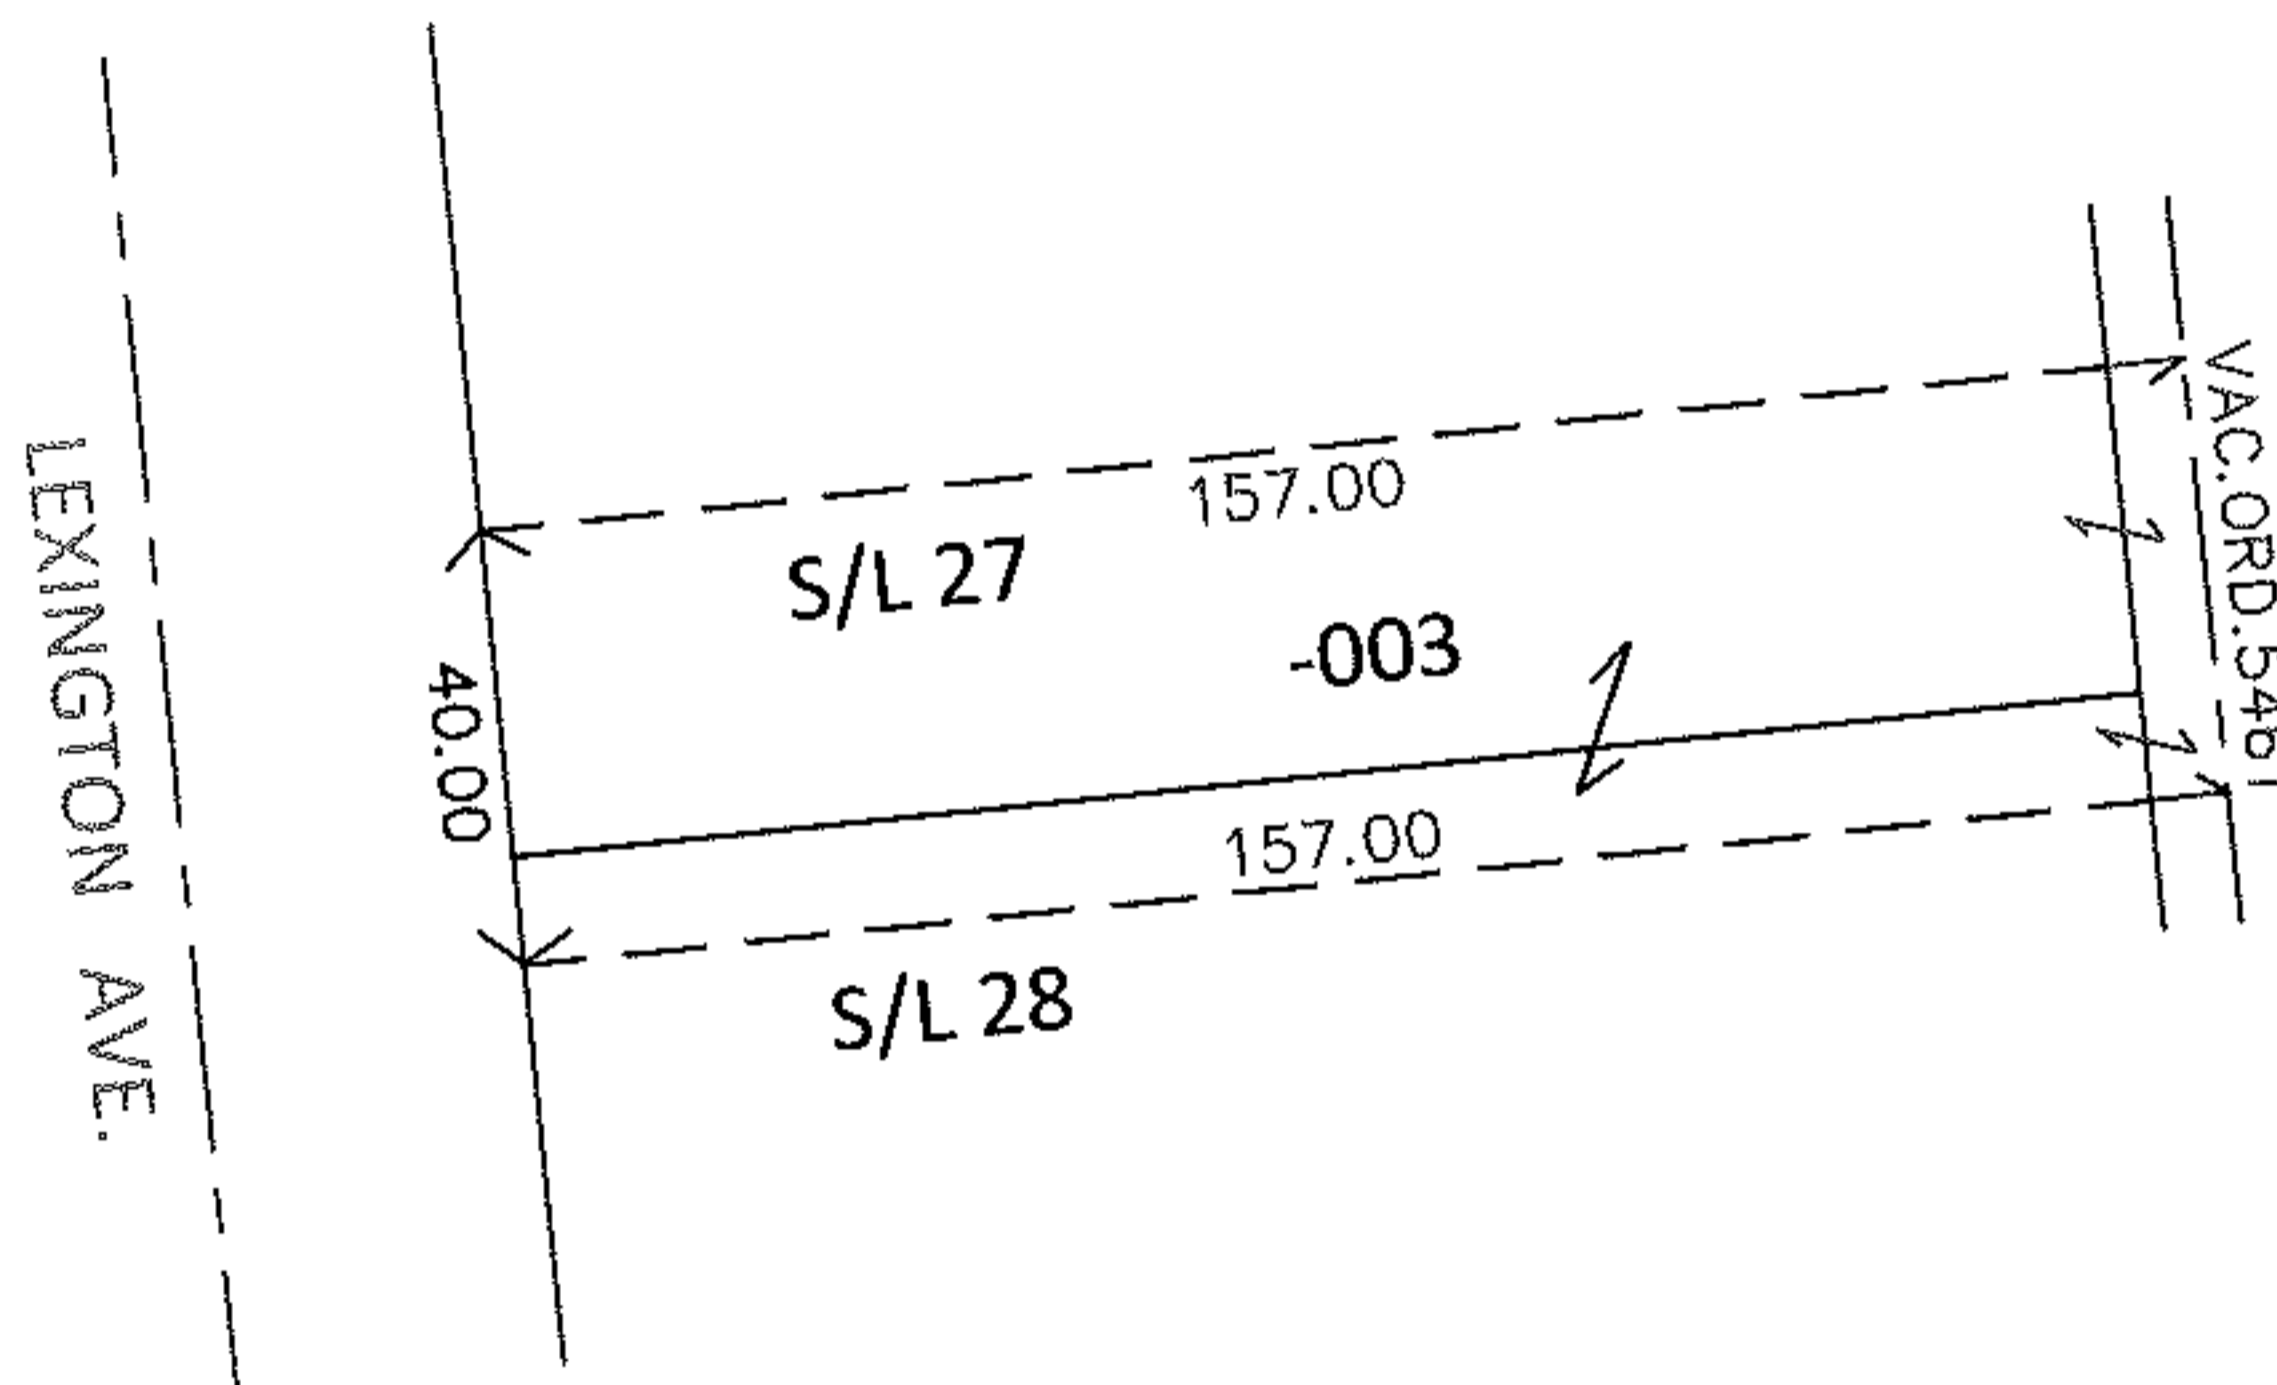


PARENT PARCEL: 02-01-003-209-003

CHILD PARCEL: _____

STARTING POINT: SOUTH 30 FT. OF S/L 27 & NORTH 10 FT. OF S/L 28 IN DANIELS & BRAUNS ADD. (VOL.4 PG.41)

14-02898-X

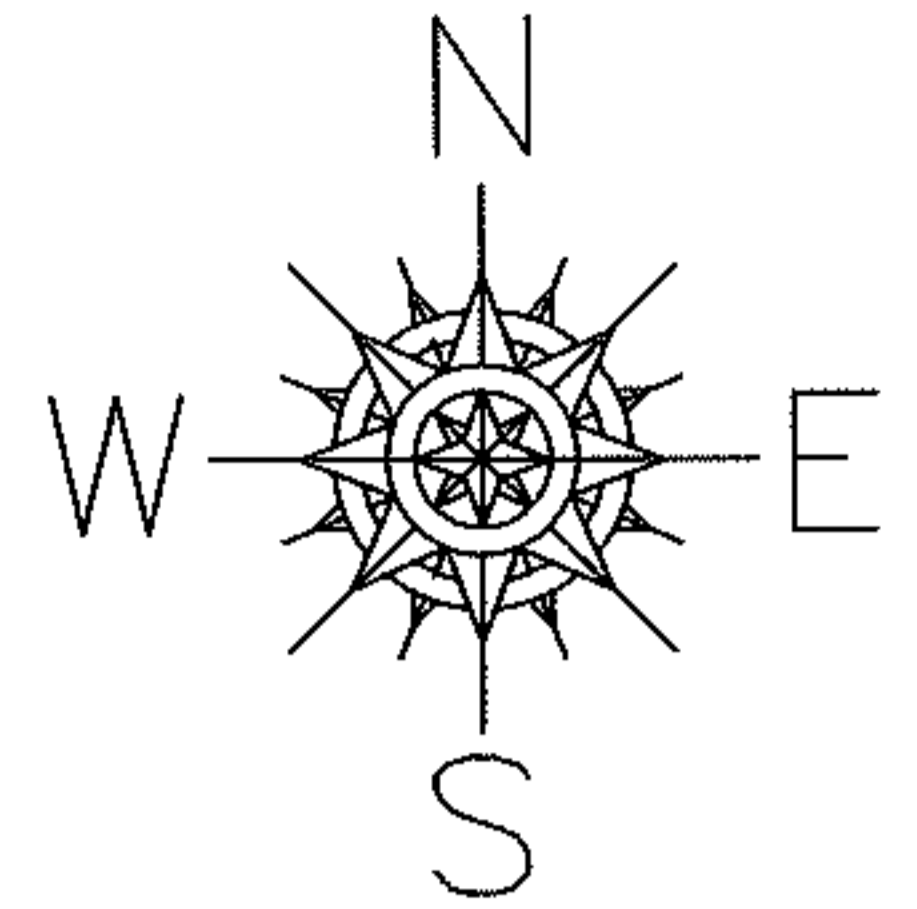


DEPTH CORRECTION

02-01-003-209-003

157

40 X ~~150~~

PER DEED AND ORD. NO.5461

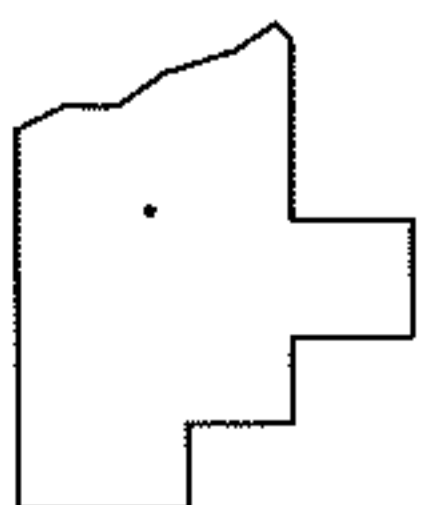

SPLITS/DEEDS PROCESSED

LORAIN COUNTY TAX MAP DEPARTMENT
226 MIDDLE AVE. ELYRIA, OHIO

SURVEYED BY: N/A

CLOSURE: N/A

MAP PAGE(S): 2-01-003-J

APPROVED BY: RRM DATE: 3-13-14

SCALE: 1" = 50' PRIOR INST.: 20140497101