

PARENT PARCEL: ADD TO DUPLICATE

CHILD PARCEL: 12-00-070-630-002

STARTING POINT: XXXXXX




14-02899-A

ADD TO DUPLICATE

12-00-070-630-002

10 X 10

API# 34093211640

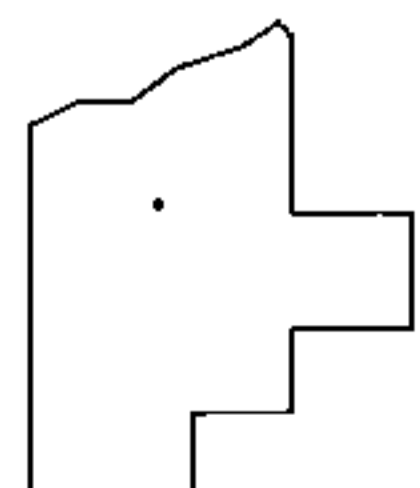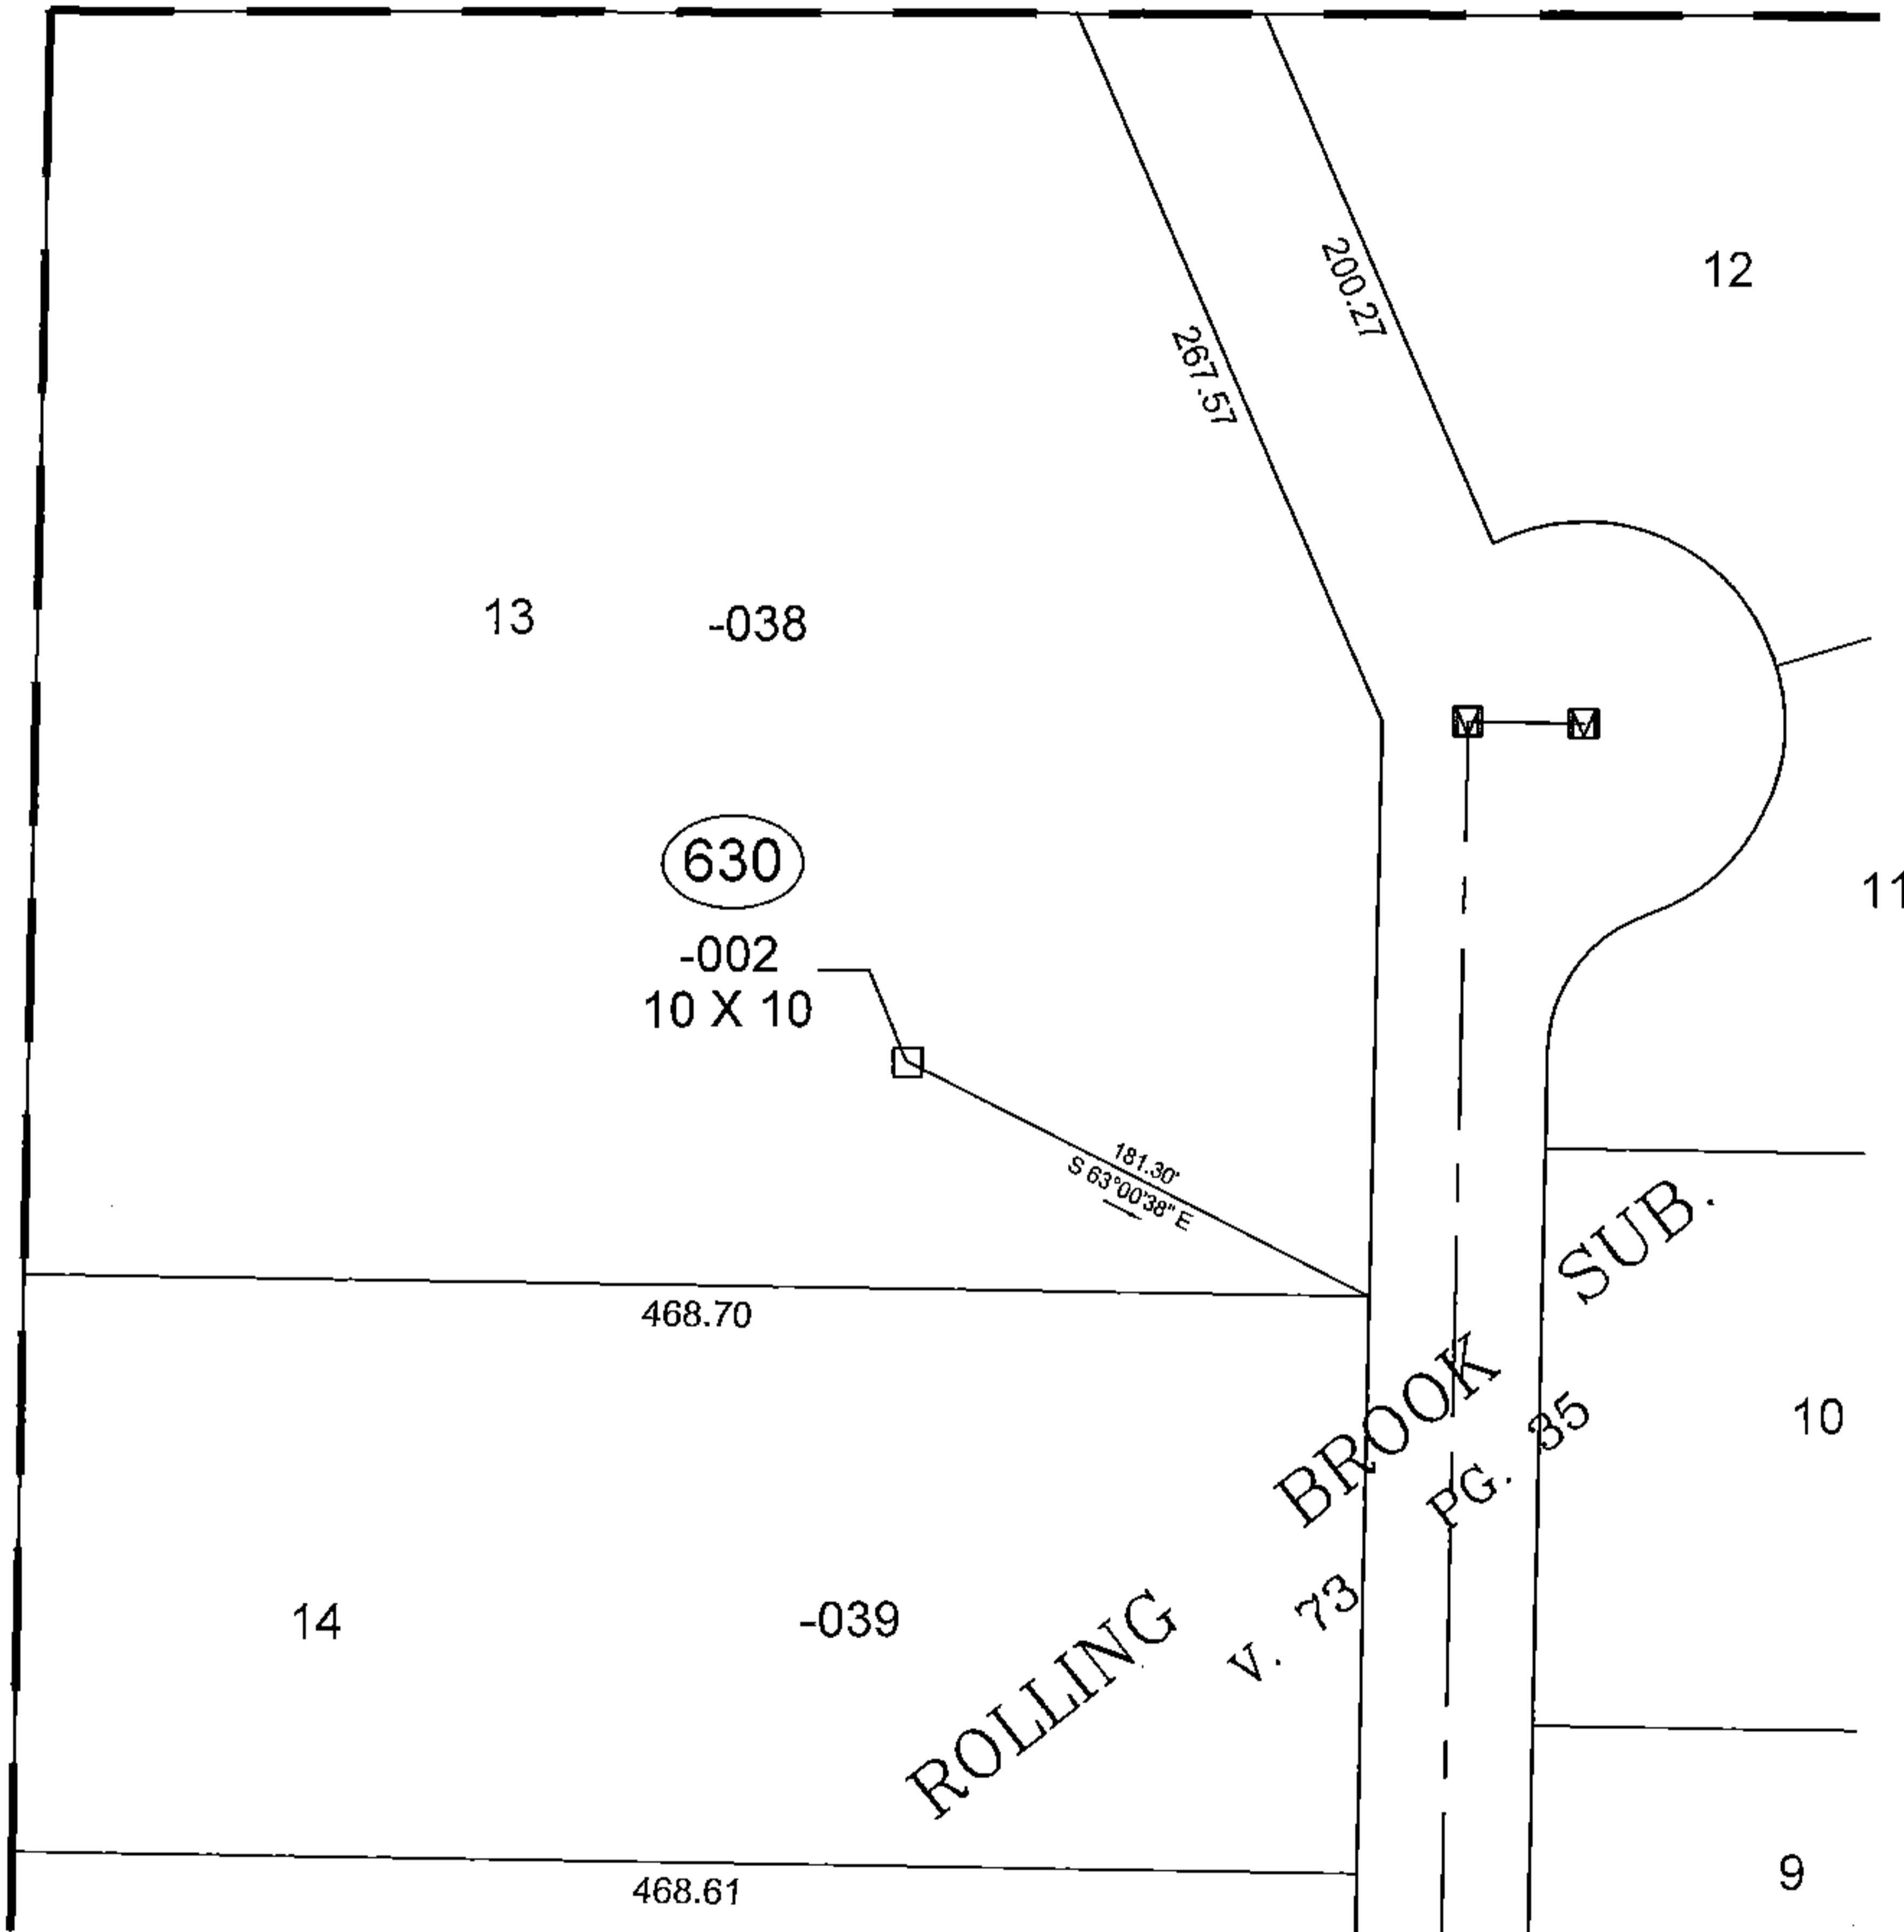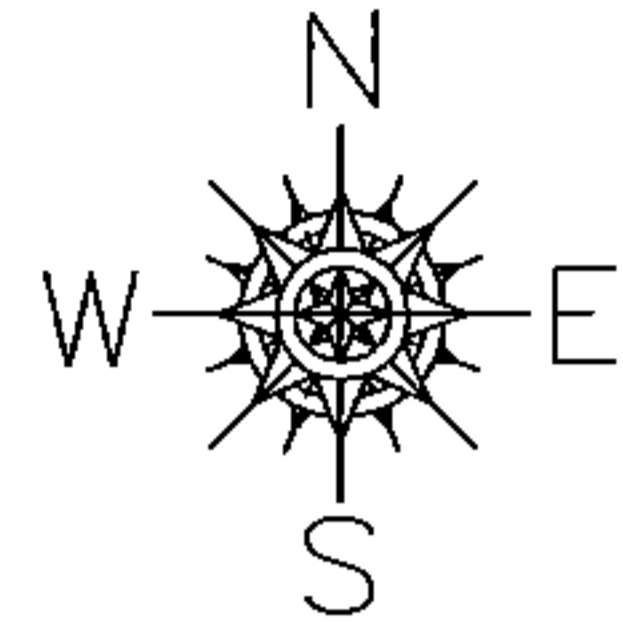

SPLITS/DEEDS PROCESSED
 LORAIN COUNTY TAX MAP DEPARTMENT
 226 MIDDLE AVE. ELYRIA, OHIO

SURVEYED BY: NONE
 CLOSURE: NA
 MAP PAGE(S): 12-00-070-A
 APPROVED BY: TJS DATE: 3/7/14
 SCALE: 1" = 100 PRIOR INSTRUMENT: NA