
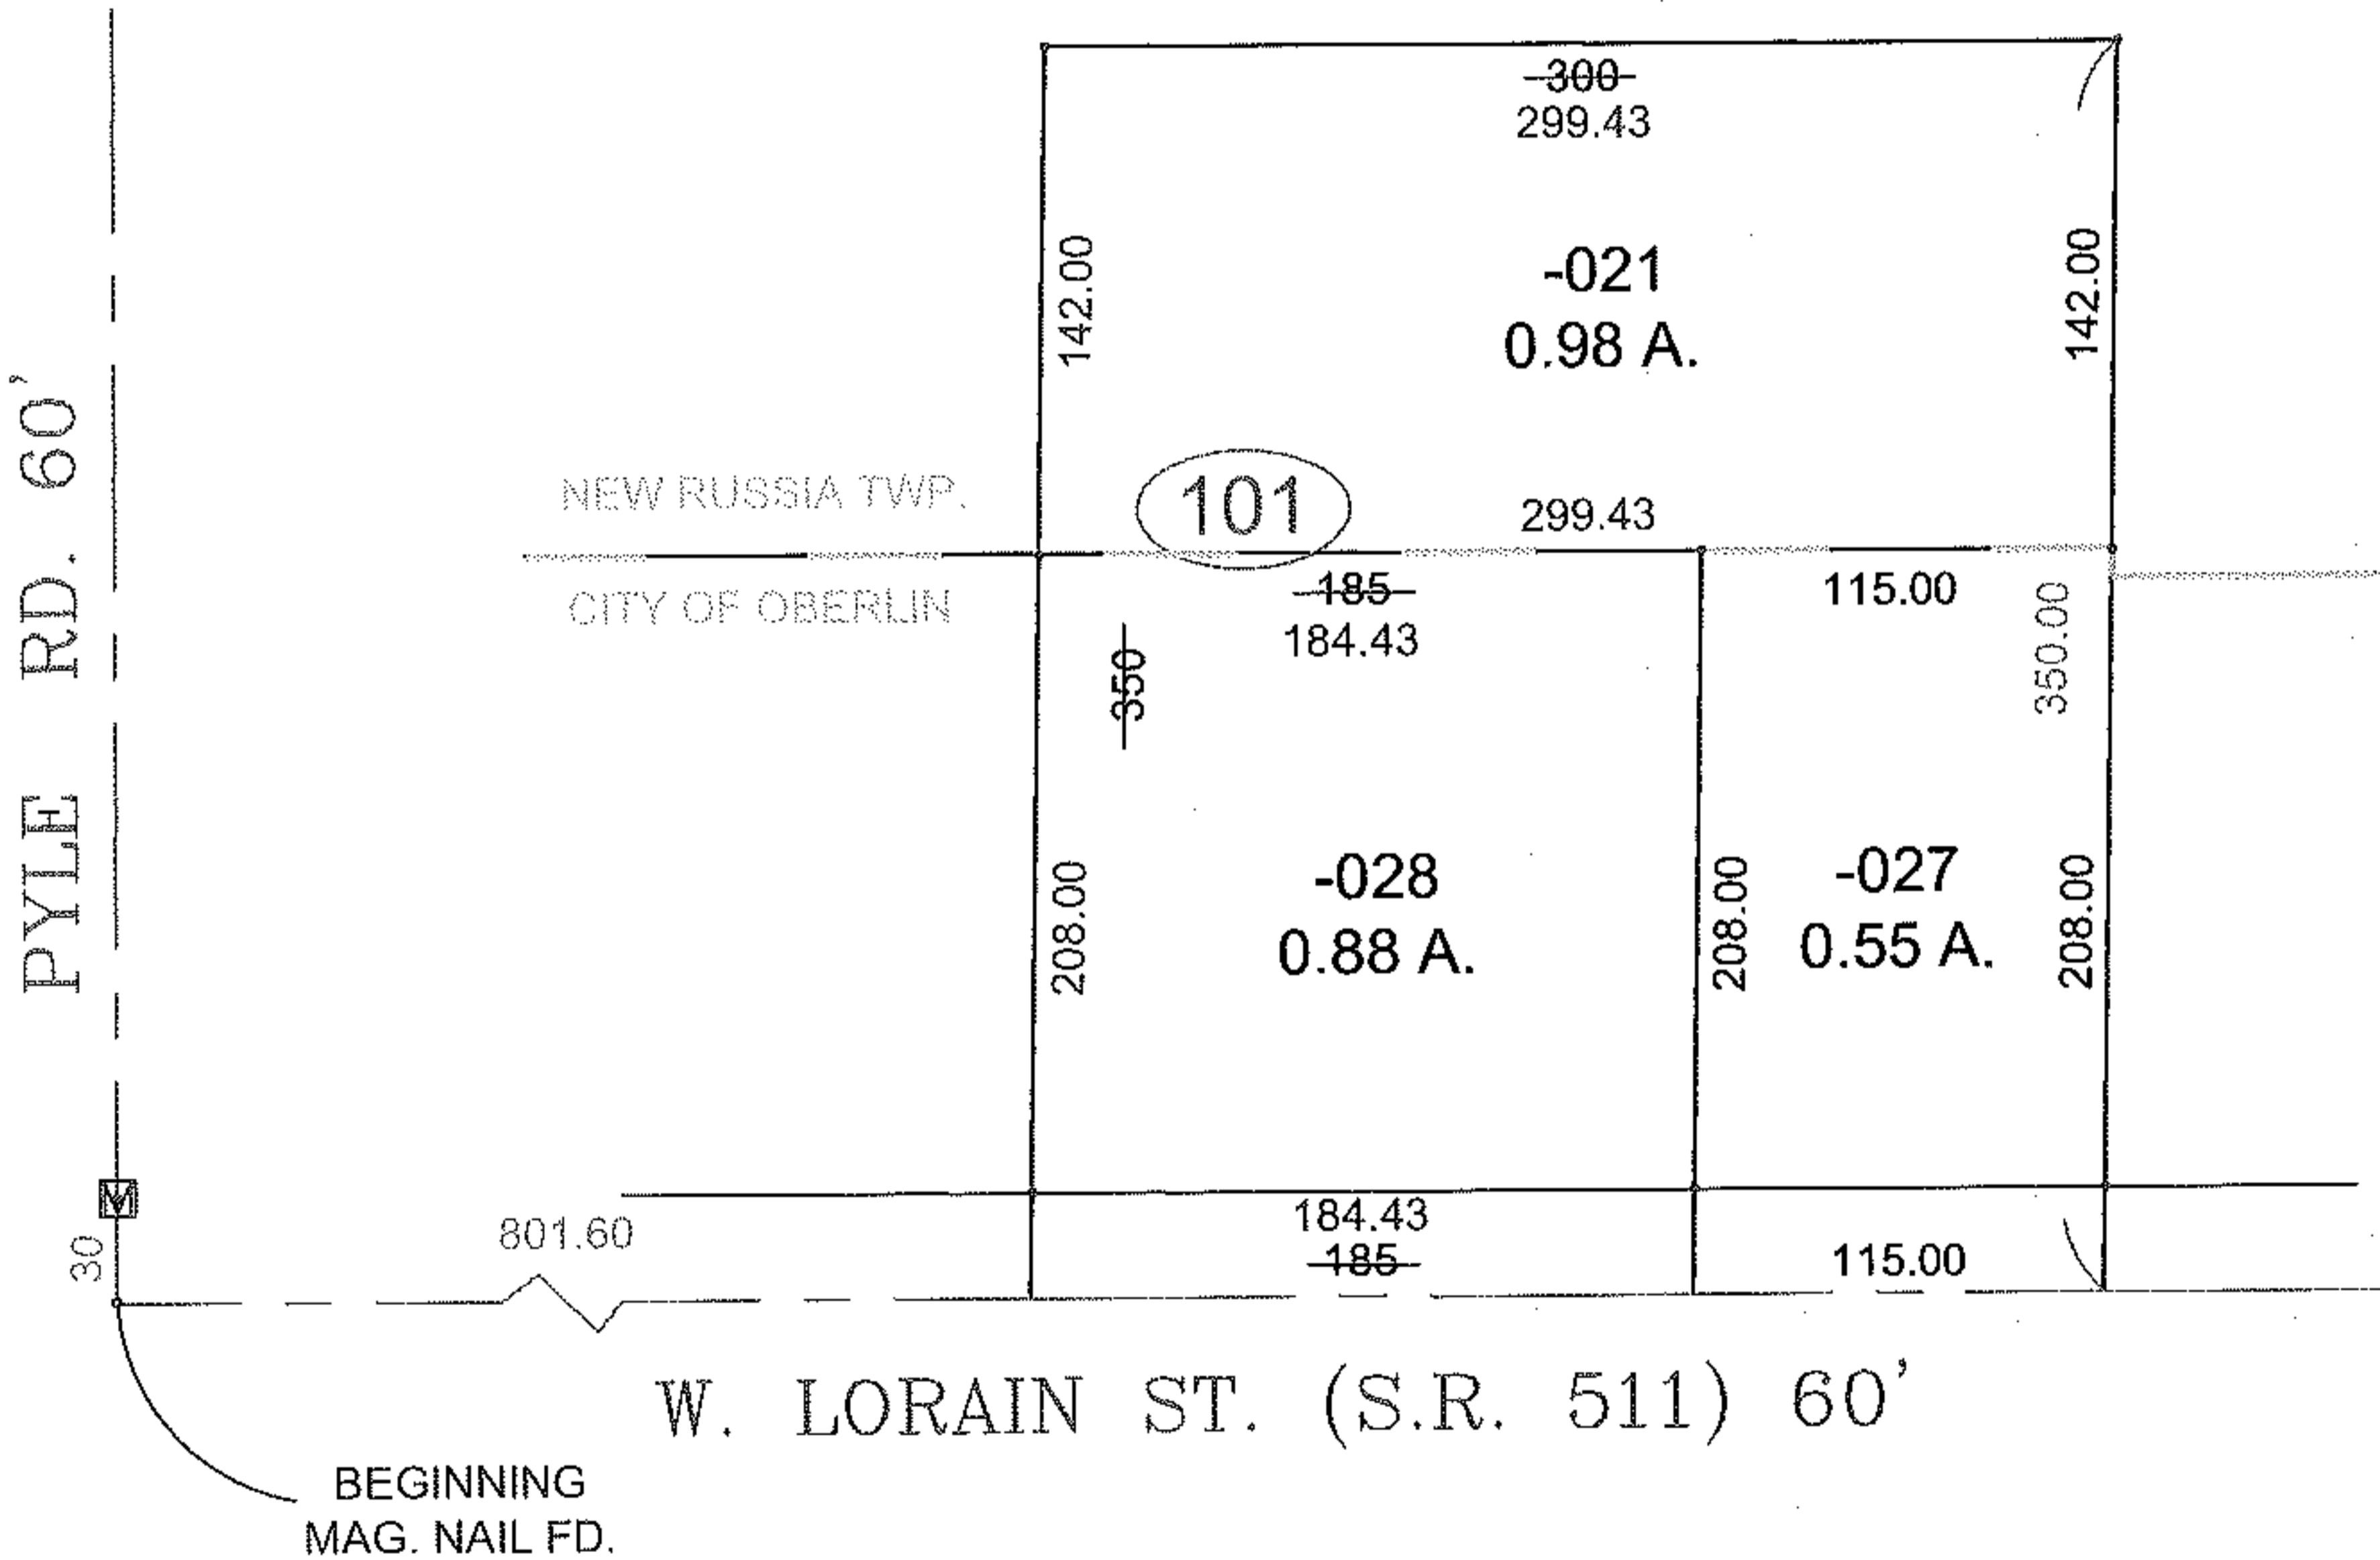


PARENT PARCEL: 09-00-074-101-021, -027, & -028

CHILD PARCEL: XX-XX-XXX-XXX-XXX

STARTING POINT: MAG. NAIL FD., CL OF W. LORAIN ST. & CL OF PYLE RD.

11-02899

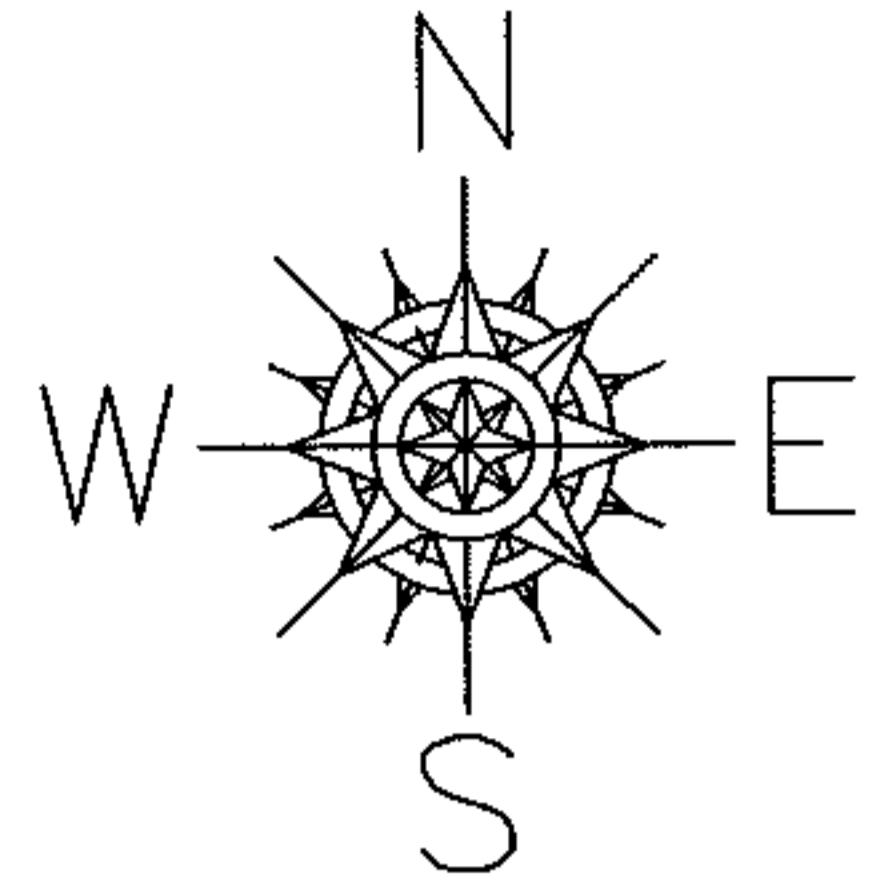

SPLITS/DEEDS PROCESSED

LORAIN COUNTY TAX MAP DEPARTMENT  
226 MIDDLE AVE. ELYRIA, OHIO

SURVEYED BY: THOMAS SIMON

CLOSURE: 0.00 : 10.000

MAP PAGE(S): 9-00-074-A

APPROVED BY: TJS DATE: 2/17/11

SCALE: 1"= 100 PRIOR INST.: 20090288292