
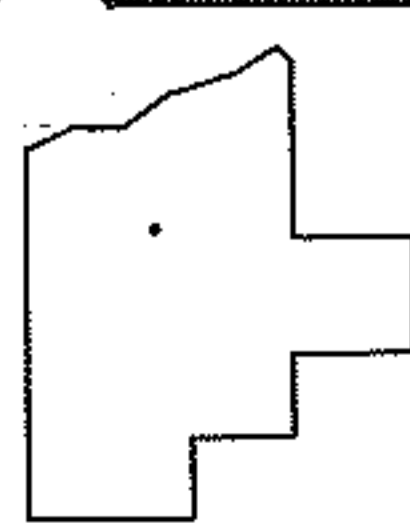


PARENT PARCEL: 09-00-049-000-003, 09-00-050-000-001, 09-00-059-000-002, -014
CHILD PARCEL: 09-00-049-000-003, 09-00-050-000-001, 09-00-059-000-019
STARTING POINT: CENTERLINE OF BUTTERNUT RIDGE RD

11-02900

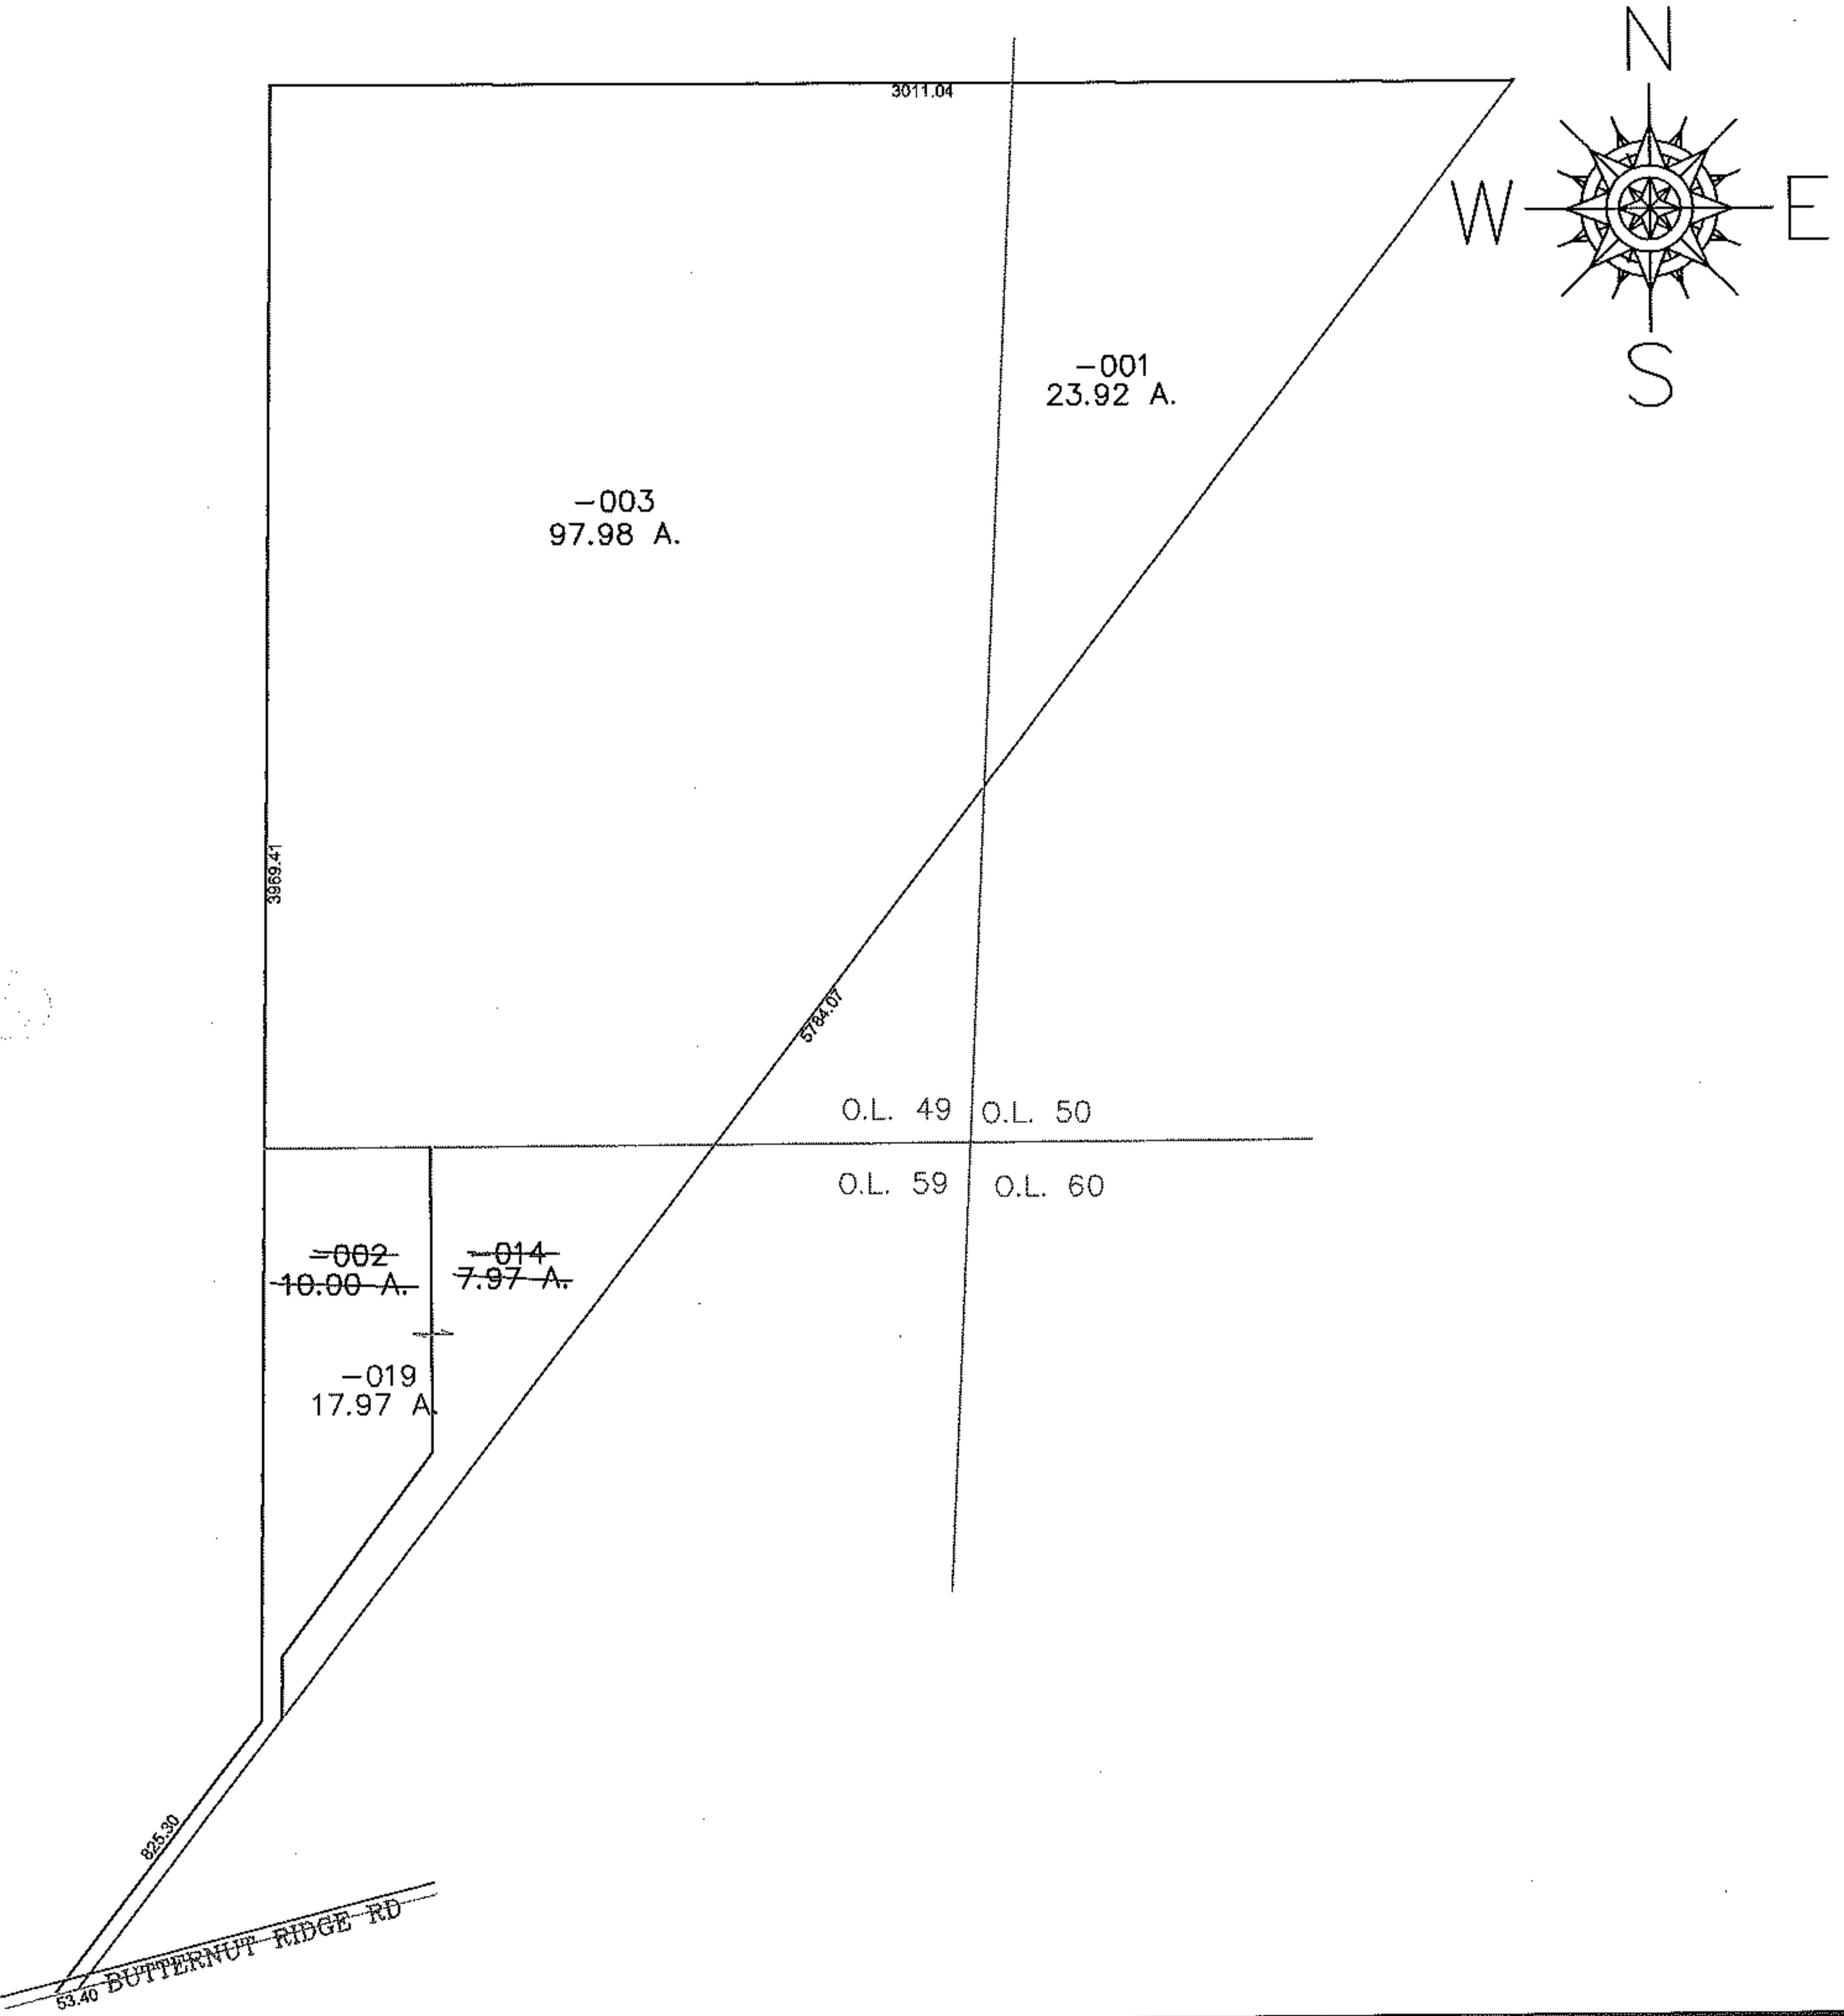

SPLITS/DEEDS PROCESSED

LORAIN COUNTY TAX MAP DEPARTMENT
226 MIDDLE AVE. ELYRIA, OHIO

SURVEYED BY: JAMES H SCHMIDT 1968
CLOSURE: 0.06 : 10.000
MAP PAGE(S): 9-B, 9-H
APPROVED BY: JAH DATE: 2/17/2011
SCALE: 1" = 600 PRIOR INSTRUMENT: 20050105508