


PARENT PARCEL: 06-25-003-101-028

CHILD PARCEL: 06-25-003-900-002

STARTING POINT: XXXXXX

14-02901-C

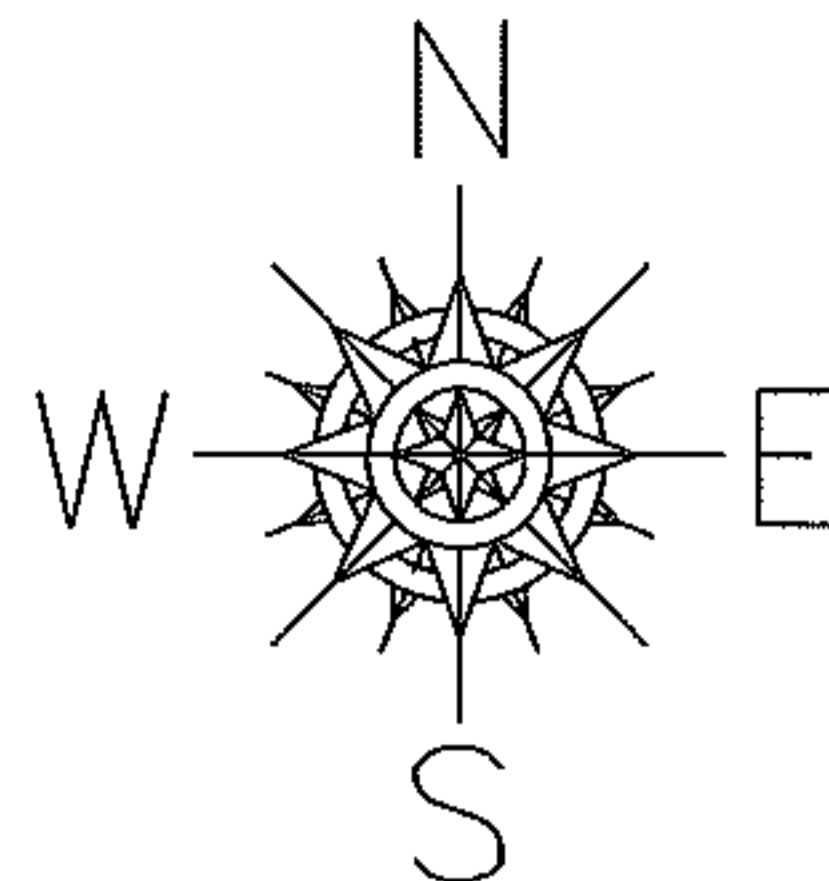

NAME CORRECTION

~~BLACK RIVER DEV. CO. & UNI. CIR. LAND CO.~~

CITY OF ELYRIA

STREET WAS DEDICATED TO PUBLIC USE

UNIVERSITY HEIGHTS SUB. NO. 1

P.V. 22 PG. 16 & 17

PARCEL NUMBER & AC. CORR.


~~06-25-003-101-028~~

~~1.61 A.~~

06-25-003-900-002

6.37 A.

AC. CORR. PER PLAT

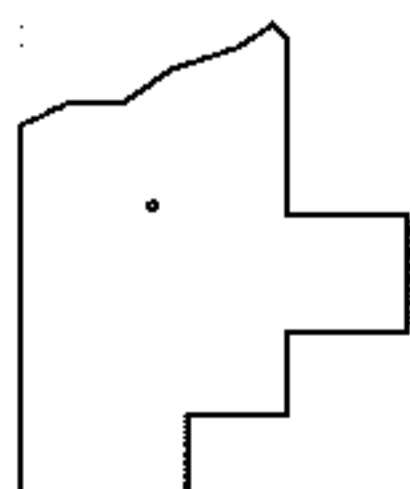

SPLITS/DEEDS PROCESSED

LORAIN COUNTY TAX MAP DEPARTMENT
226 MIDDLE AVE. ELYRIA, OHIO

SURVEYED BY: LAUNDON & HUFFMAN

CLOSURE: XXXXXX

MAP PAGE(S): 06-25-003

APPROVED BY: TJS DATE: 3/28/14

SCALE: 1"= 100 PRIOR INST.: PV. 22 PG. 16