


PARENT PARCEL: 12-00-087-000-023


CHILD PARCEL: 12-00-087-000-024, -025

STARTING POINT: CENTERLINE OF CAPEL RD & STATION RD

11-02901

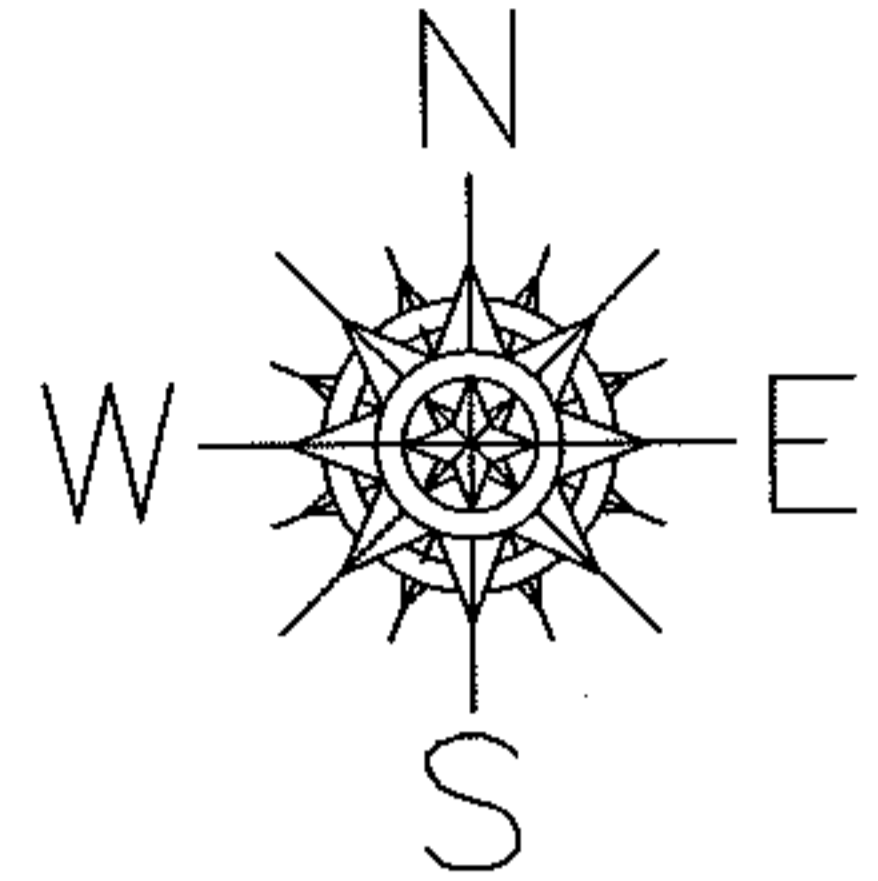

~~-023~~
~~29.90 A.~~
-025
27.76 A.

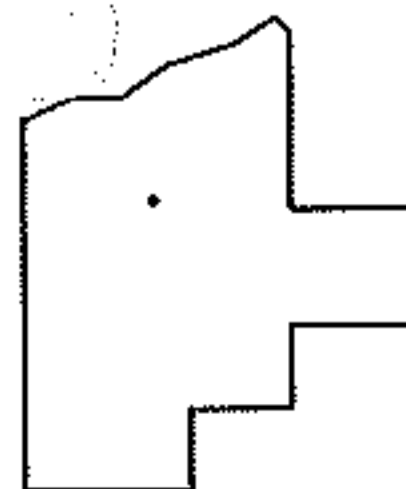

SPLITS/DEEDS PROCESSED

LORAIN COUNTY TAX MAP DEPARTMENT
226 MIDDLE AVE. ELYRIA, OHIO

SURVEYED BY: RICHARD FREDRICKSON

CLOSURE: 0.00 : 10.000

MAP PAGE(S): 12-E

APPROVED BY: JAH DATE: 2-24-2011

SCALE: 1" = 100 PRIOR INSTRUMENT: OR 75/582