
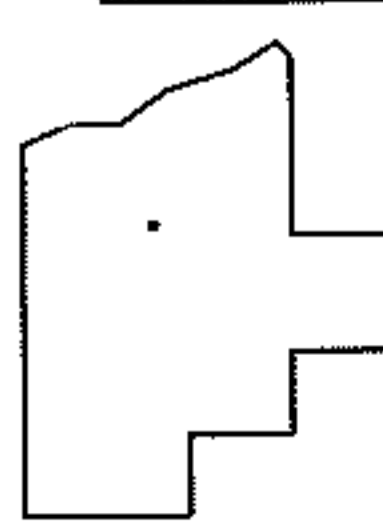
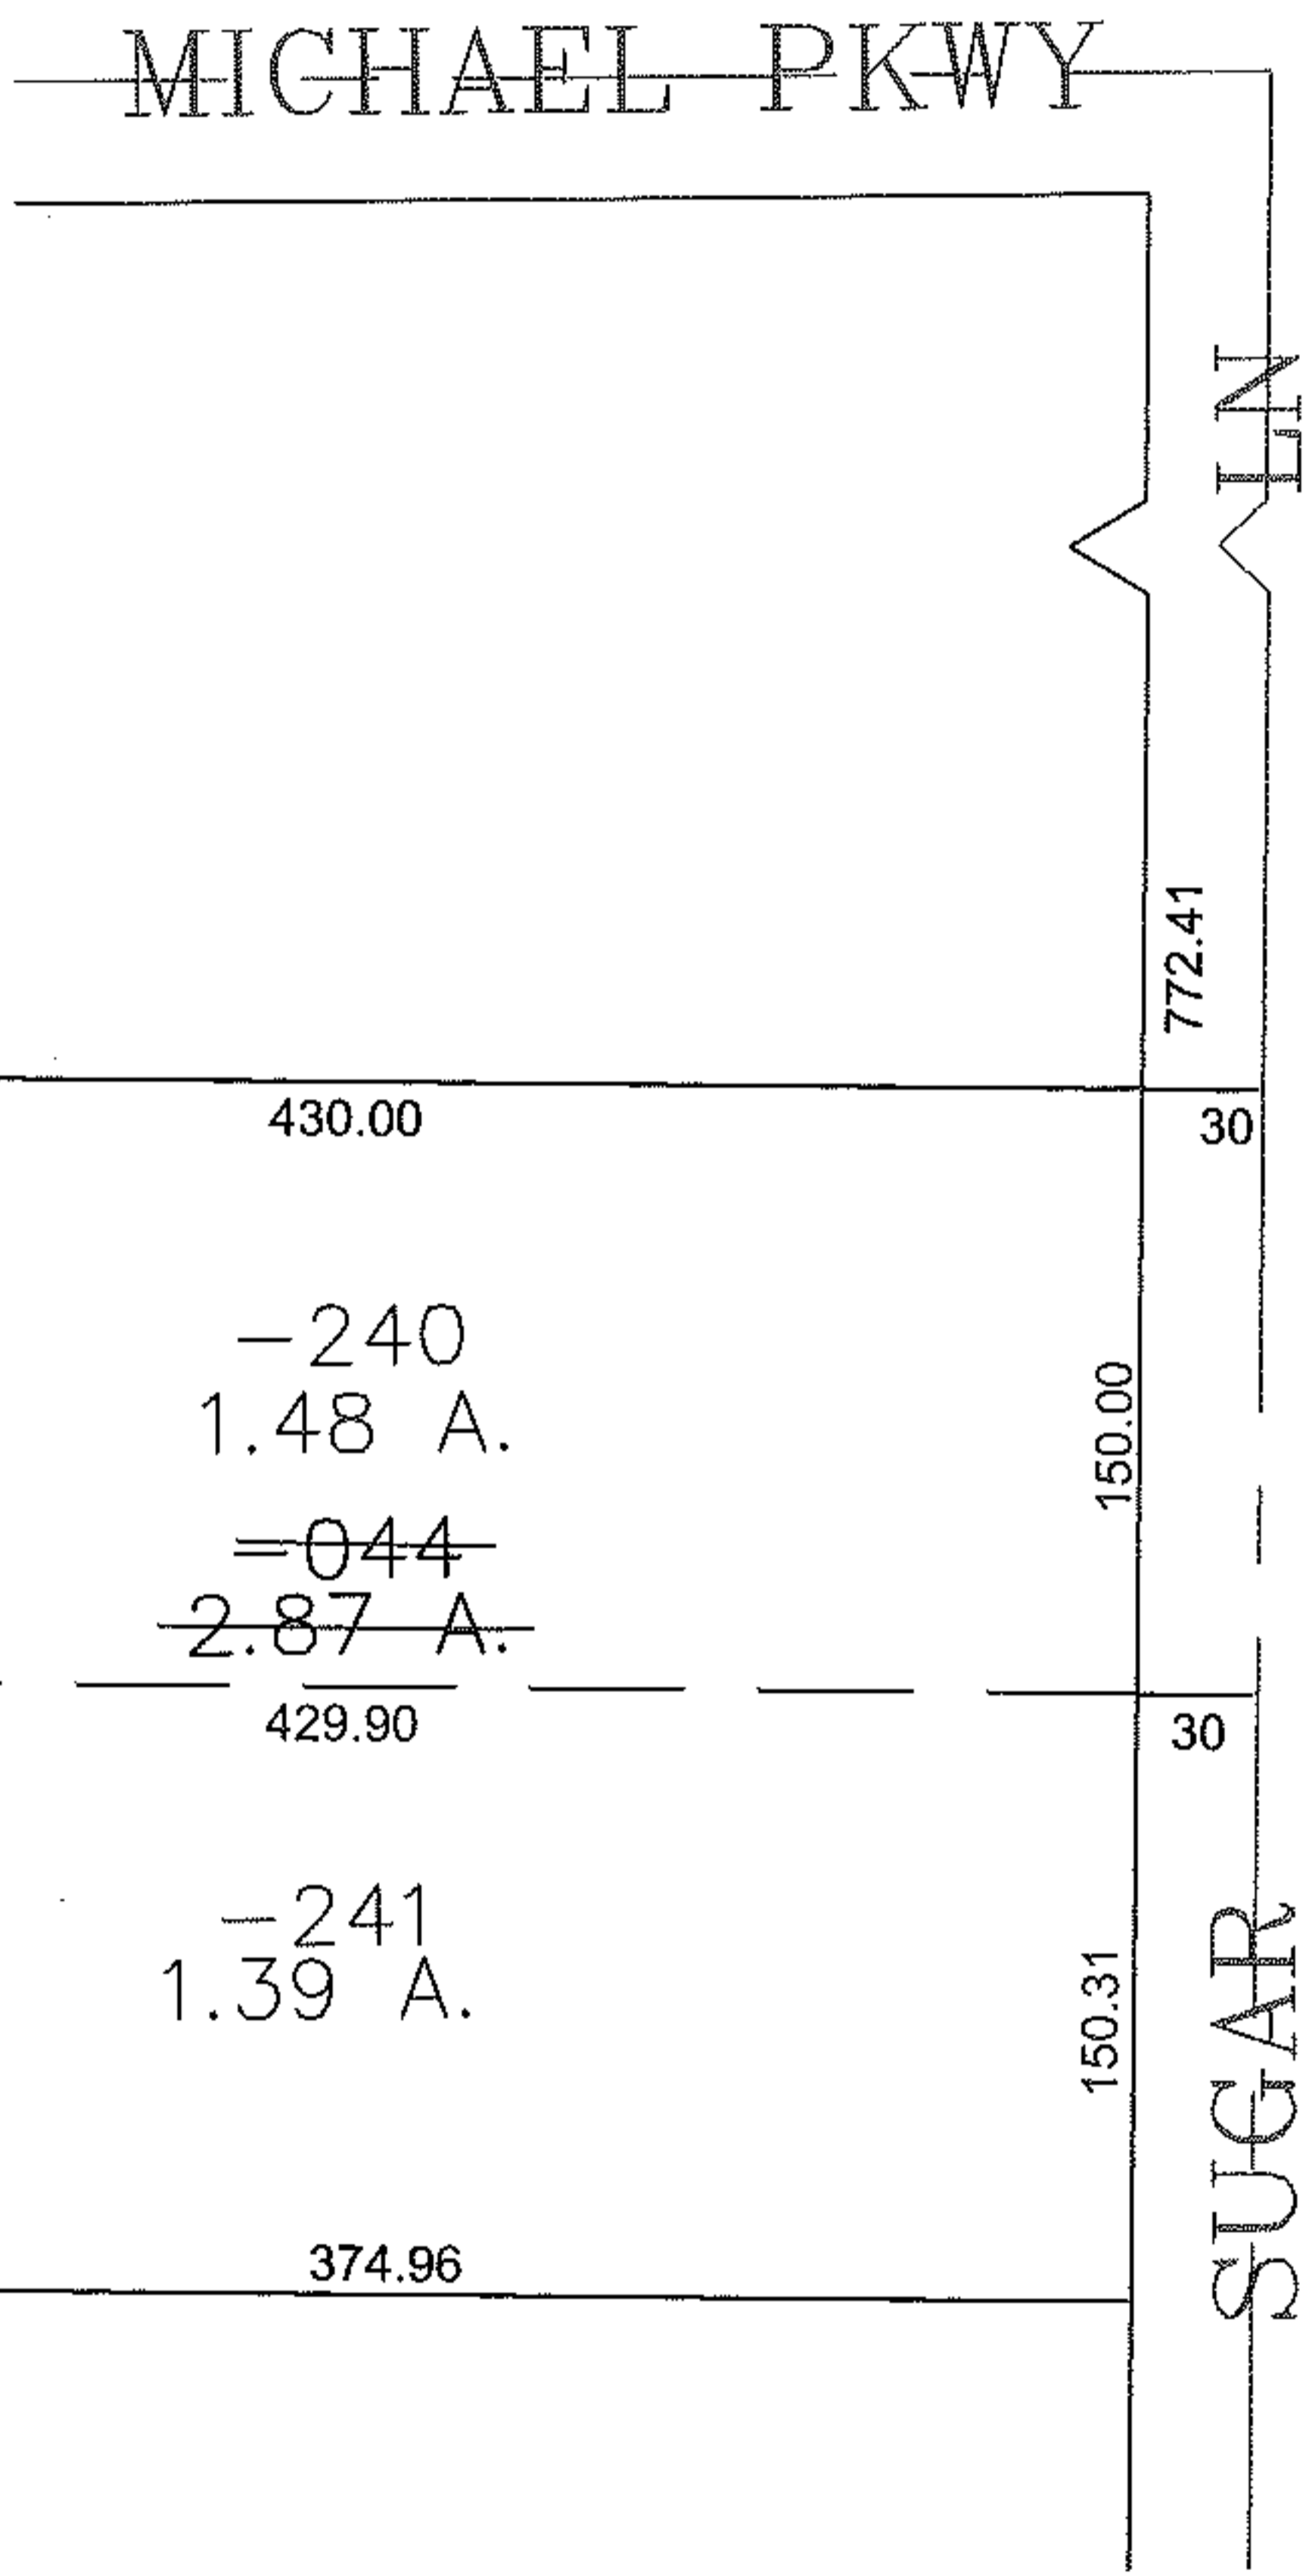


PARENT PARCEL: 06-25-001-000-044

CHILD PARCEL: 06-25-001-000-240, -241

STARTING POINT: CENTERLINE OF MICHAEL PKWY & SUGAR LN

11-02902

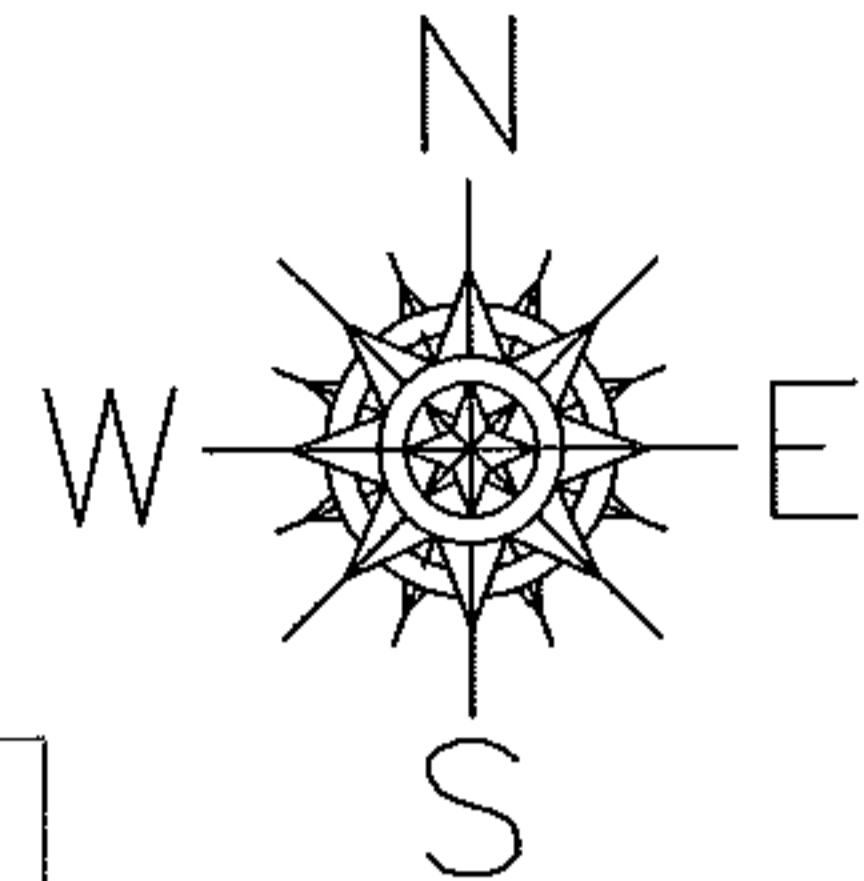

SPLITS/DEEDS PROCESSED

LORAIN COUNTY TAX MAP DEPARTMENT  
226 MIDDLE AVE. ELYRIA, OHIO

SURVEYED BY: THOMAS SIMON  
CLOSURE: 0.00 : 10.000  
MAP PAGE(S): 6-144  
APPROVED BY: JAH DATE: 3-2-2011  
SCALE: 1" = 100' PRIOR INSTRUMENT: 19910124750