
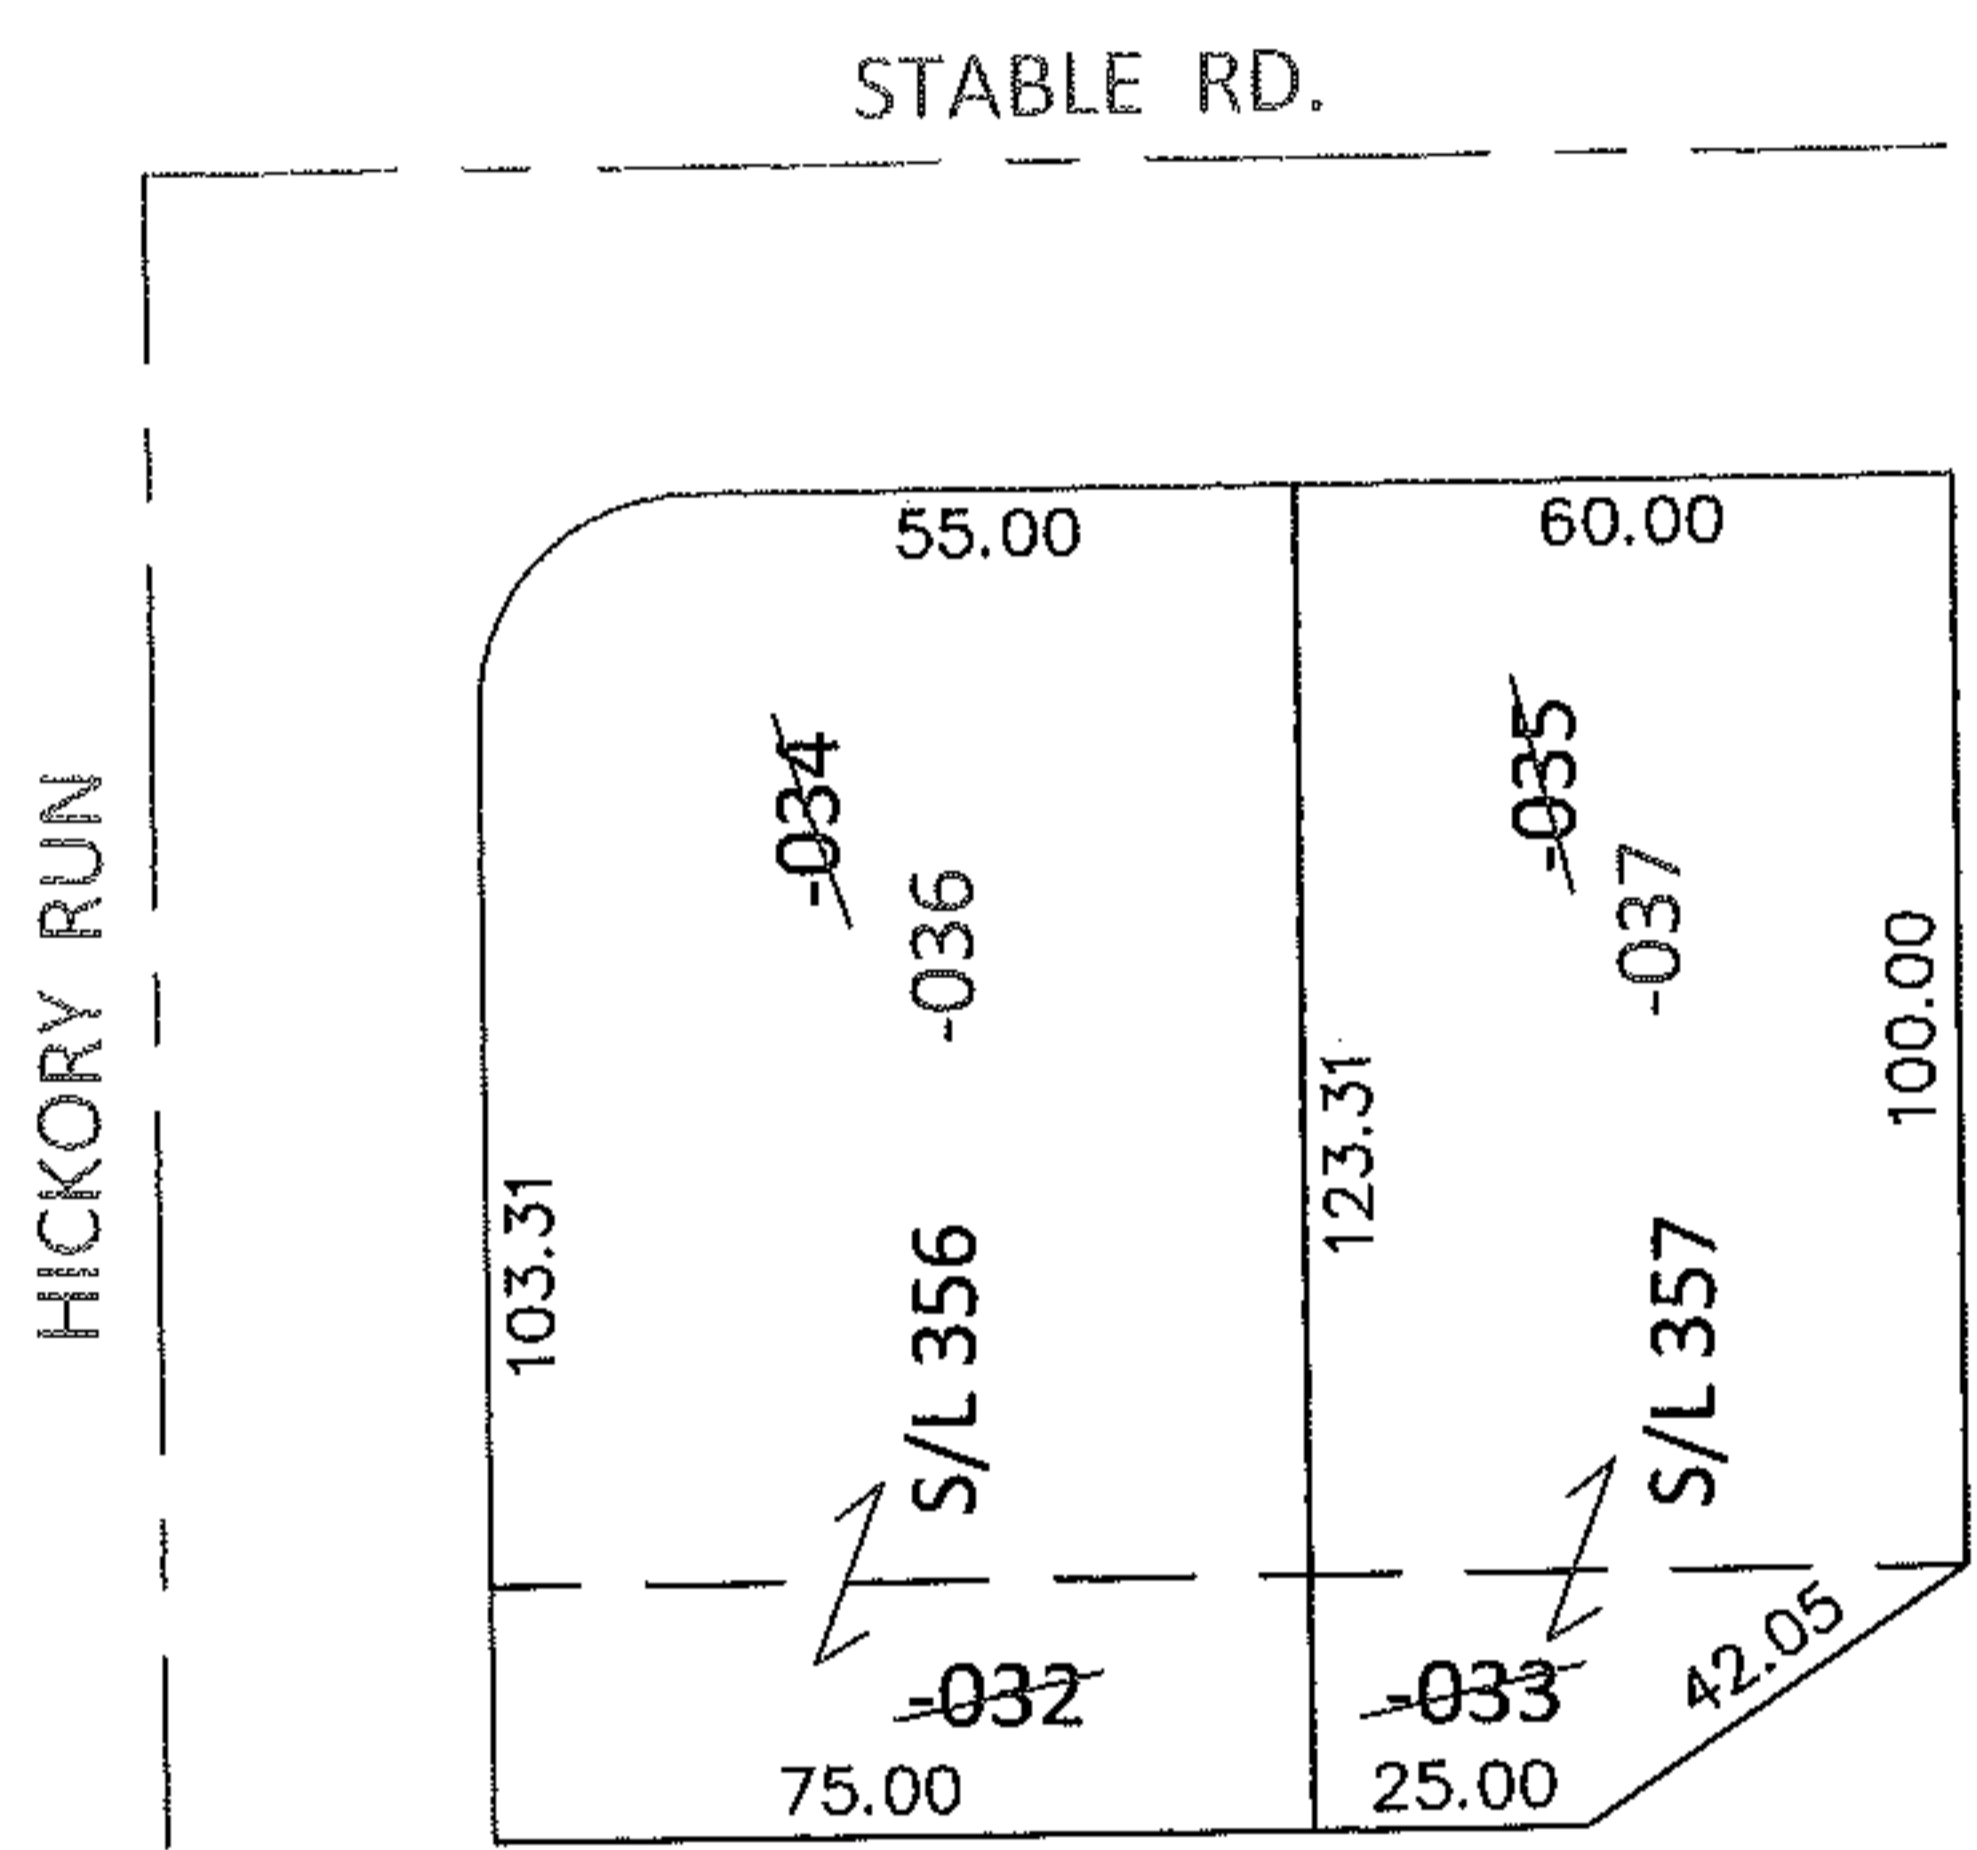



PARENT PARCEL: 15-00-098-107-032 THRU -035
 CHILD PARCEL: 15-00-098-107-036, -037
 STARTING POINT: S/L'S 356 & 357 IN PHEASANT RUN VILLAGE PHASE 1 (VOL.27 PG.16)

14-02903-C

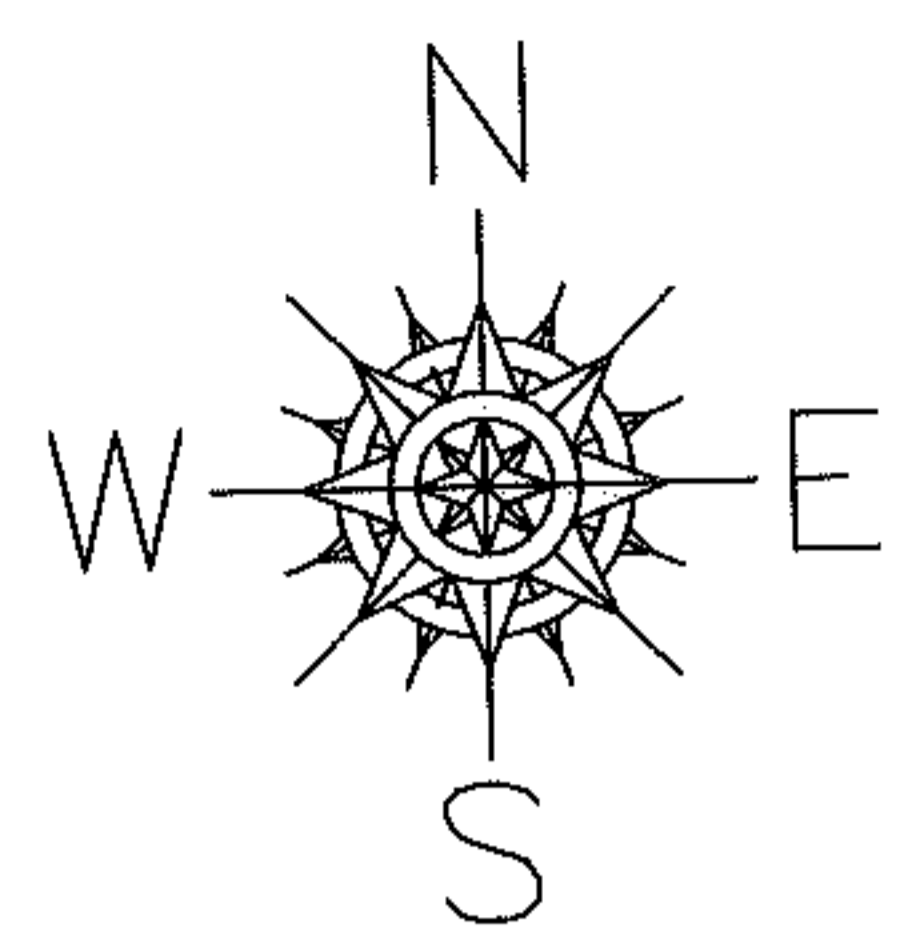

COMBINATION CORRECTION

15-00-098-107-032	15-00-098-107-033	15-00-098-107-034	15-00-098-107-035
23.31 X 75	23.31 X 60	75 X 100	60 X 100
15-00-098-107-036	15-00-098-107-037		
75 X 123.31	60 X 123.31		

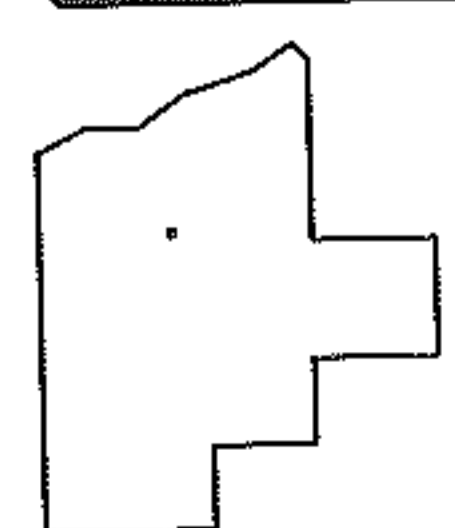

SPLITS/DEEDS PROCESSED
 LORAIN COUNTY TAX MAP DEPARTMENT
 226 MIDDLE AVE. ELYRIA, OHIO

SURVEYED BY: N/A
 CLOSURE: N/A
 MAP PAGE(S): 15-00-098-A
 APPROVED BY: RRM DATE: 3-17-14
 SCALE: 1"=50' PRIOR INST.: 20140492016