



RASTER

PARENT PARCEL: 07-00-035-101-008, -041

CHILD PARCEL: 07-00-035-101-067 THRU -069

STARTING POINT: CENTERLINE OF RACE RD & SUGAR RIDGE RD

11-02905

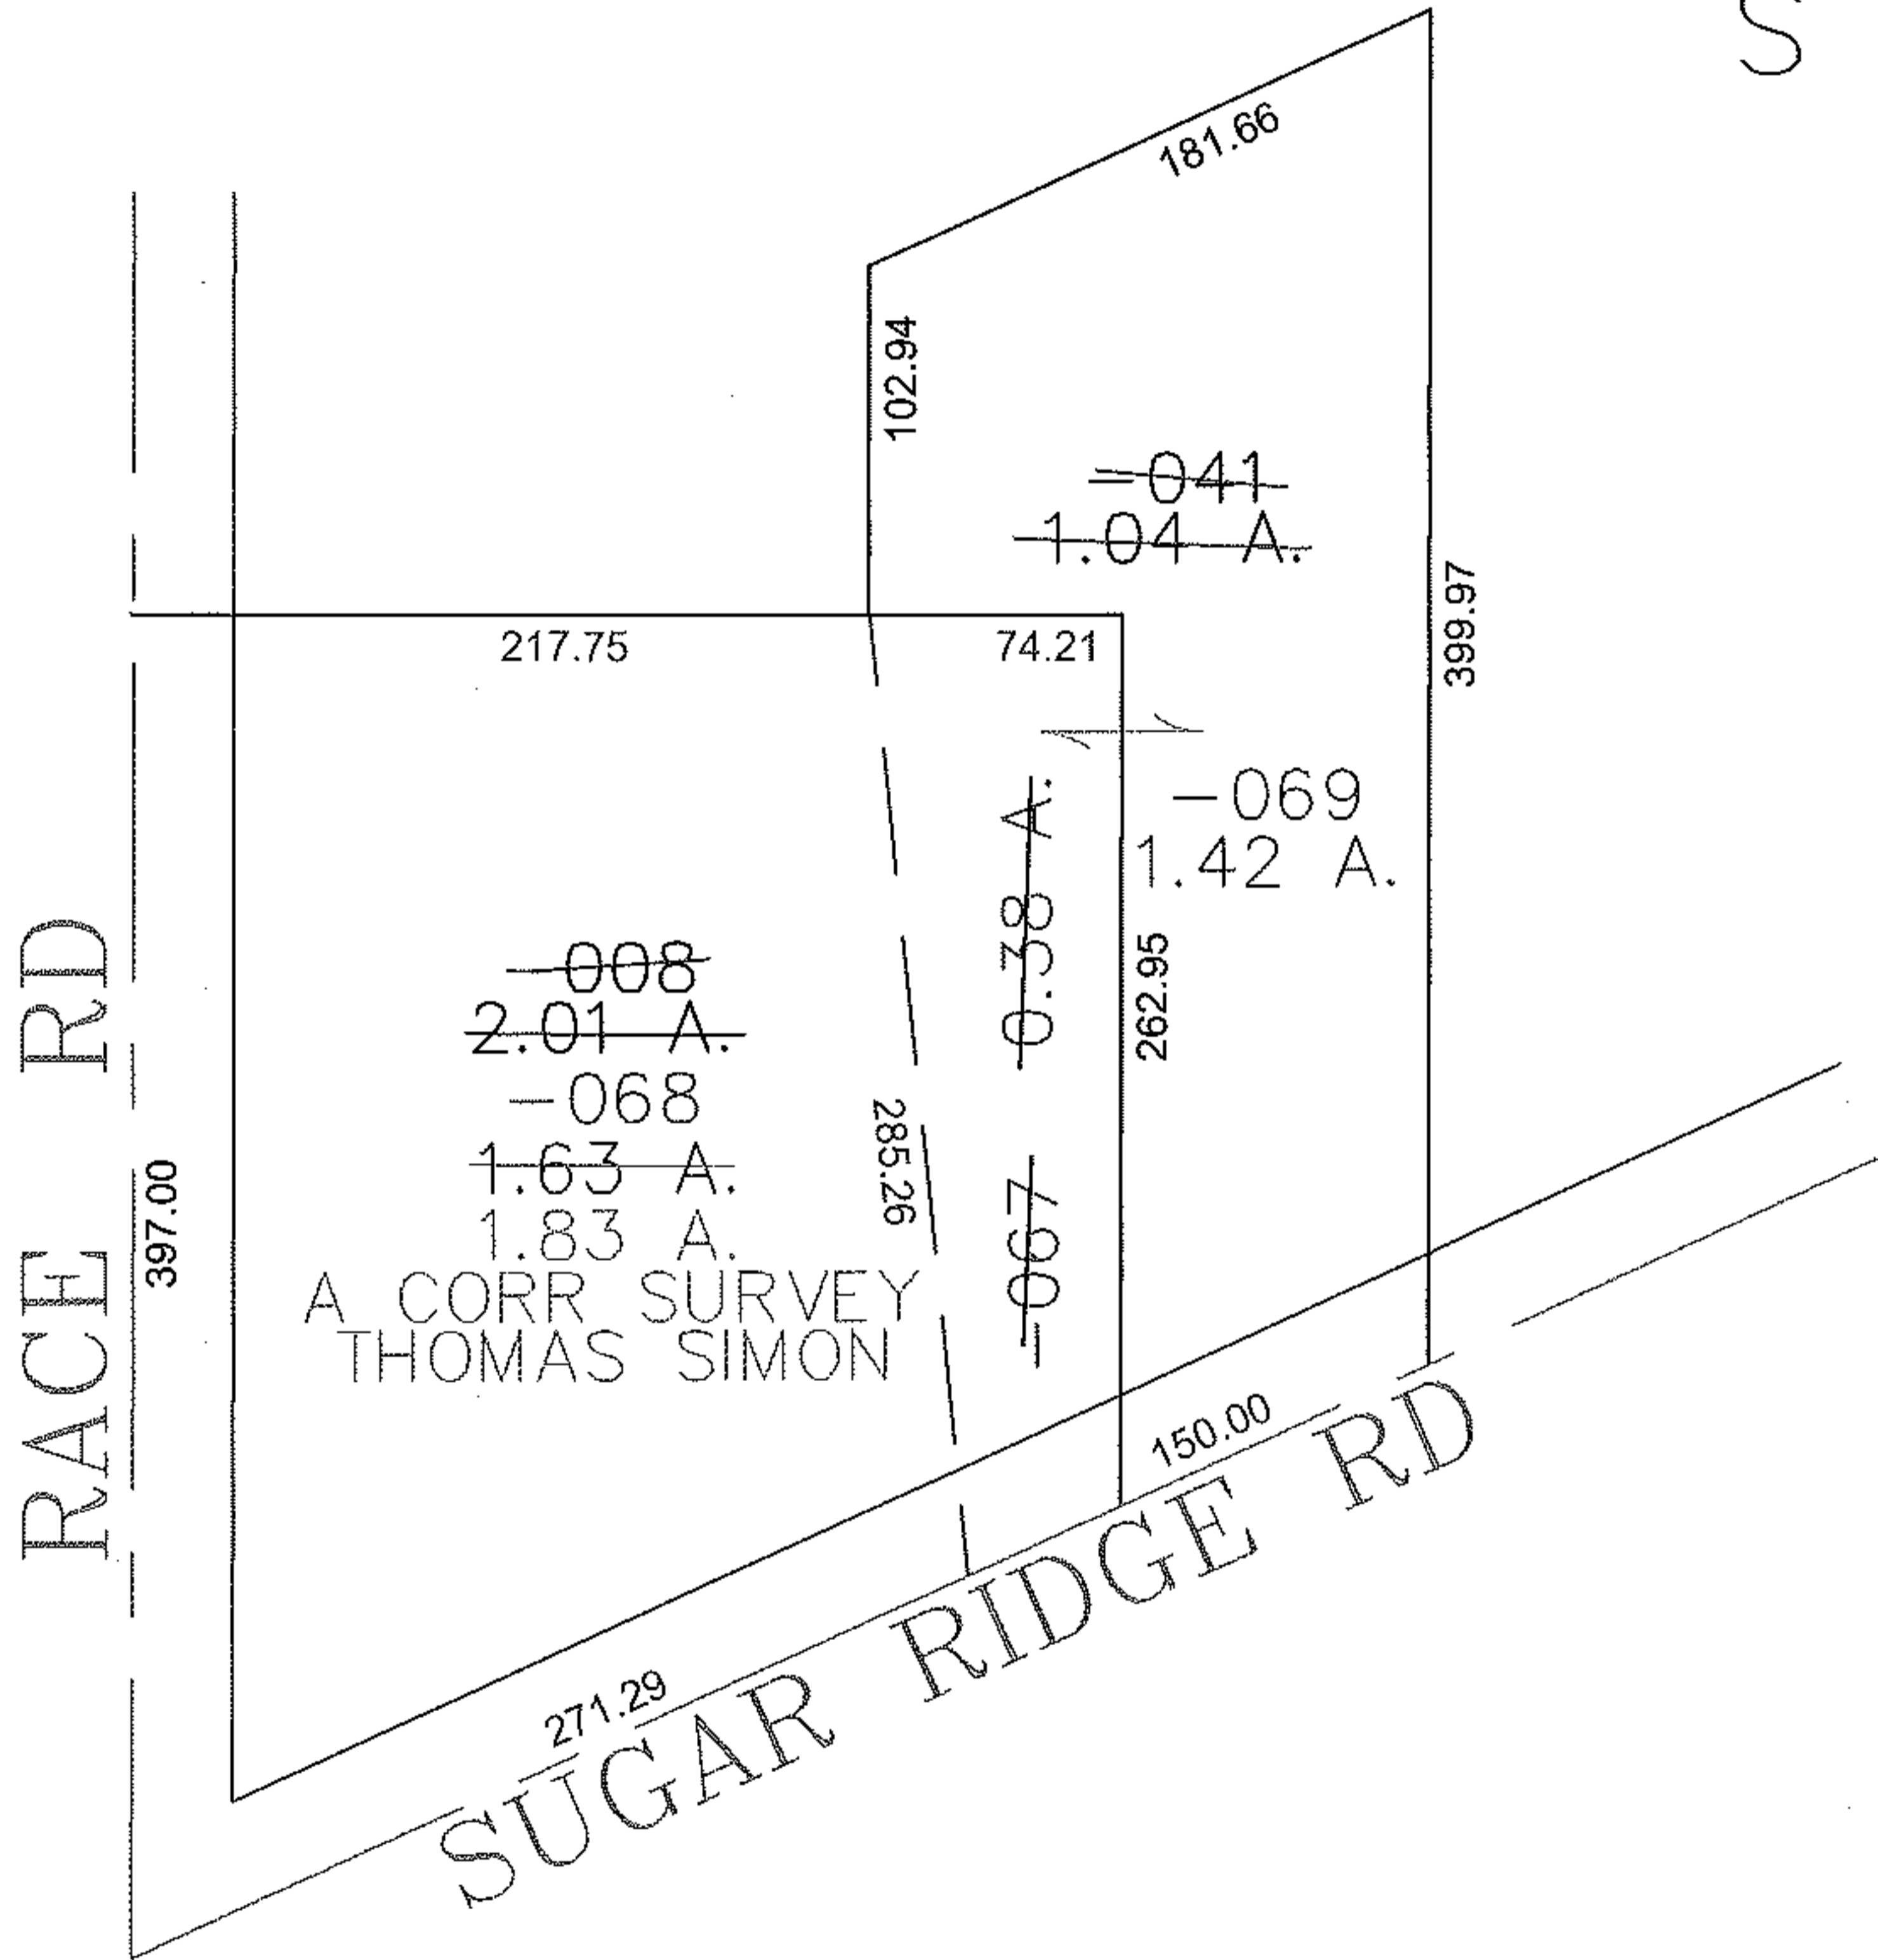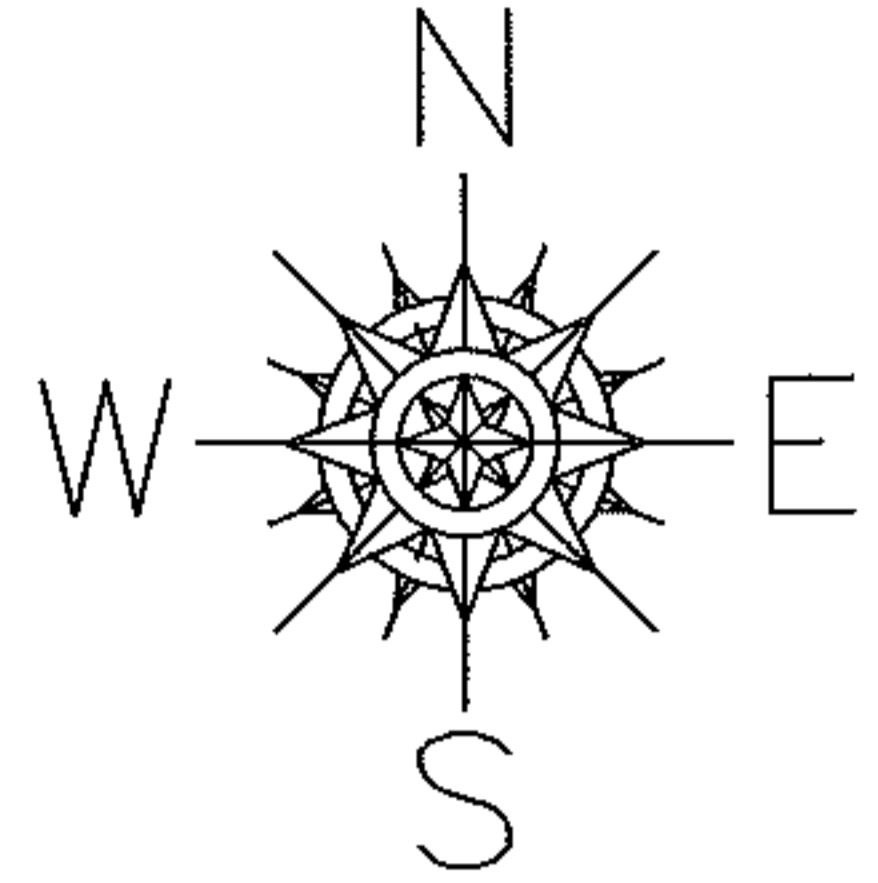

SPLITS/DEEDS PROCESSED

LORAIN COUNTY TAX MAP DEPARTMENT
226 MIDDLE AVE. ELYRIA, OHIO

SURVEYED BY: THOMAS SIMON
 CLOSURE: 0.00 : 10.000
 MAP PAGE(S): 07-00-035-A
 APPROVED BY: JAH DATE: 3-18-2011
 SCALE: 1" = 100 PRIOR INSTRUMENT: 20110361306