


PARENT PARCEL: 05-00-042-104-056, -063, -068

CHILD PARCEL: 05-00-042-104-096



STARTING POINT: CENTERLINE OF OBERLIN NORTH RD & NORTH RIDGE RD

11-02907

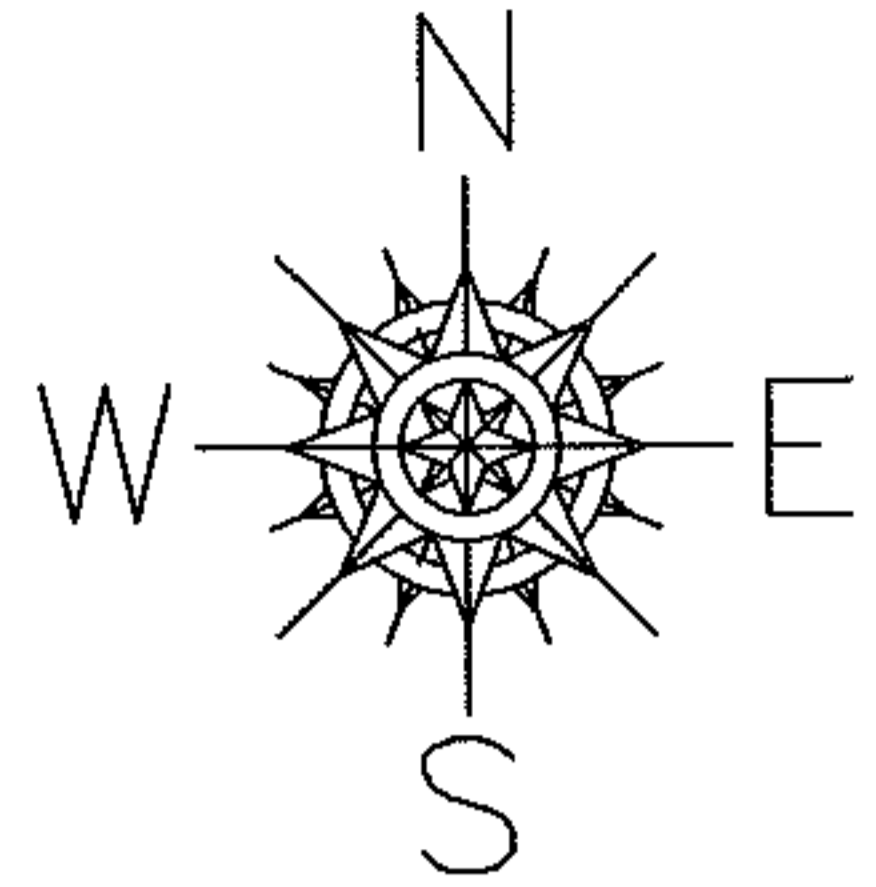

OBERLIN NORTH RD

NORTH RIDGE RD

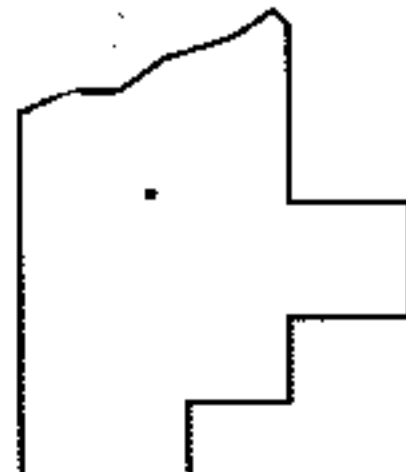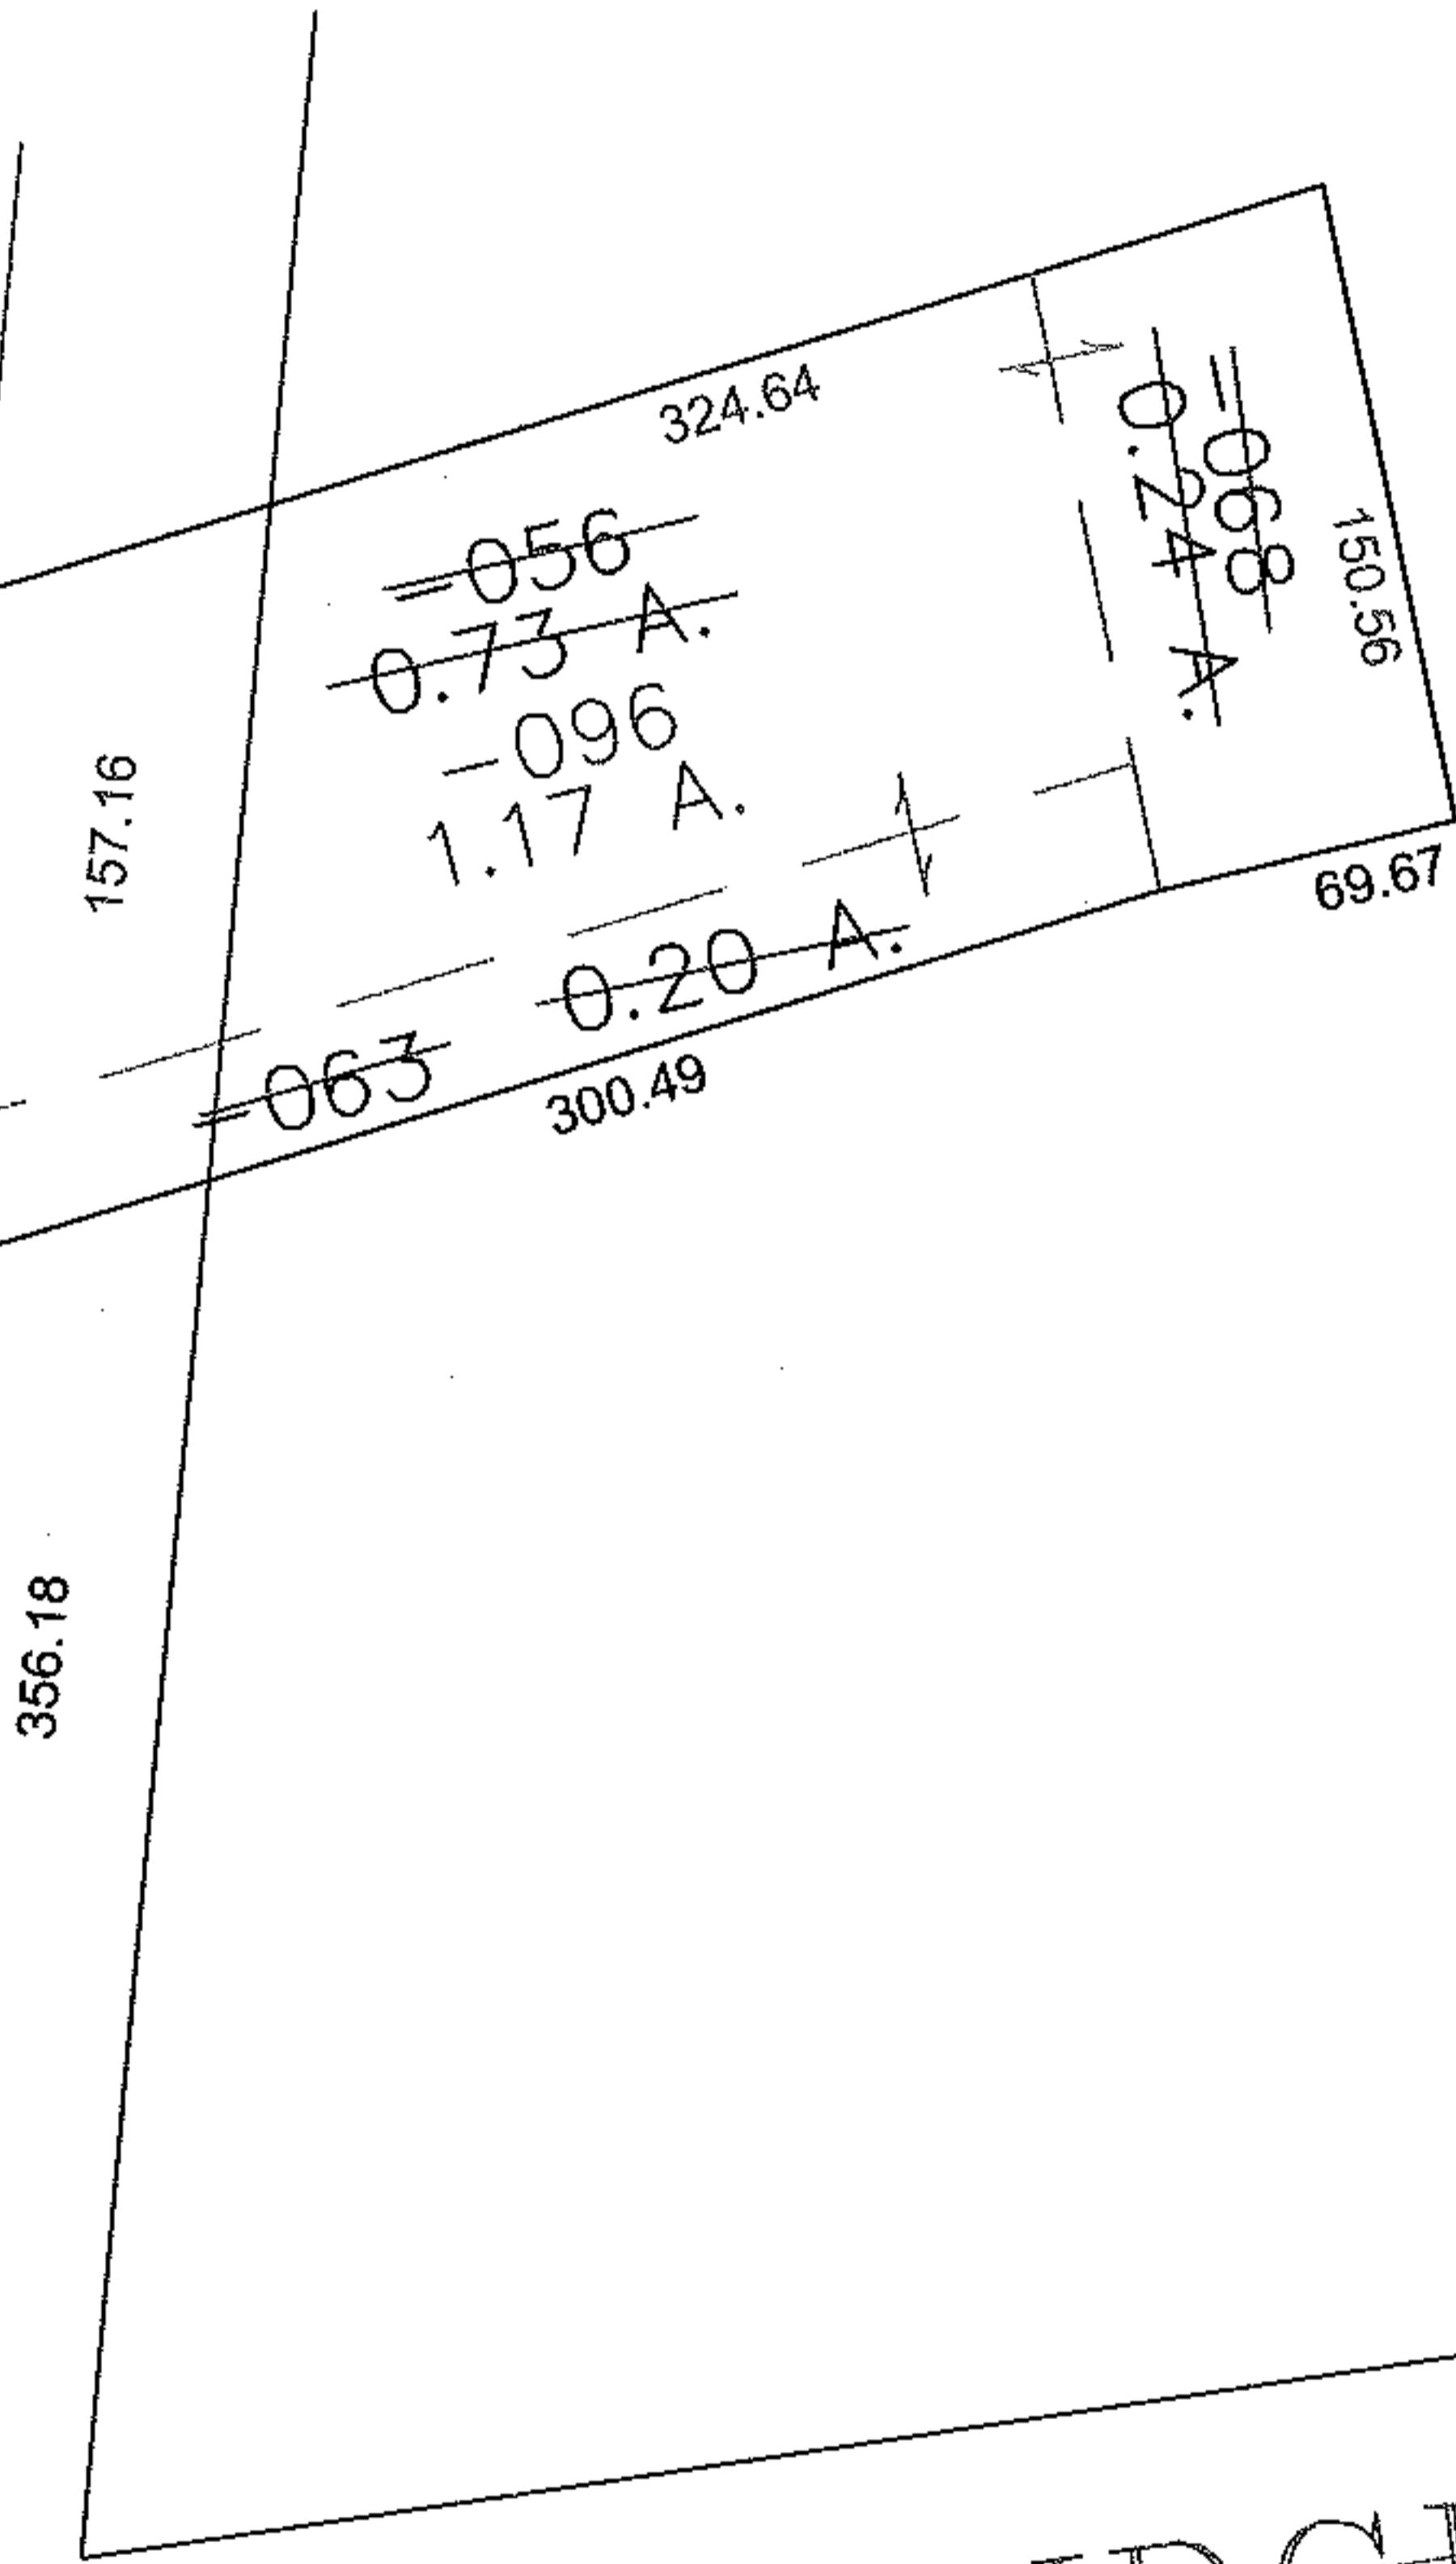

SPLITS/DEEDS PROCESSED

LORAIN COUNTY TAX MAP DEPARTMENT
226 MIDDLE AVE. ELYRIA, OHIO

SURVEYED BY: THOMAS J NEFF JR

CLOSURE: 0.00 : 10.000

MAP PAGE(S): 05-00-042-A

APPROVED BY: JAH DATE: 3-30-2011

SCALE: 1" = 100 PRIOR INSTRUMENT: 20050053647