

PARENT PARCEL: 06-26-008-103-001 THRU -014

CHILD PARCEL: XX-XX-XXX-XXX-XXX


STARTING POINT: XXXXXX

14-02908-C


DEPTH CORRECTIONS

PER PV. 2 PG. 19

06-26-008-103-001 43.02 X 96.57 43.02 X 97.02	06-26-008-103-005 31.02 X 96.57 31.02 X 97.02	06-26-008-103-009 32.02 X 96.57 32.02 X 97.02	06-26-008-103-013 42.02 X 96.57 42.02 X 97.02
06-26-008-103-002 85.02 X 96.57 85.02 X 97.02	06-26-008-103-006 9.52 X 96.57 9.52 X 97.02	06-26-008-103-010 32.02 X 96.57 32.02 X 97.02	06-26-008-103-014 43.00 X 96.57 43.00 X 97.02
06-26-008-103-003 64.02 X 96.57 64.02 X 97.02	06-26-008-103-007 31.00 X 96.57 31.00 X 97.02	06-26-008-103-011 64.02 X 96.57 64.02 X 97.02	
06-26-008-103-004 33.00 X 96.57 33.00 X 97.02	06-26-008-103-008 23.50 X 96.57 23.50 X 97.02	06-26-008-103-012 64.02 X 96.57 64.02 X 97.02	

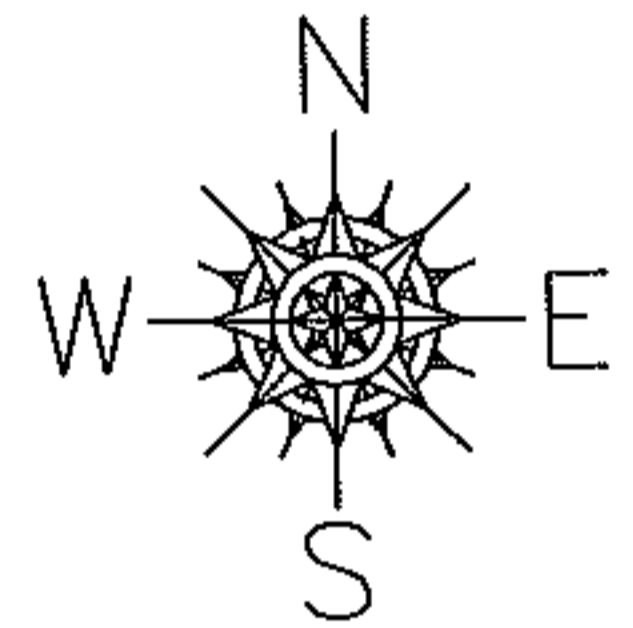

13TH ST. 52'

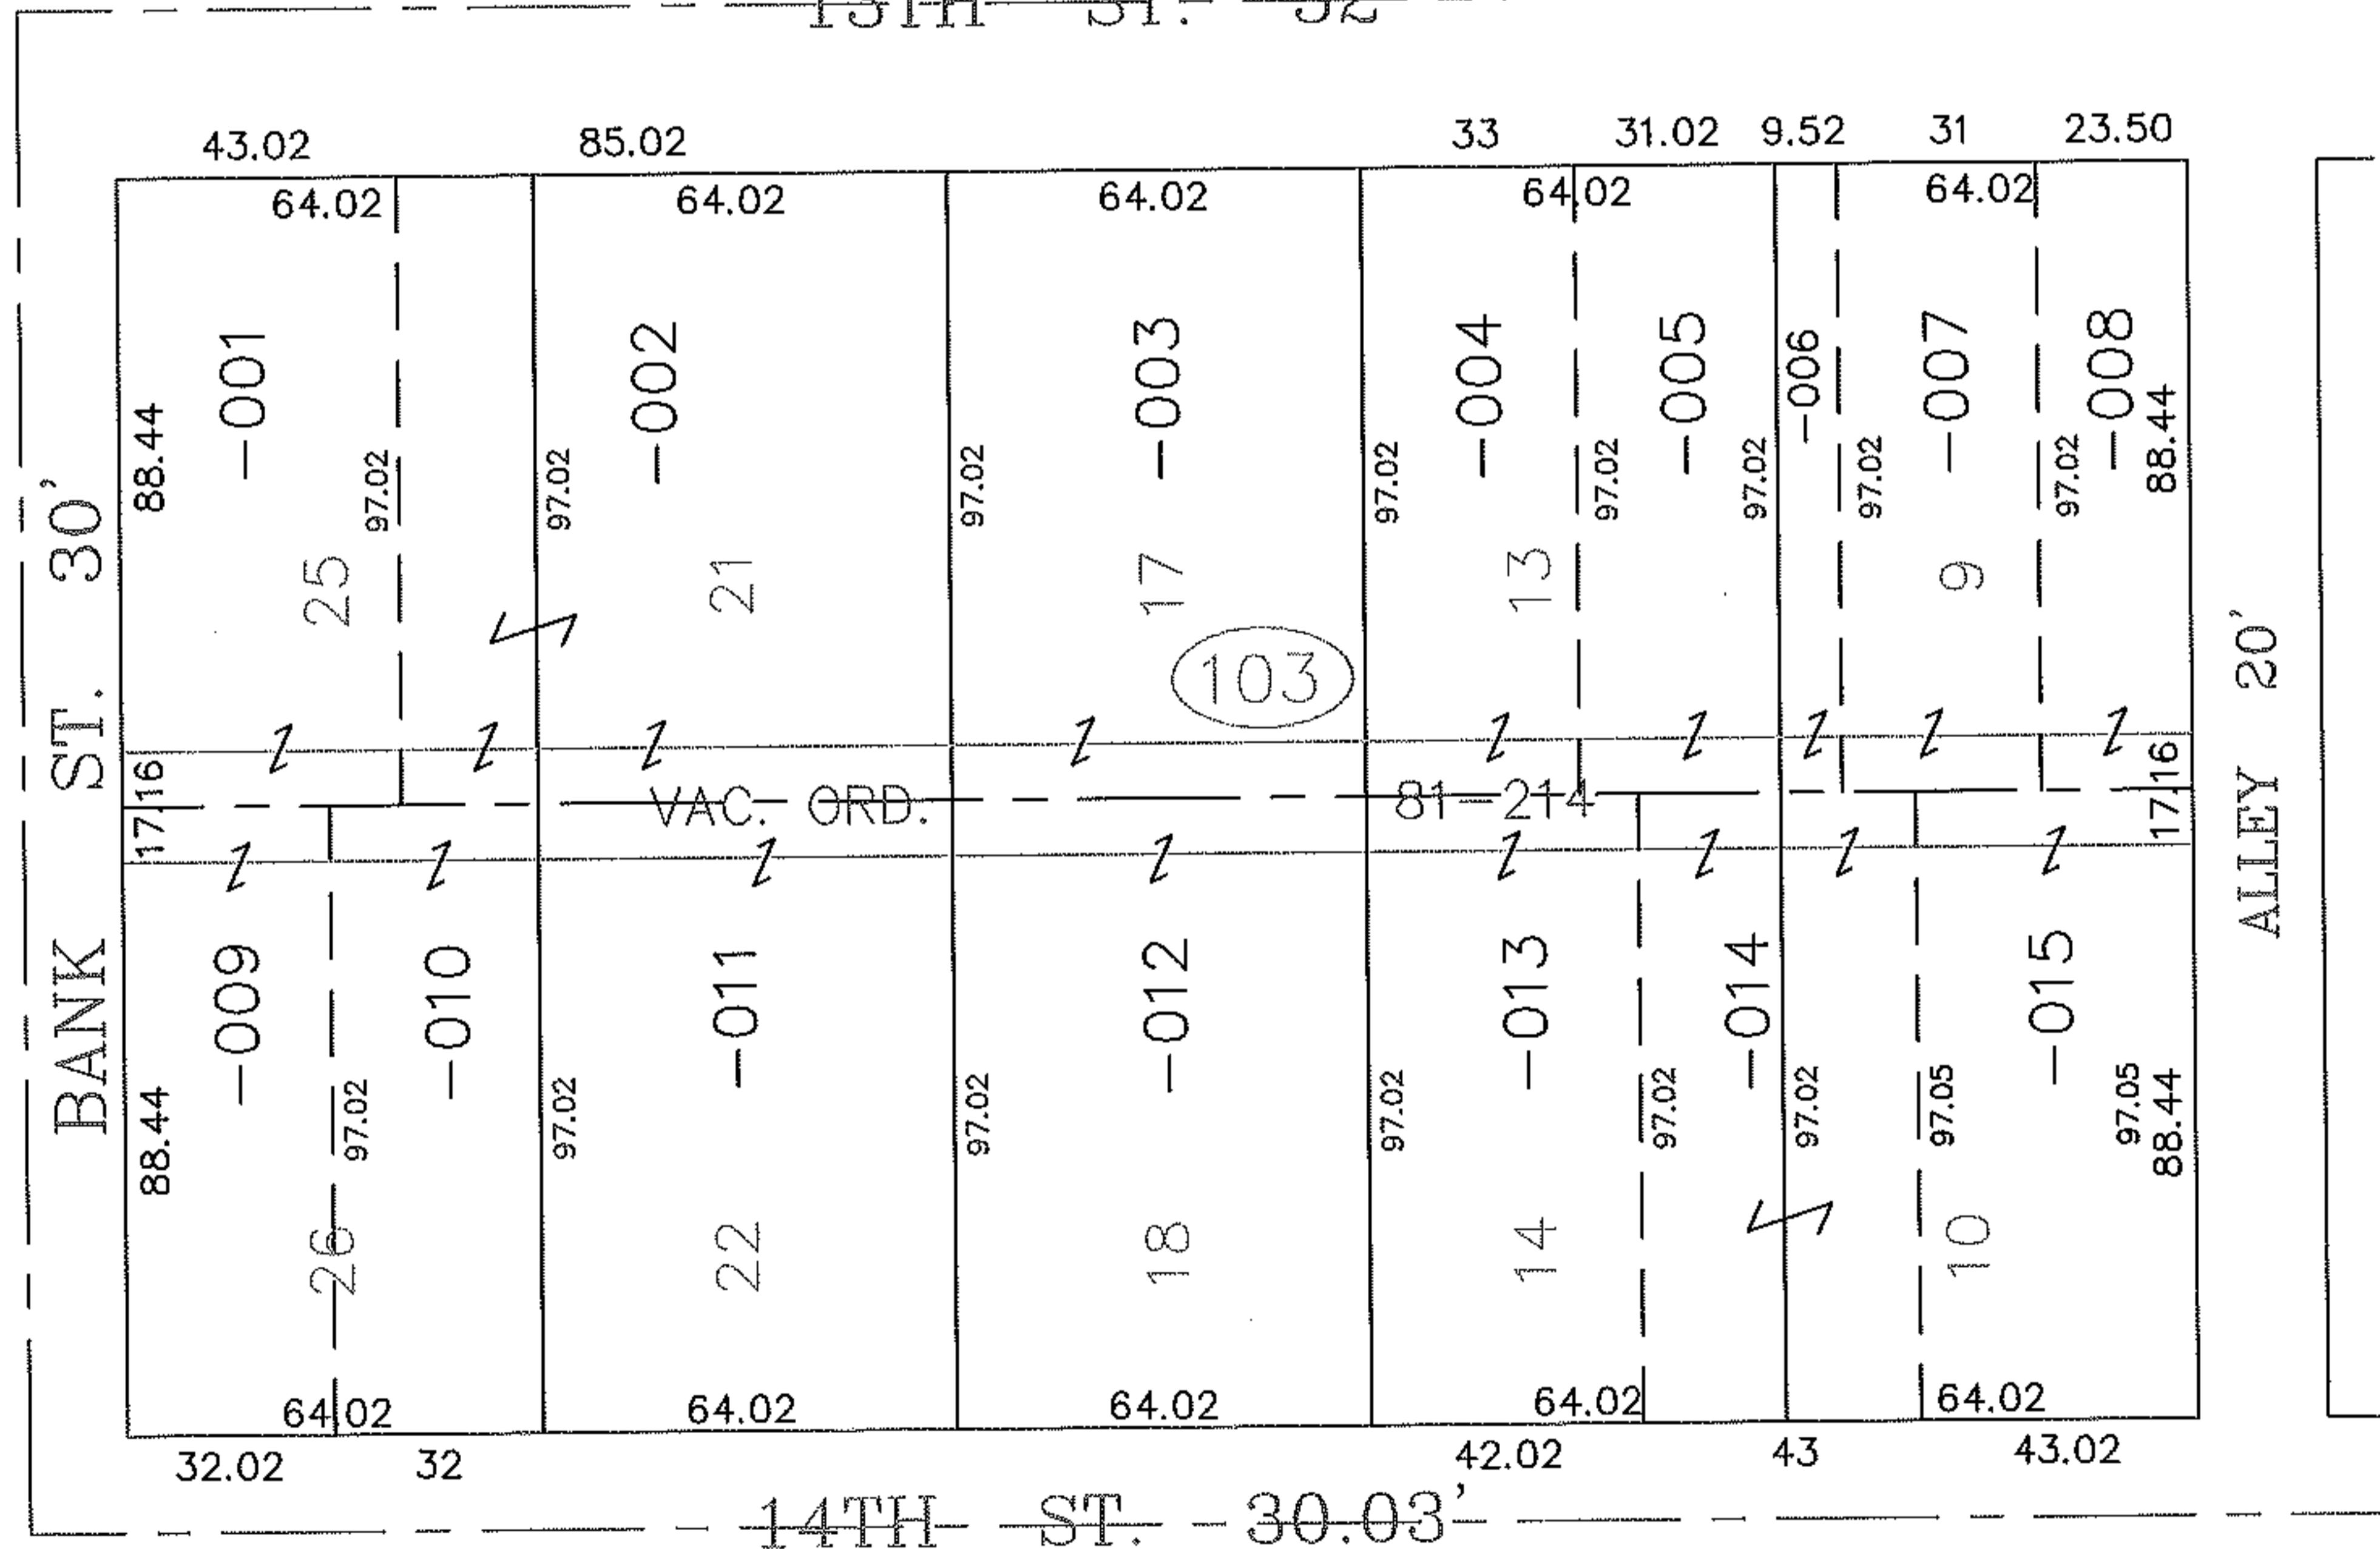

SPLITS/DEEDS PROCESSED

LORAIN COUNTY TAX MAP DEPARTMENT
226 MIDDLE AVE. ELYRIA, OHIO

SURVEYED BY: NA

CLOSURE: NA

MAP PAGE(S): 6-137

APPROVED BY: TJS DATE: 3/31/14

SCALE: 1"=50' PRIOR INST.: PV. 2 PG. 19