


PARENT PARCEL: 03-00-041-101-015

CHILD PARCEL: XX-XX-XXX-XXX-XXX

STARTING POINT: CL OF LAKE RD. & EAST LINE OF O.L. 41

14-02909-C

MAP CORRECTION ONLY

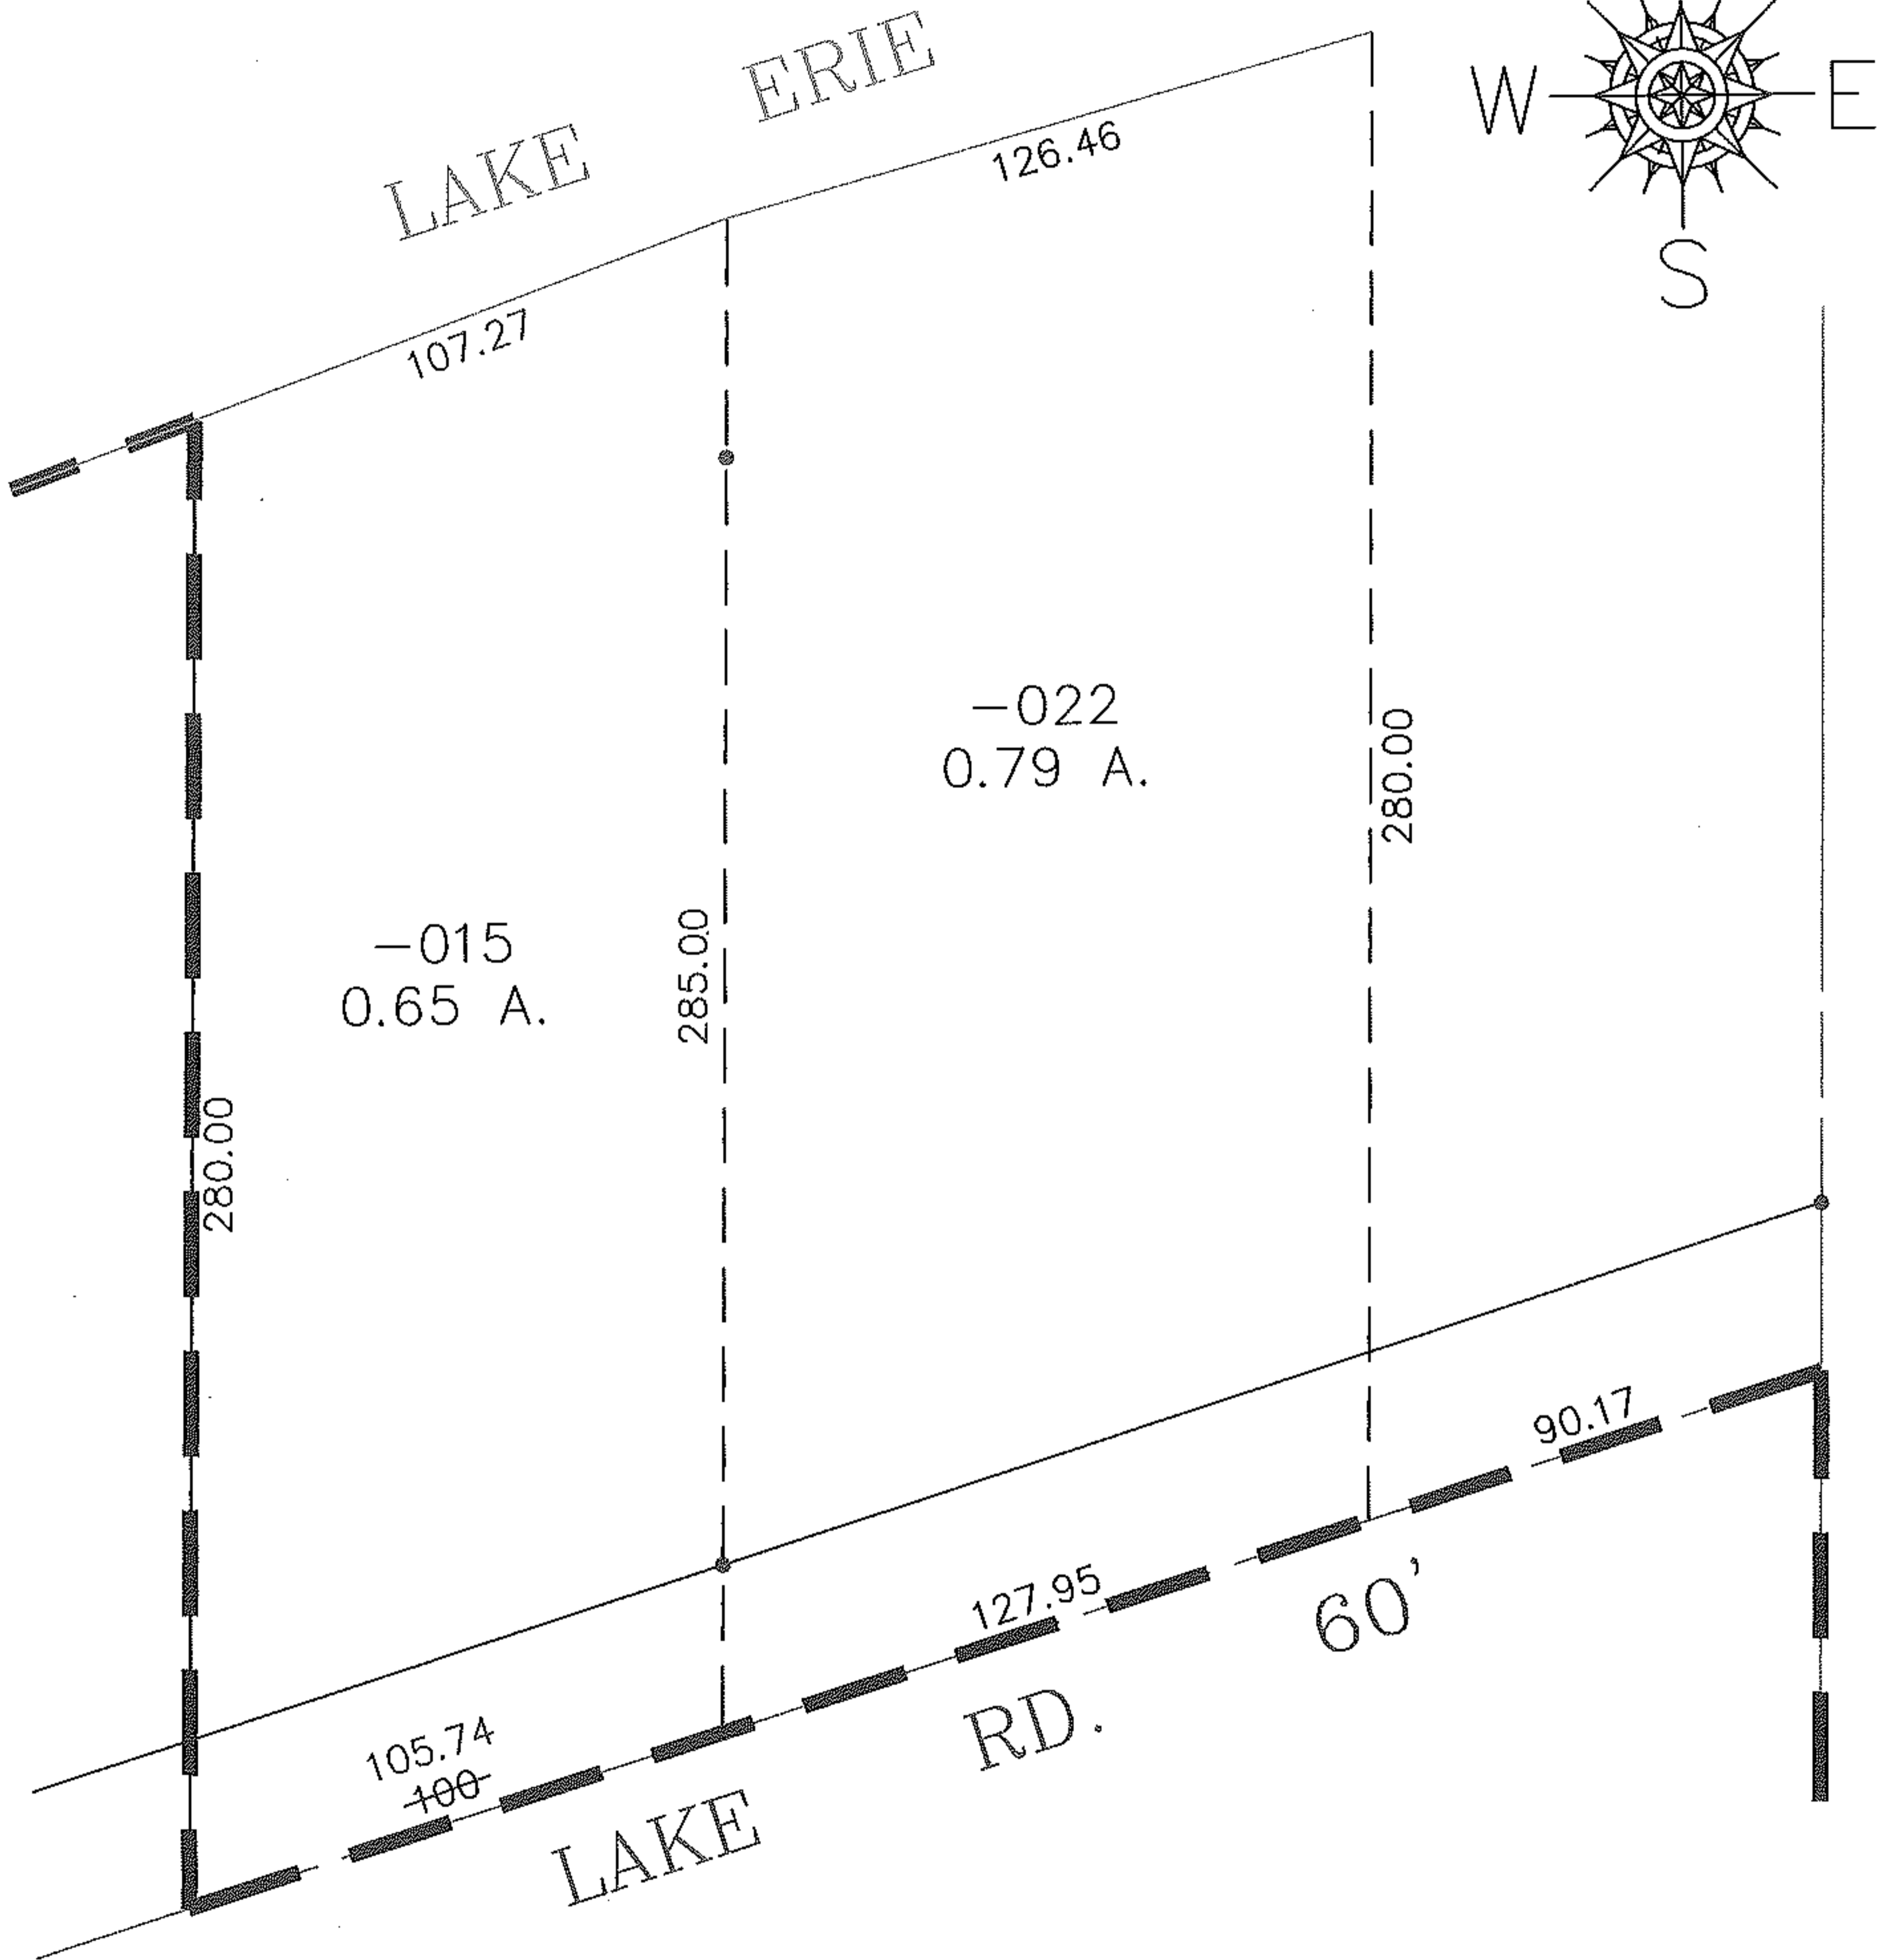

SPLITS/DEEDS PROCESSED

LORAIN COUNTY TAX MAP DEPARTMENT
226 MIDDLE AVE. ELYRIA, OHIO

SURVEYED BY: DAVID L. ELWELL

CLOSURE: 0.01 : 10,000

MAP PAGE(S): 3-00-041

APPROVED BY: TJS DATE: 4/2/14

SCALE: 1" = 50' PRIOR INST.: 19980578240