
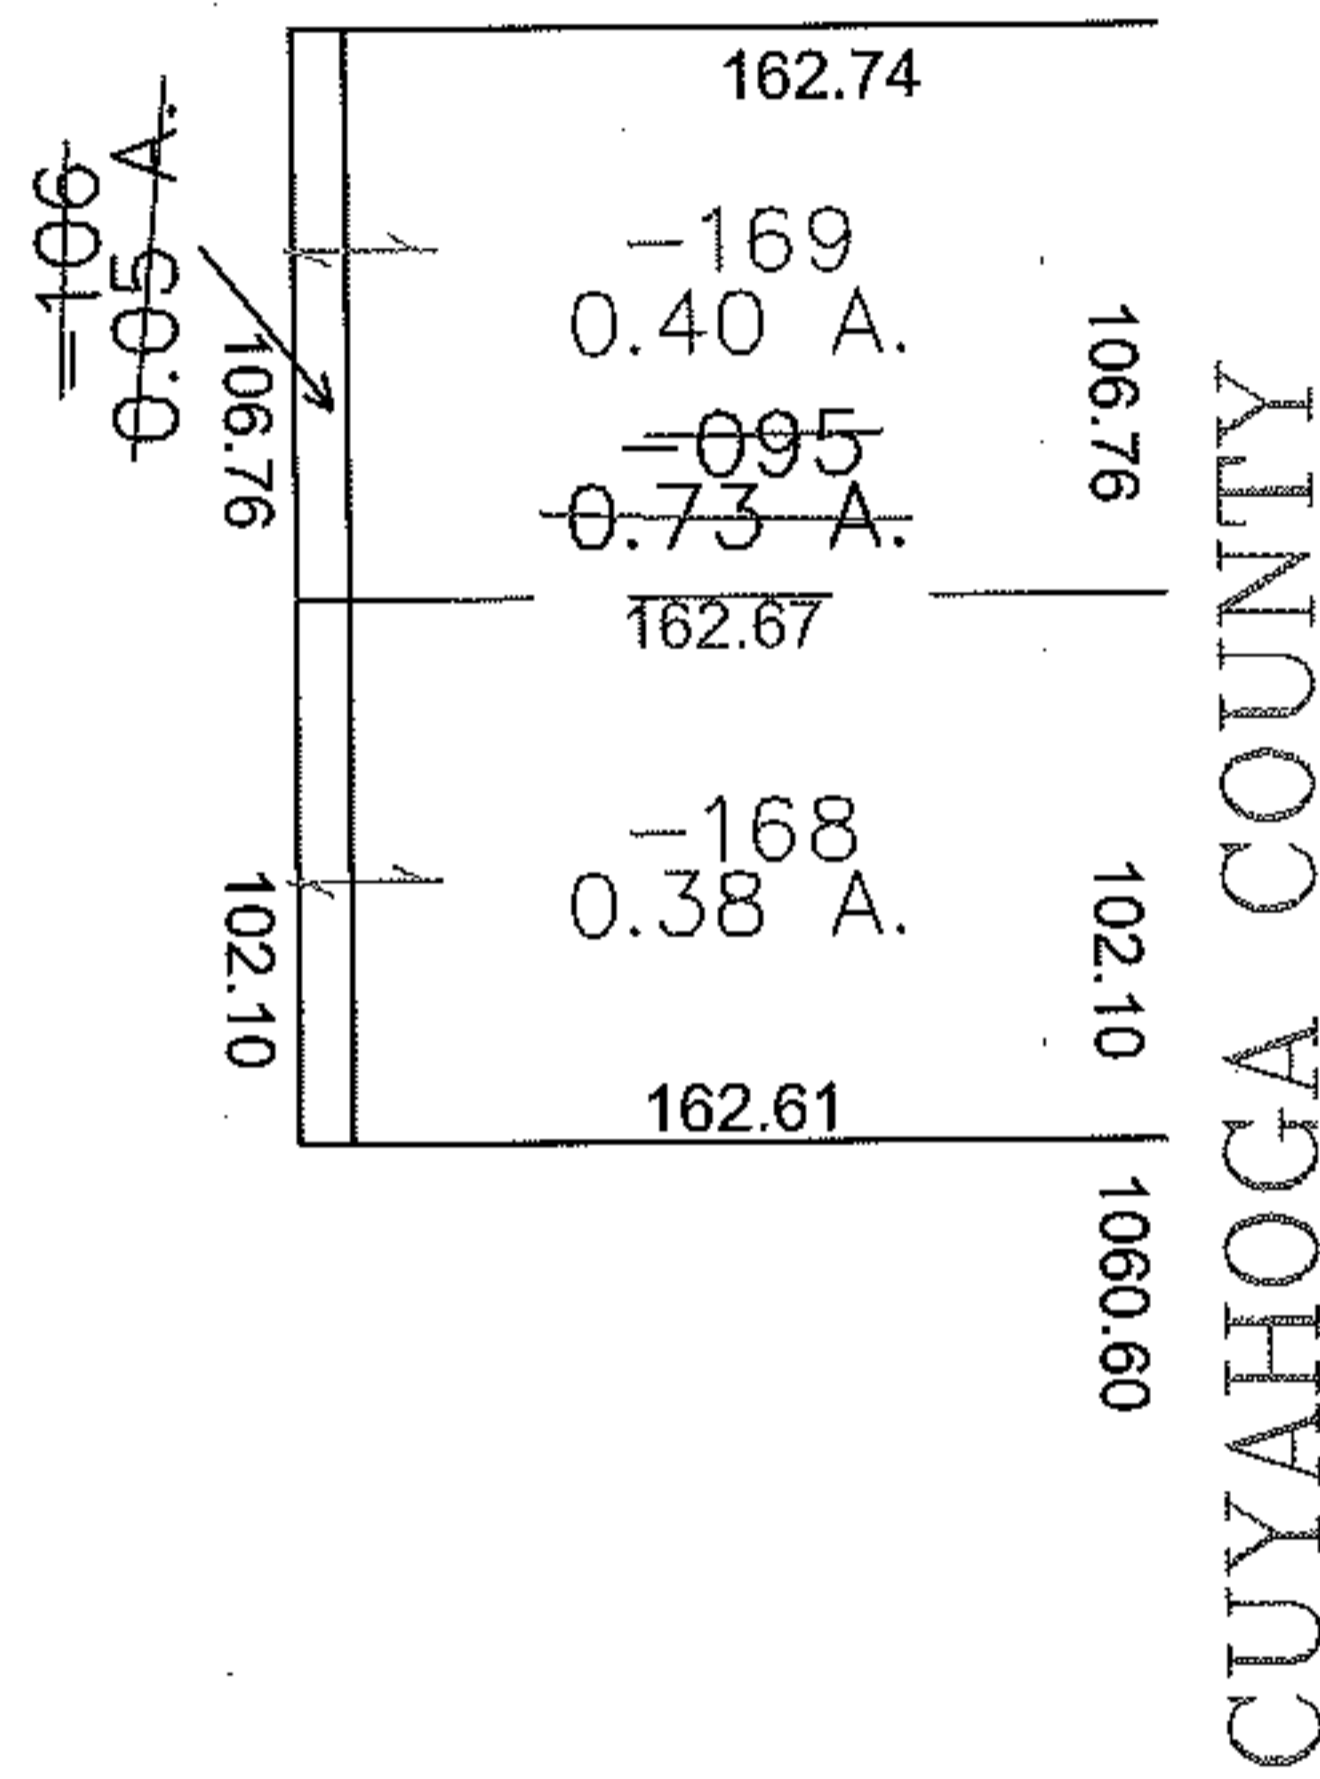


PARENT PARCEL: 04-00-026-108-095, -106


CHILD PARCEL: 04-00-026-108-168, -169

STARTING POINT: CENTERLINE OF SCHWARTZ RD & COUNTY LINE LORAIN/CUYAHOGA CNTY

11-02909

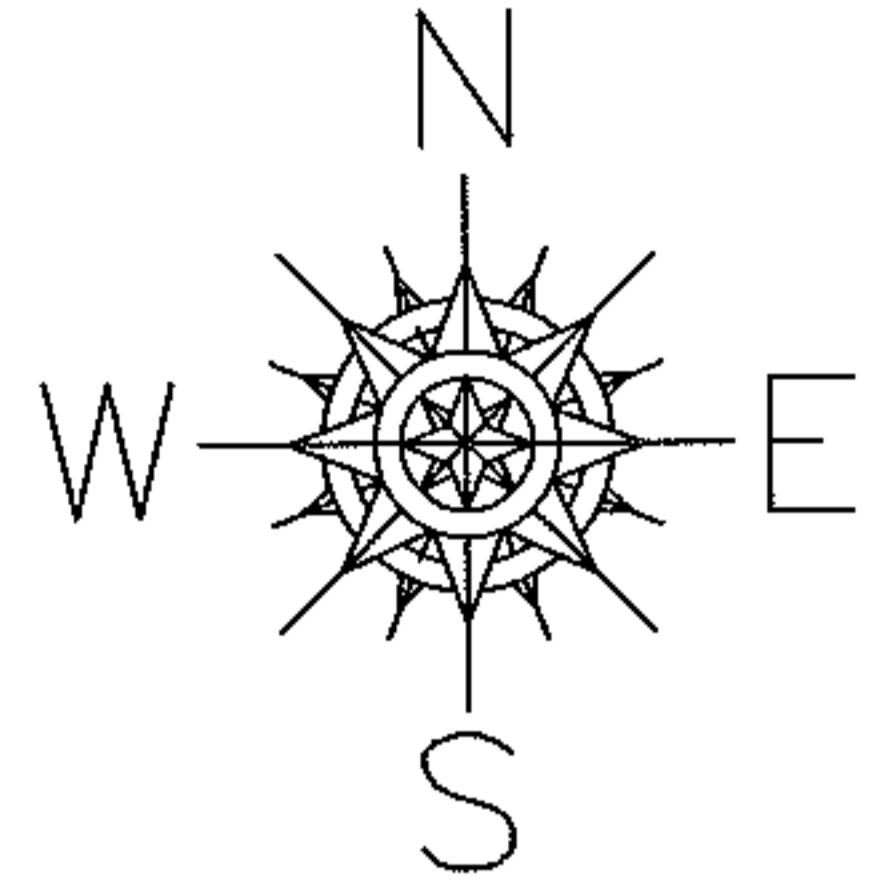

SCHWARTZ RD

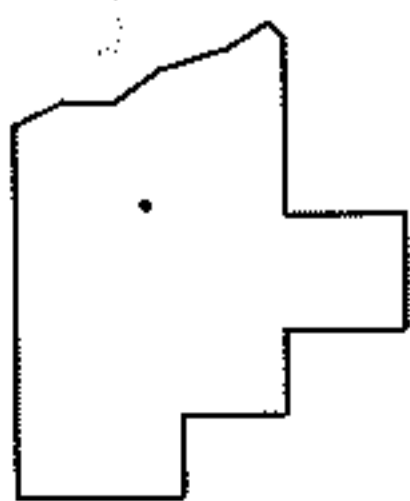

SPLITS/DEEDS PROCESSED

LORAIN COUNTY TAX MAP DEPARTMENT  
226 MIDDLE AVE. ELYRIA, OHIO

SURVEYED BY: DANIEL J COOK  
 CLOSURE: 0.00 : 10.000  
 MAP PAGE(S): 04-00-026-D  
 APPROVED BY: JAH DATE: 4/12/2011  
 SCALE: 1" = 100 PRIOR INSTRUMENT: 20080236769