

PARENT PARCEL: 11-00-068-000-018 & -019

CHILD PARCEL: 11-00-068-000-023

STARTING POINT: MON. BOX, CL OF N. DURKEE RD. & S.W. CORNER OF O.L. 73



11-02910

COMBINATION

~~11-00-068-000-018~~  
~~2.68 A.~~

~~11-00-068-000-019~~  
~~47.58 A.~~

11-00-068-000-023  
~~50.26 A.~~  
50.49 A.  
CORR. PER SURV.  
M. BRAMHALL

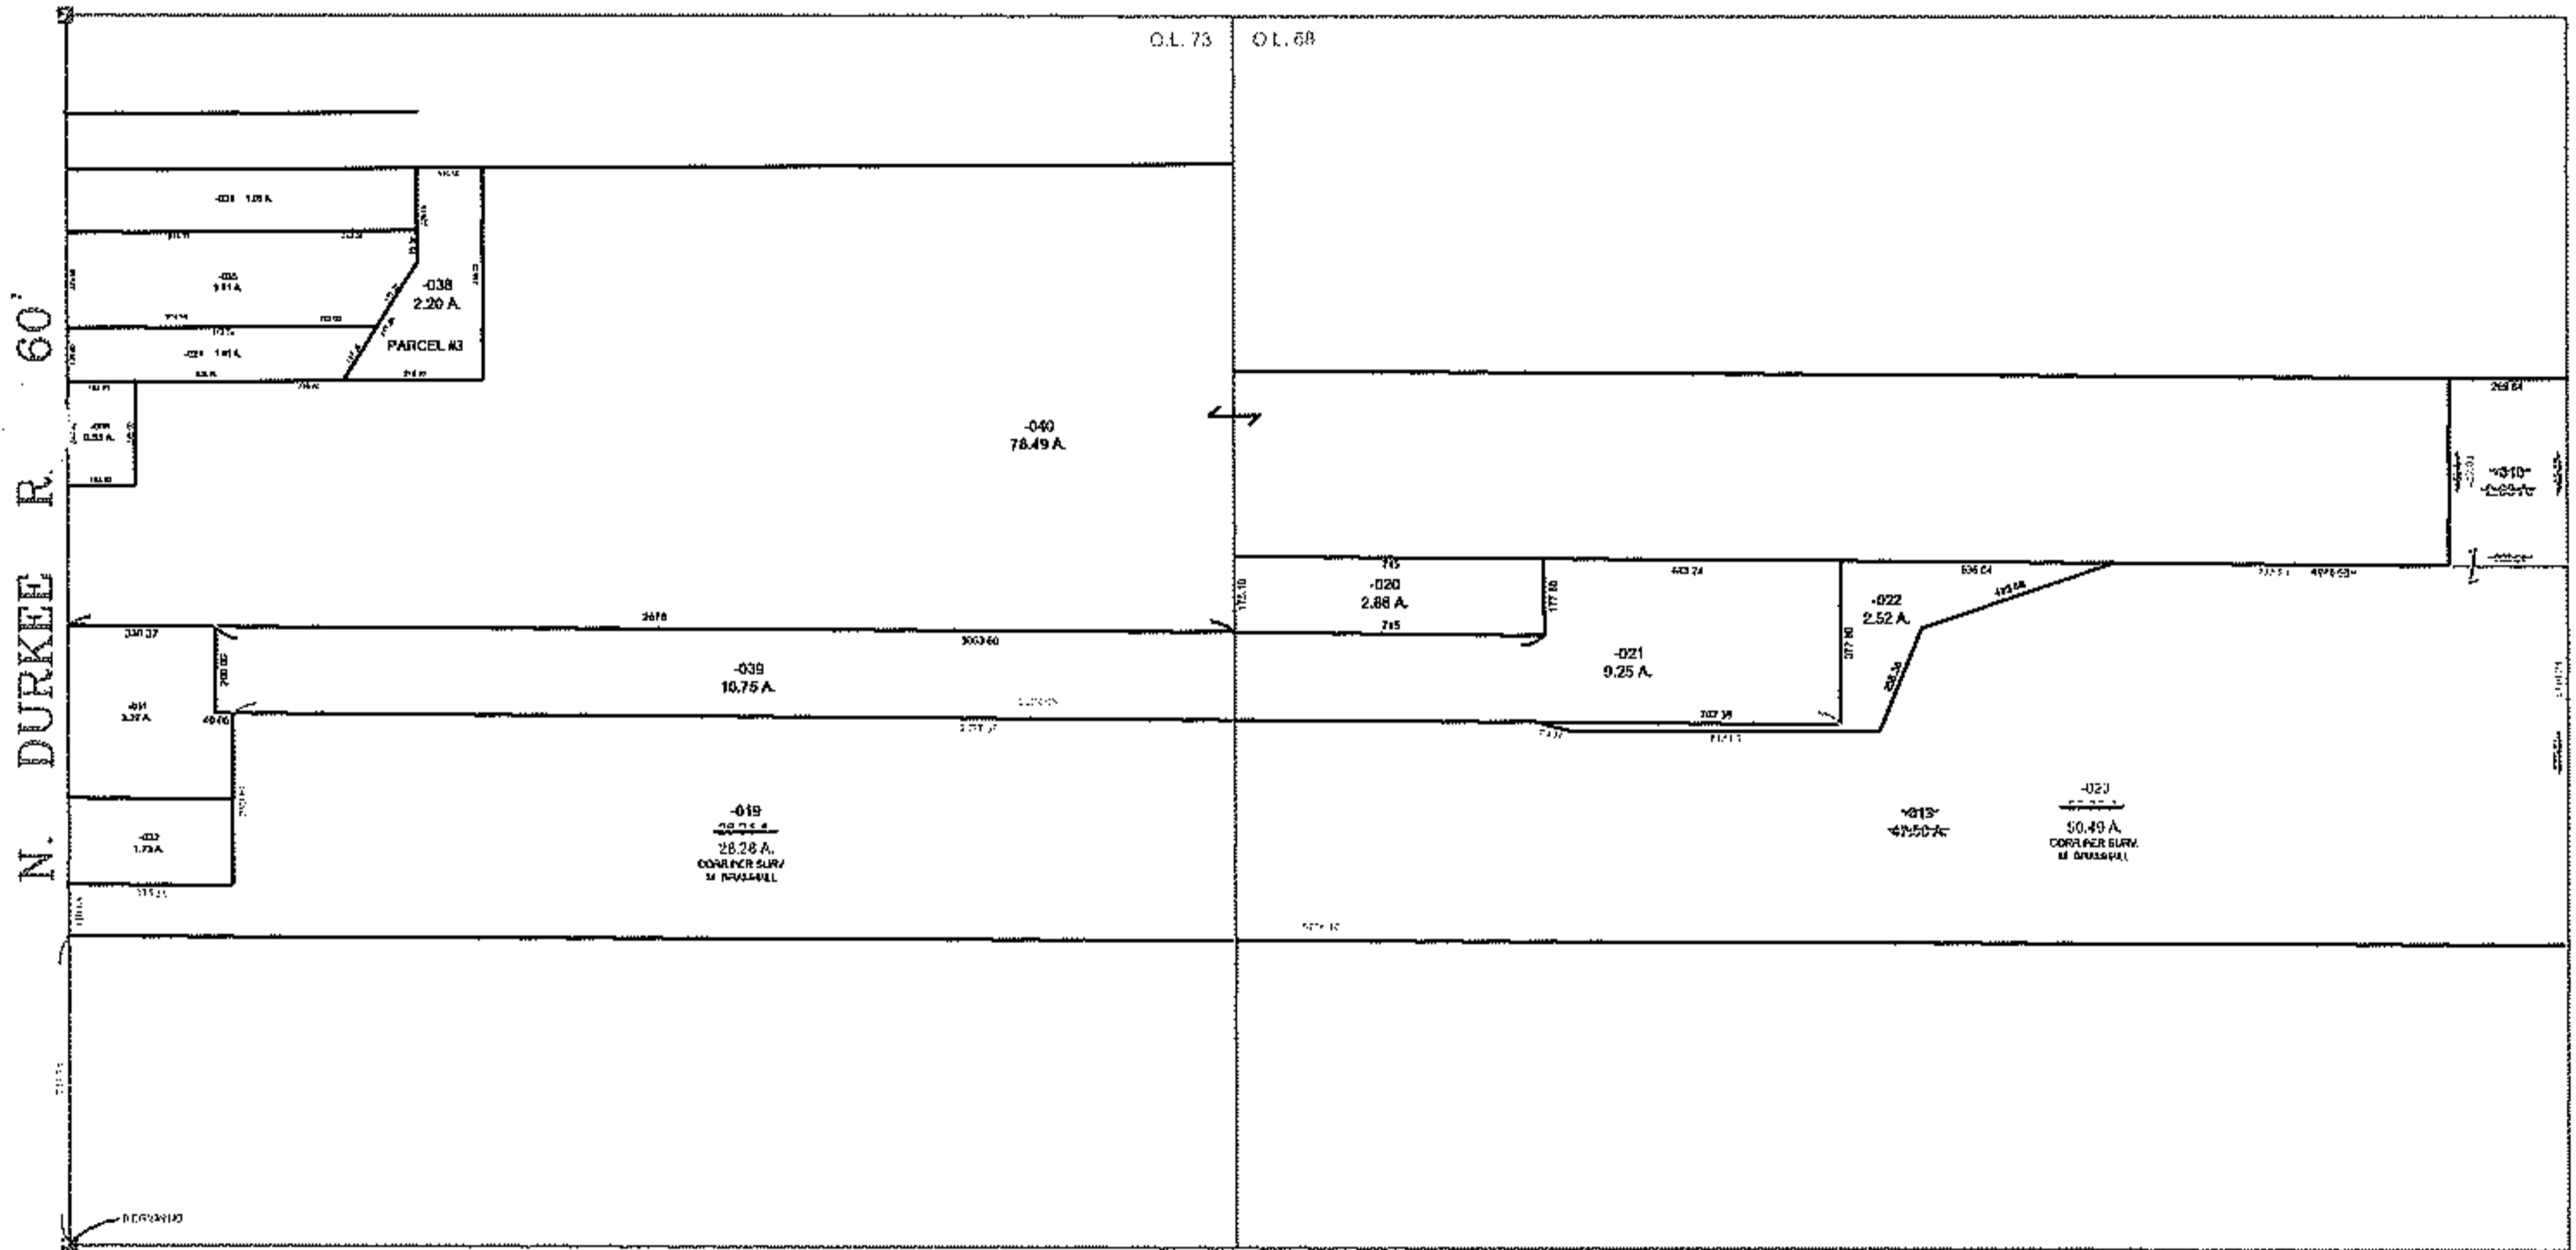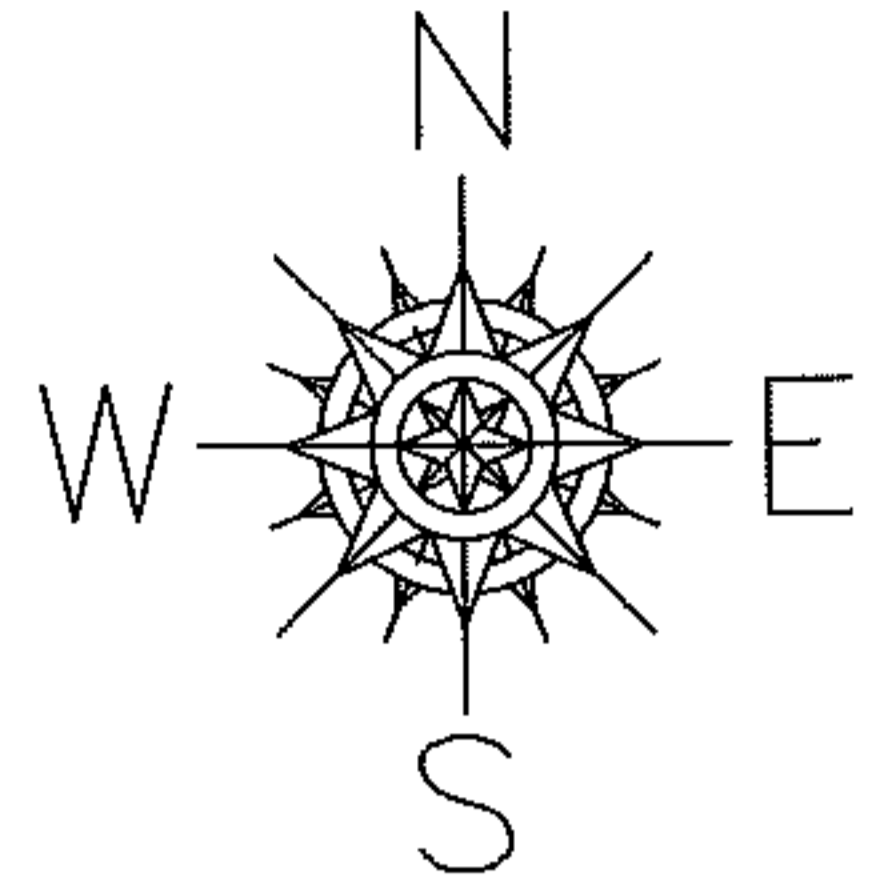

PRIOR INSTRUMENT: OR 248/144

PRIOR INSTRUMENT: OR 248/144

SURVEYED BY: CHARLES A. ROLLING

SURVEYED BY: MICHAEL BRAMHALL

SPLITS/DEEDS PROCESSED

LORAIN COUNTY TAX MAP DEPARTMENT  
226 MIDDLE AVE. ELYRIA, OHIO

CLOSURE: 0.01 : 10,000

MAP PAGE(S): 11-B

APPROVED BY: IJS DATE: 4/13/11

SCALE: 1" = 800 PRIOR INSTRUMENT: OR 248/144