
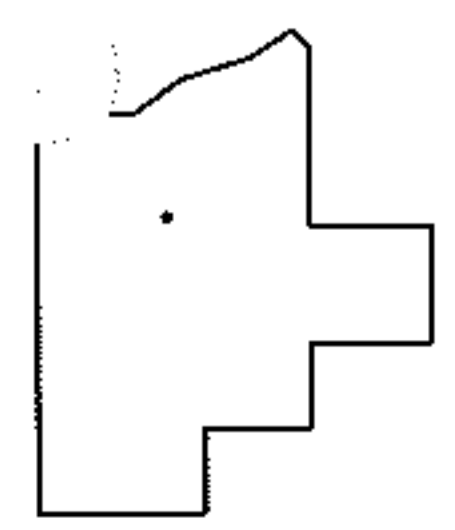
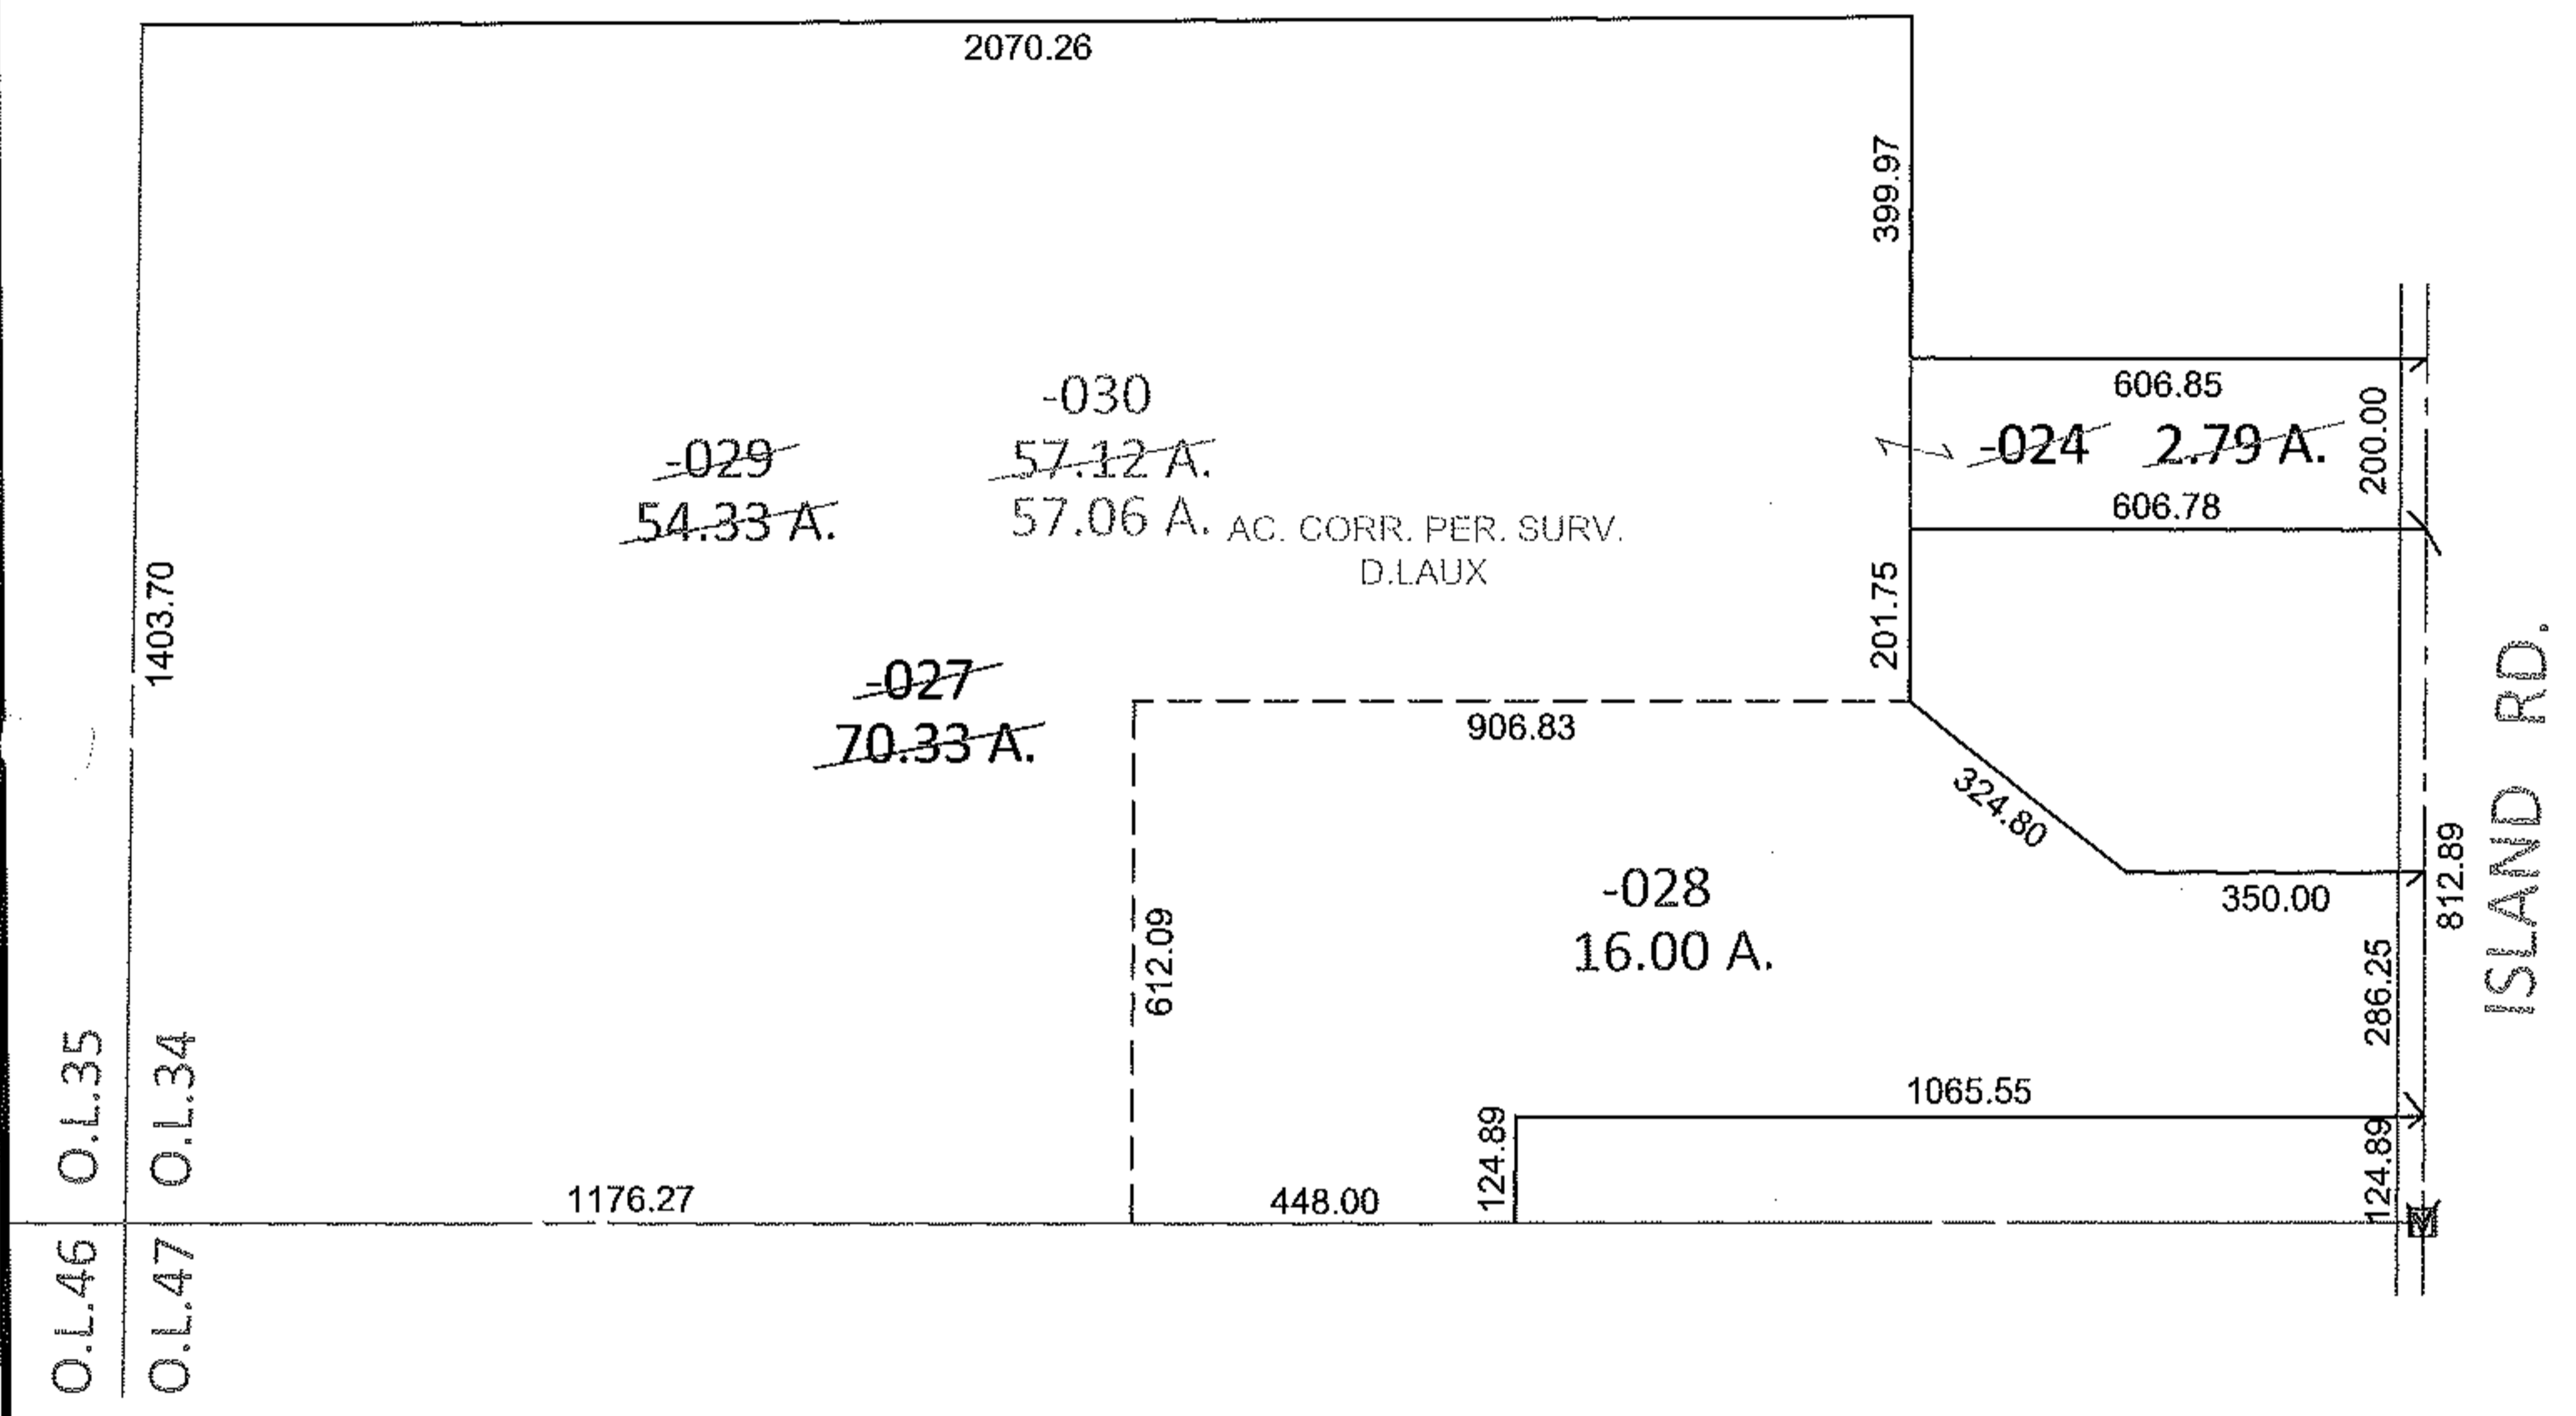


PARENT PARCEL: 16-00-034-000-024, -027  
 CHILD PARCEL: 16-00-034-000-028 THRU -030  
 STARTING POINT: AT A MON BOX IN THE C/L OF ISLAND RD. AT THE SOUTHEAST CORNER OF O.L.34

**11-02912**

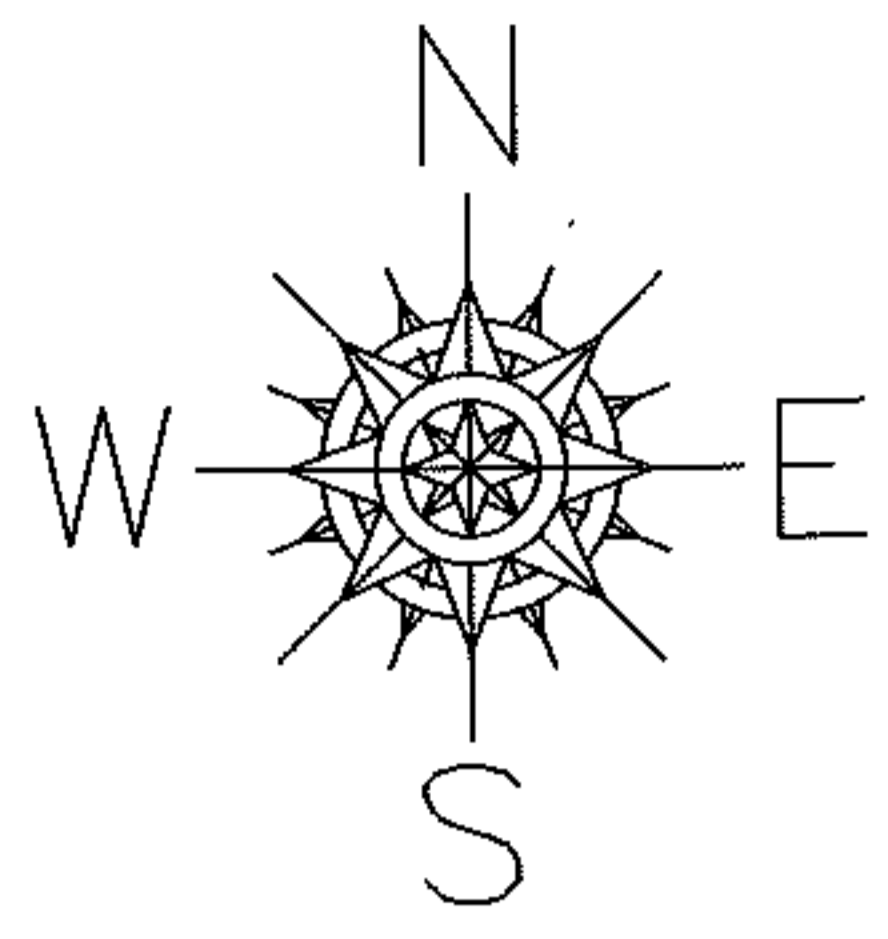

**SPLITS/DEEDS PROCESSED**  
 LORAIN COUNTY TAX MAP DEPARTMENT  
 226 MIDDLE AVE. ELYRIA, OHIO

SURVEYED BY: DANIEL LAUX  
 CLOSURE: .01:10,000  
 MAP PAGE(S): 16-C  
 APPROVED BY: RRM DATE: 4-26-11  
 SCALE: 1"= 400 PRIOR INST.: 20070209696