
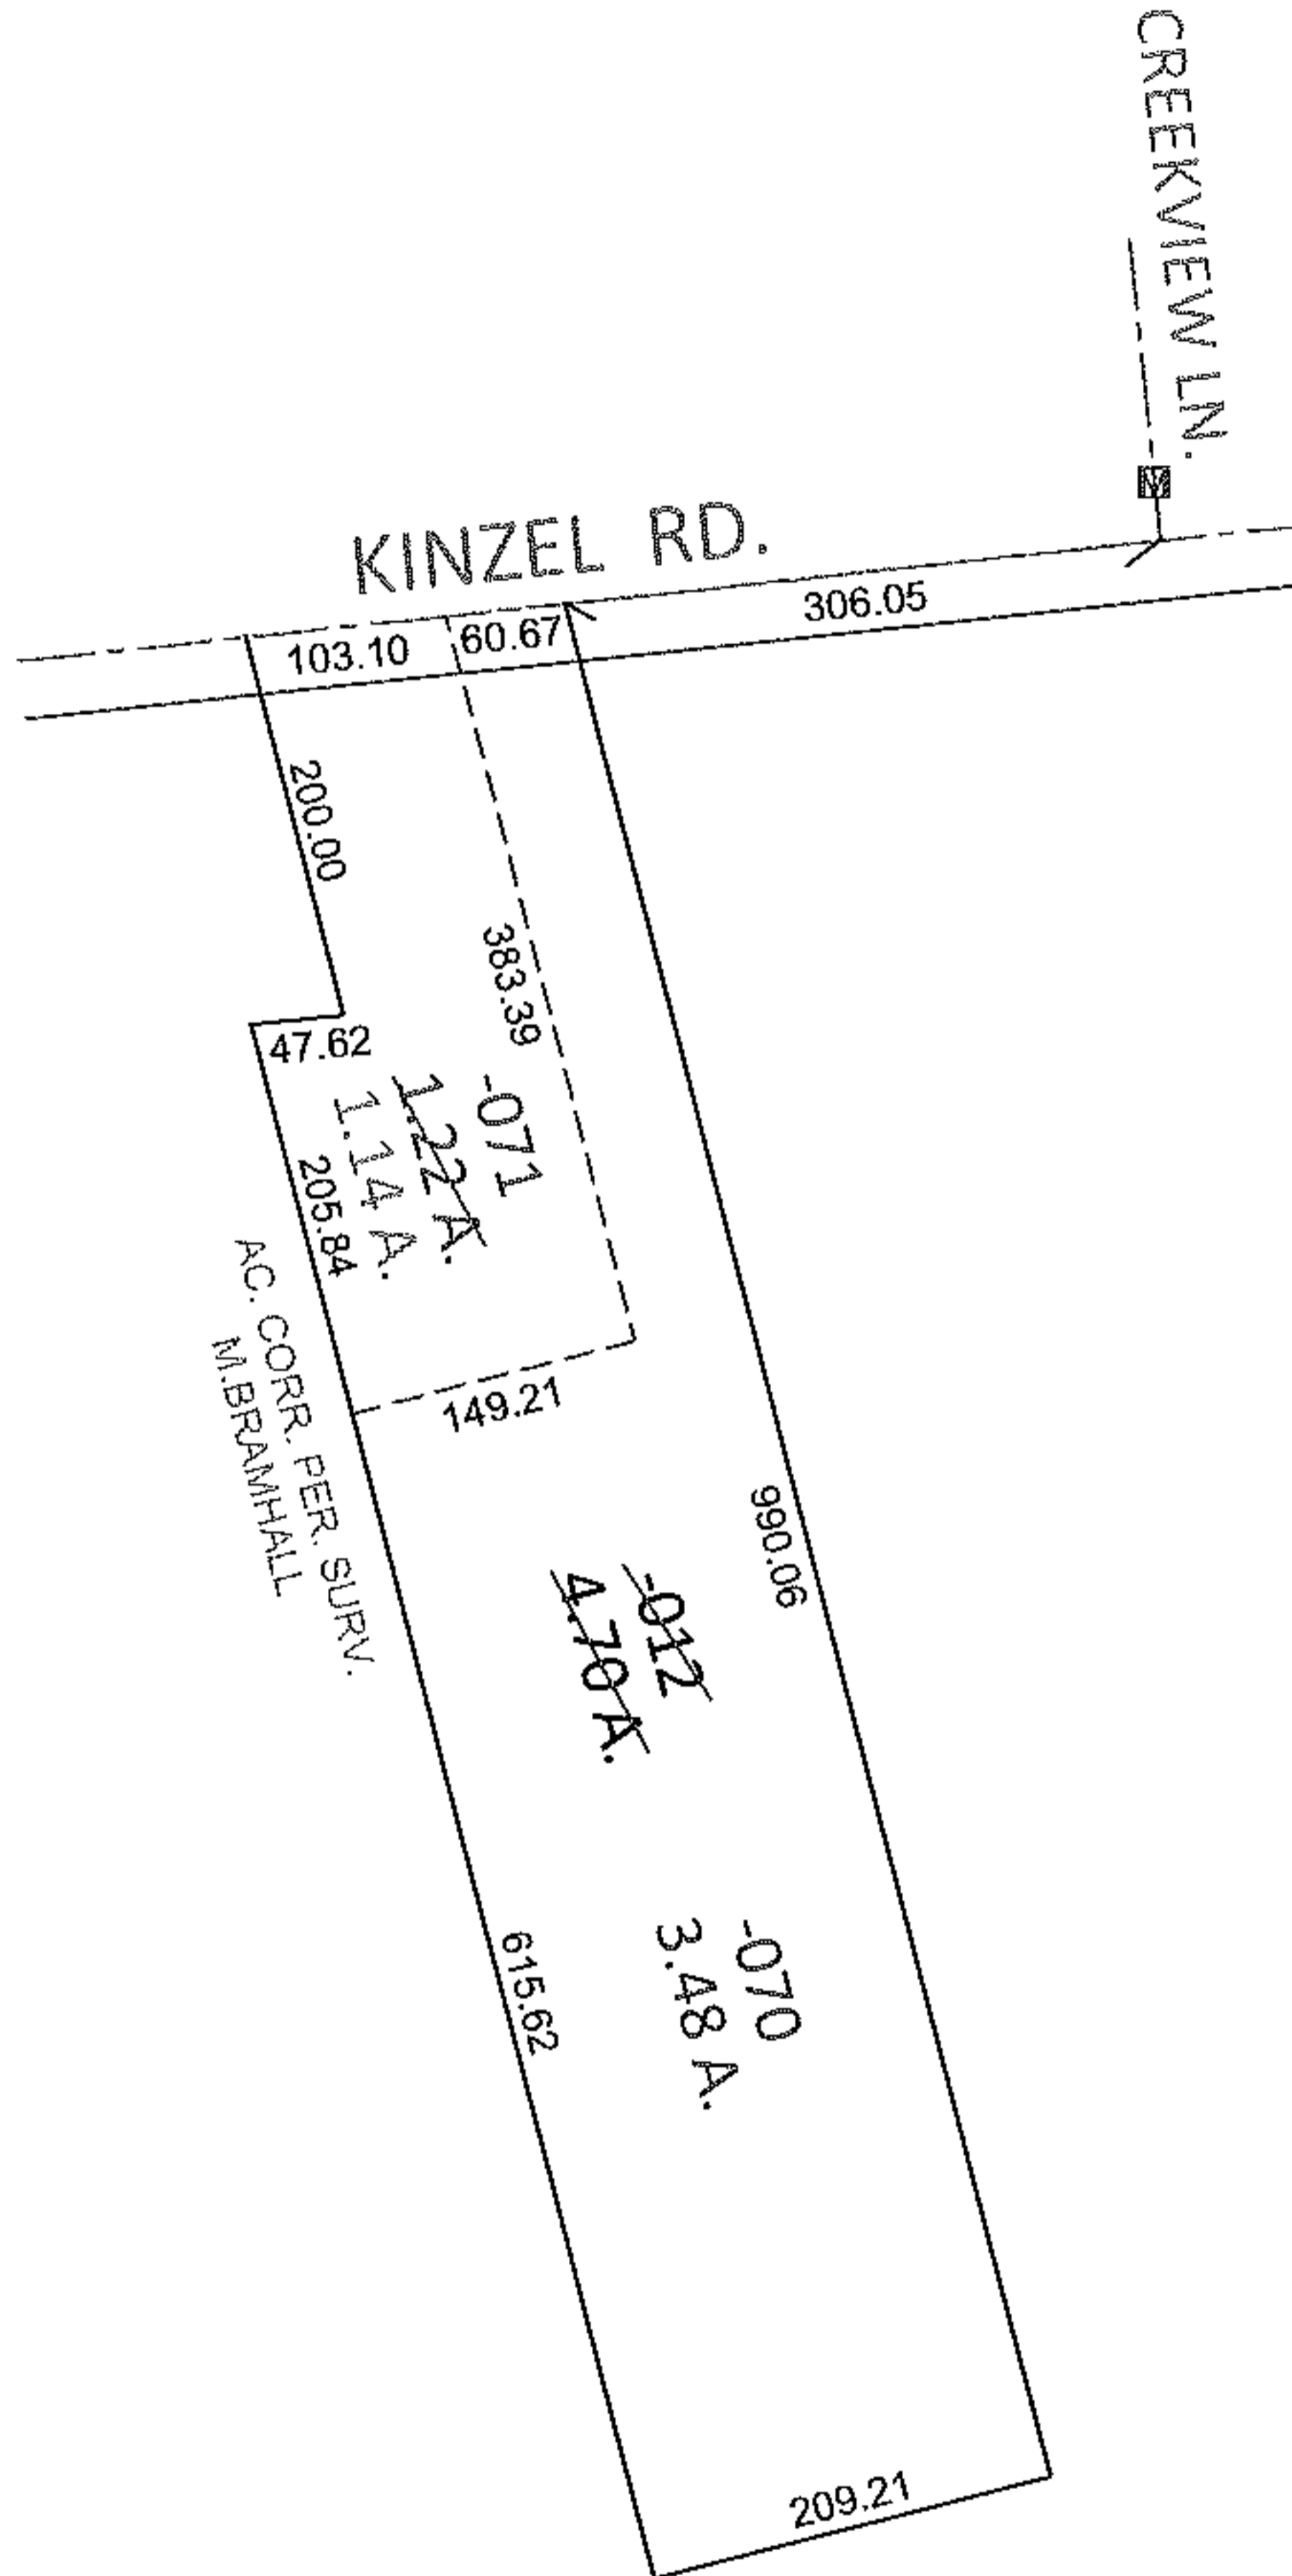


PARENT PARCEL: 04-00-014-105-012

CHILD PARCEL: 04-00-014-105-070, -071

STARTING POINT: INTERSECTION OF C/L OF KINZEL RD. AND C/L OF CREEKVIEW LN.

11-02914

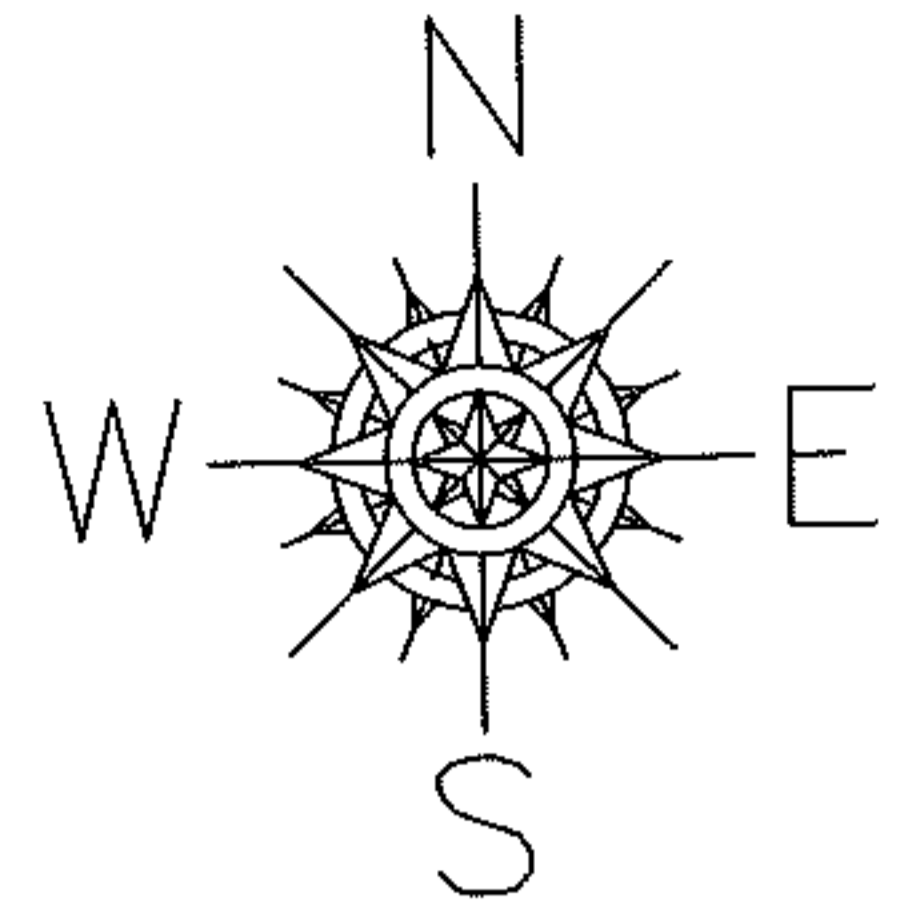

SPLITS/DEEDS PROCESSED

LORAIN COUNTY TAX MAP DEPARTMENT
226 MIDDLE AVE. ELYRIA, OHIO

SURVEYED BY: MICHAEL BRAMHALL

CLOSURE: .01:10,000

MAP PAGE(S): 4-00-014-E

APPROVED BY: RRM DATE: 4-28-11

SCALE: 1"= 200 PRIOR INST.: 20030975607