


PARENT PARCEL: 04-00-028-101-098

CHILD PARCEL: 04-00-028-900-004, 04-00-028-101-099 & -100

STARTING POINT: MON. BOX, CL OF NAGEL RD. & CL OF CHESTER RD.

11-02916

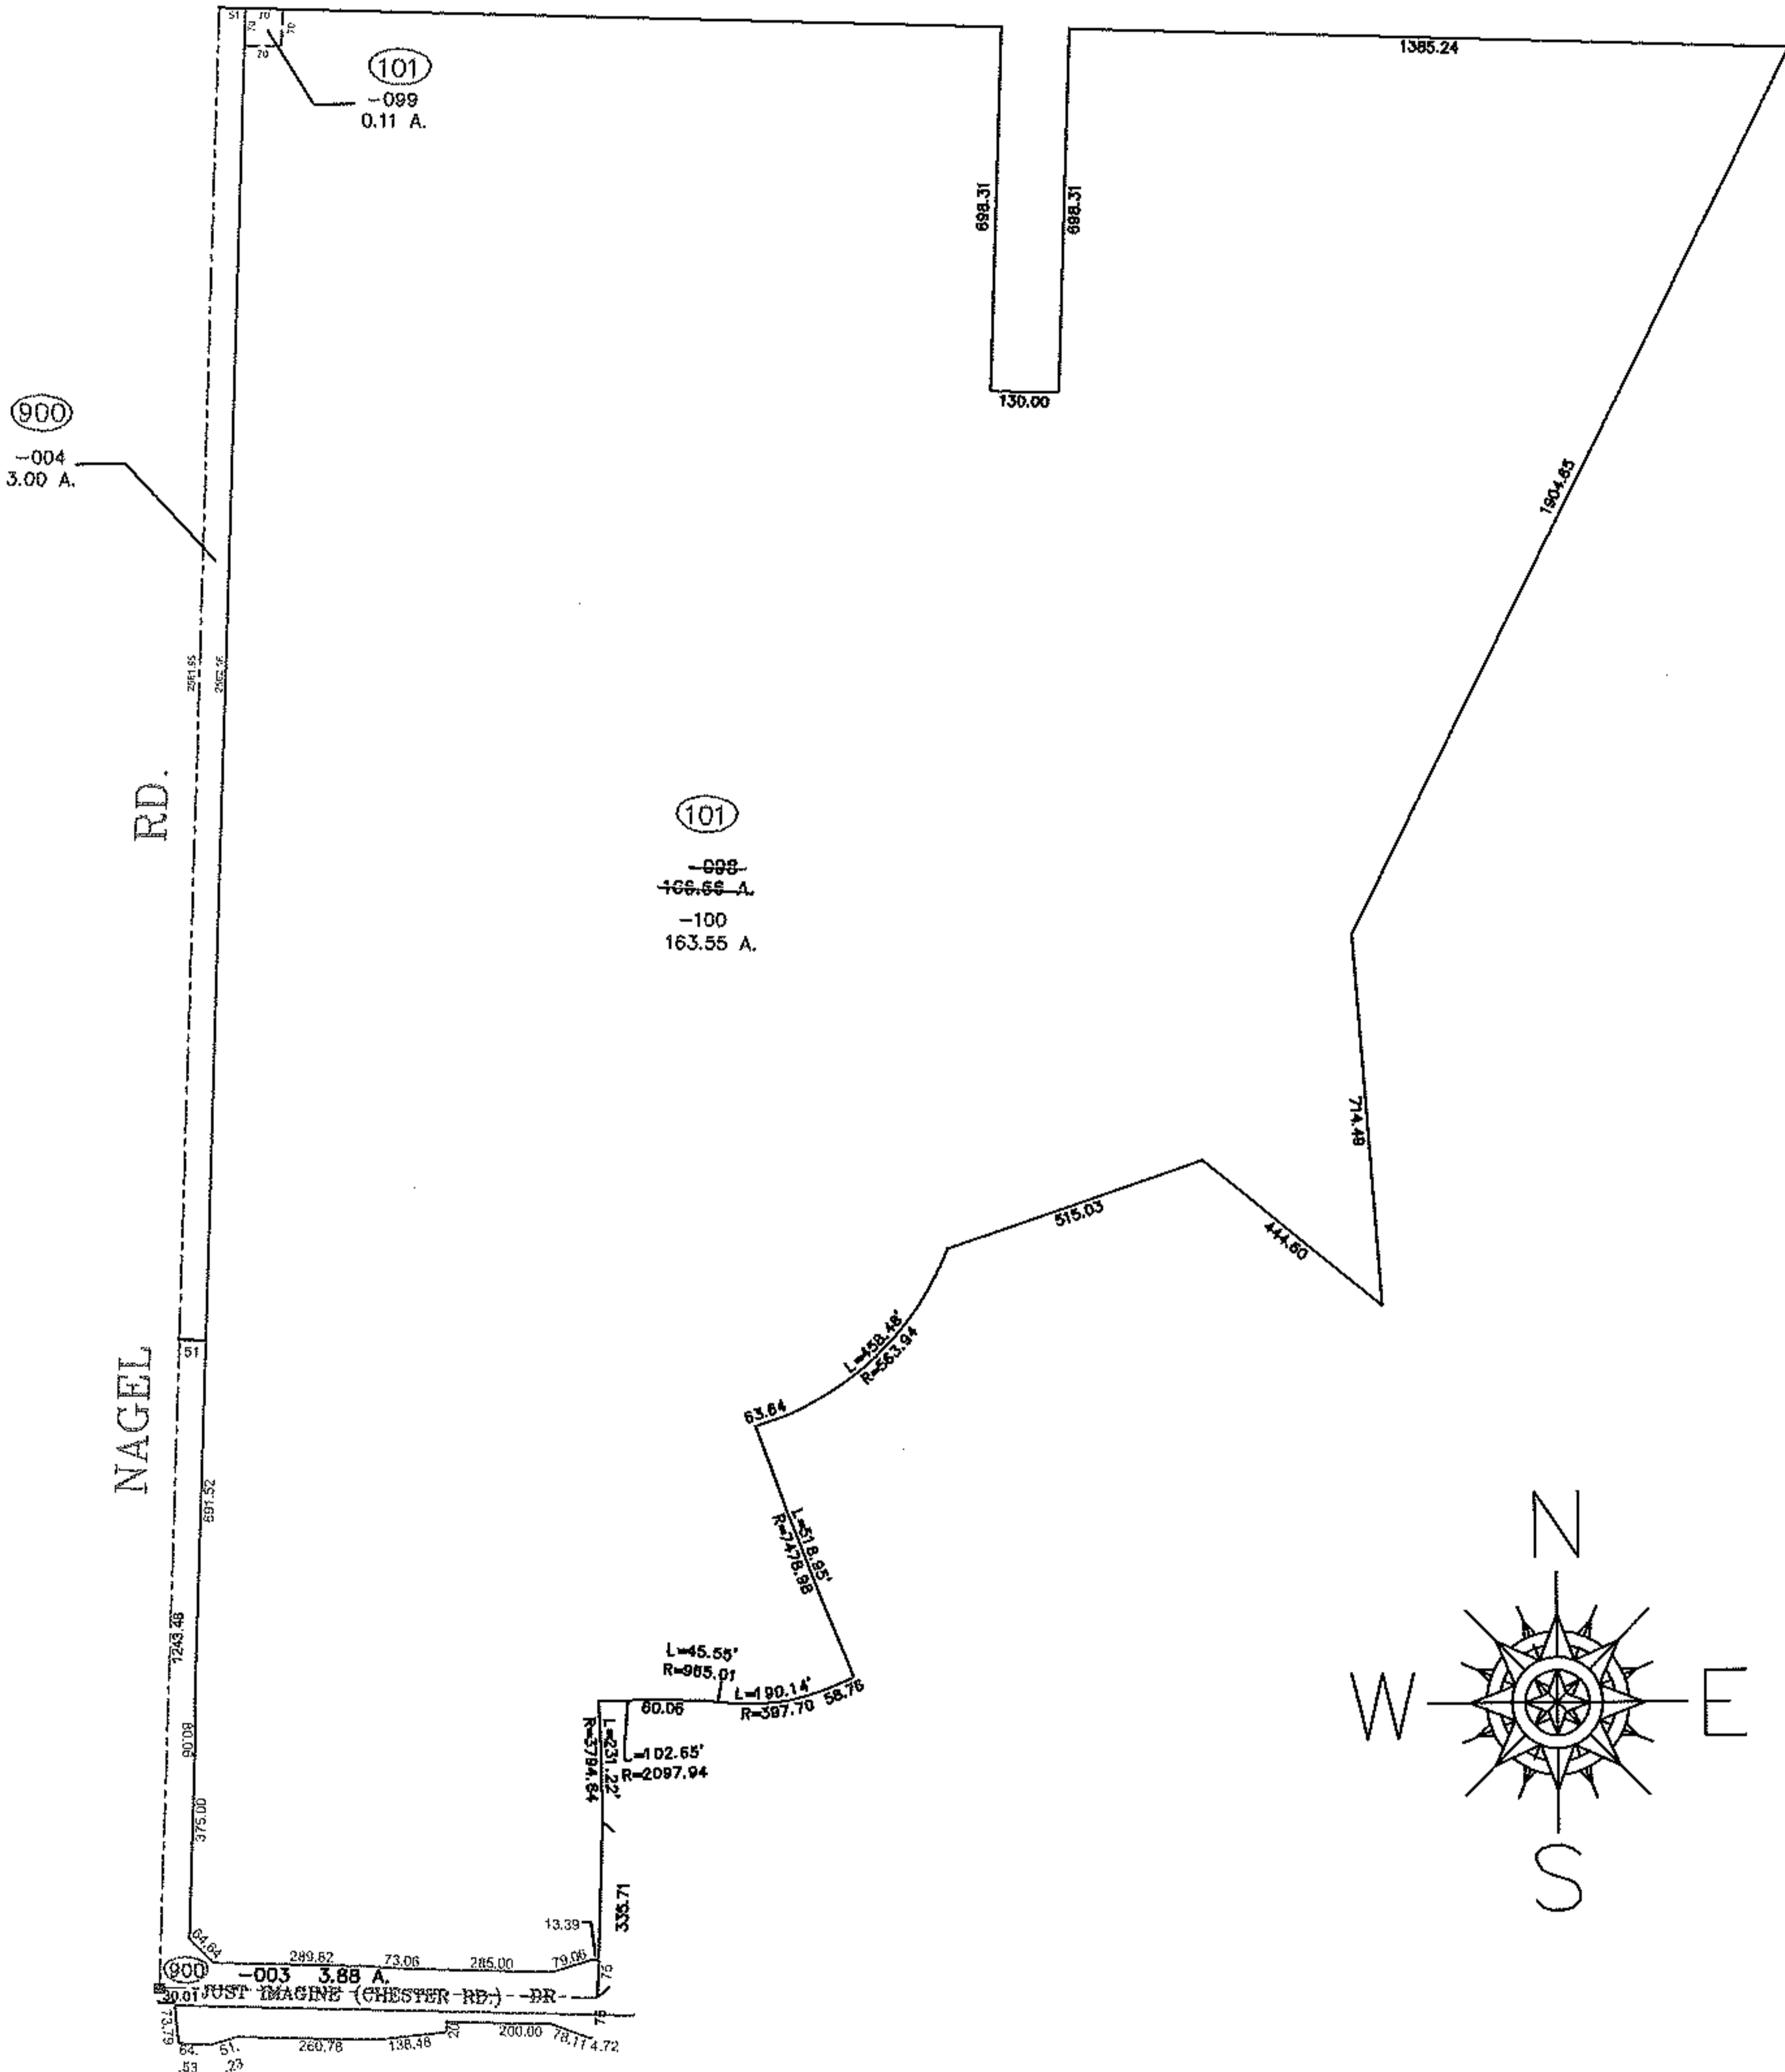

SPLITS/DEEDS PROCESSED

LORAIN COUNTY TAX MAP DEPARTMENT
226 MIDDLE AVE. ELYRIA, OHIO

SURVEYED BY: MICHAEL C. BRAMHALL

CLOSURE: 0.01 : 10,000

MAP PAGE(S): 04-00-028-A & E & F & B & C

APPROVED BY: TJS DATE: 5/5/11

SCALE: 1" = 500 PRIOR INST.: 20060133905