



RASTER

PARENT PARCEL: 04-00-018-130-043, -019,

CHILD PARCEL: 04-00-018-130-044 TRHU -049

11-02918

STARTING POINT: CENTERLINE OF LAKE RD & MAPLE CLIFF DR

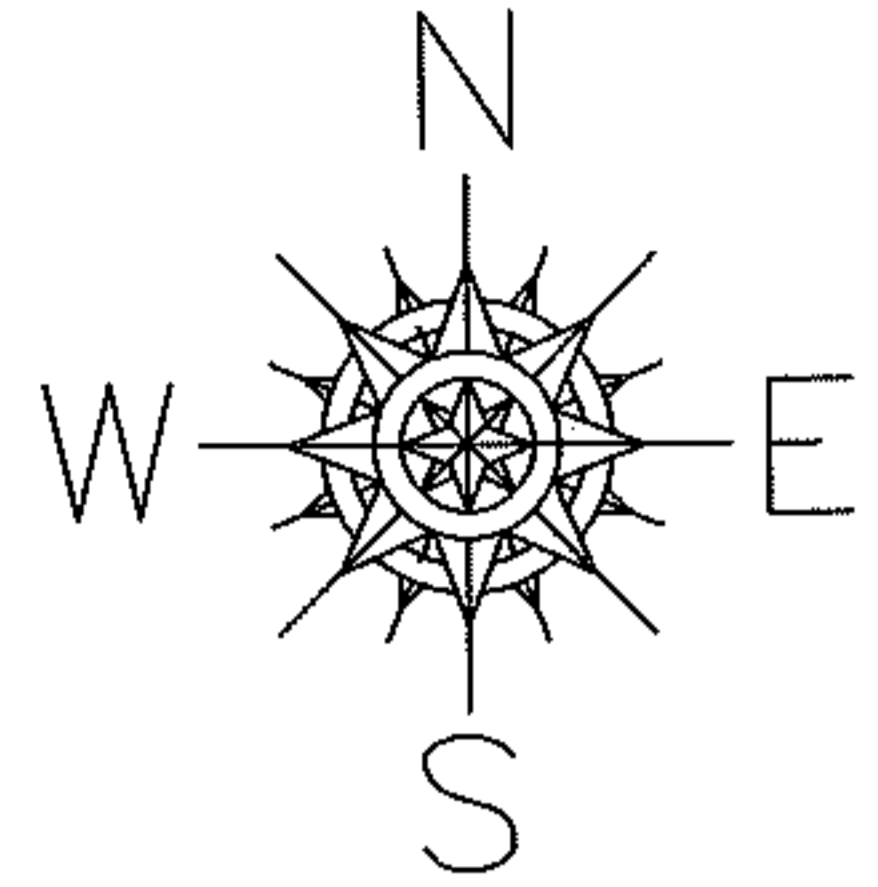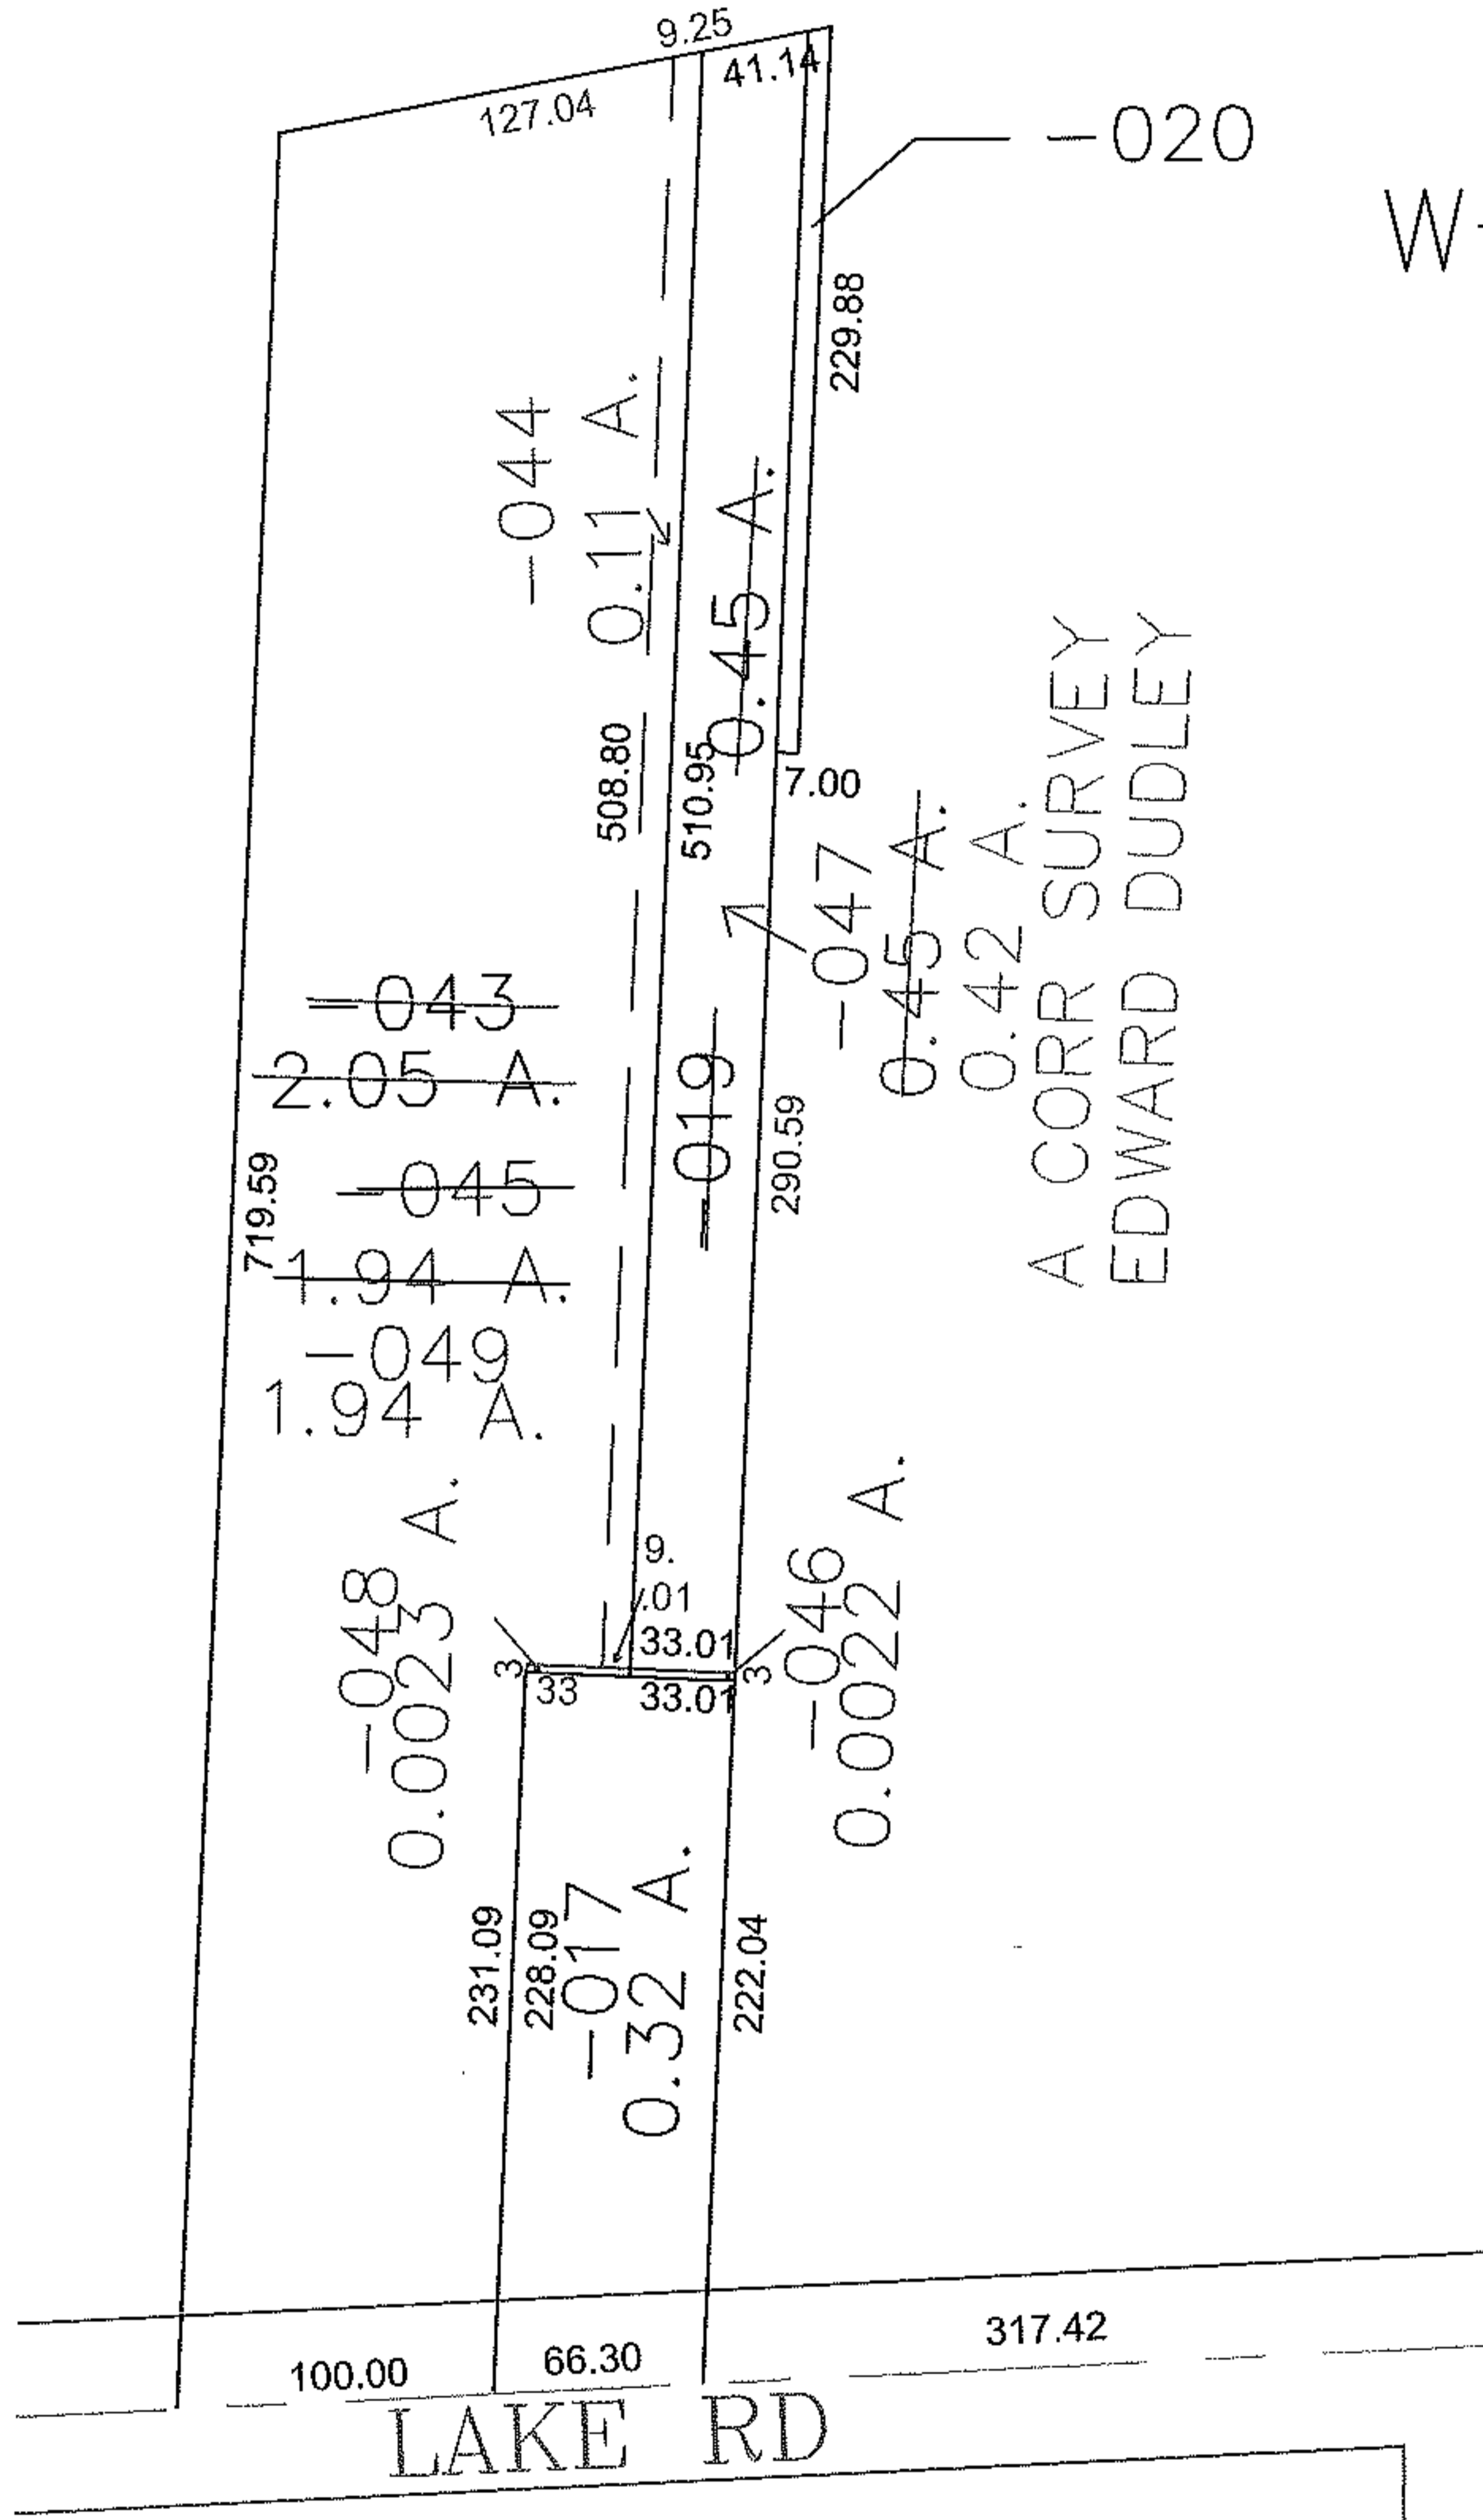

MAPLE CLIFF DR

SPLITS/DEEDS PROCESSED

LORAIN COUNTY TAX MAP DEPARTMENT  
226 MIDDLE AVE. ELYRIA, OHIO

SURVEYED BY:	EDWARD B DUDLEY
CLOSURE:	0.00 : 10.000
MAP PAGE(S):	04-00-018-C
APPROVED BY:	JAH DATE: 5-6-2011
SCALE:	1" = 100 PRIOR INSTRUMENT: 20080240598