

PARENT PARCEL: 11-00-083-000-021

CHILD PARCEL: 11-00-083-000-029 & -030

STARTING POINT: I.P. MON. BOX, CL OF CAPEL RD. & CL OF DURKEE RD.




14-02922-U

UNCOMBINATION

~~11-00-083-000-021~~
~~1.50 A.~~

11-00-083-000-029
0.50 A.

11-00-083-000-030
1.00 A.

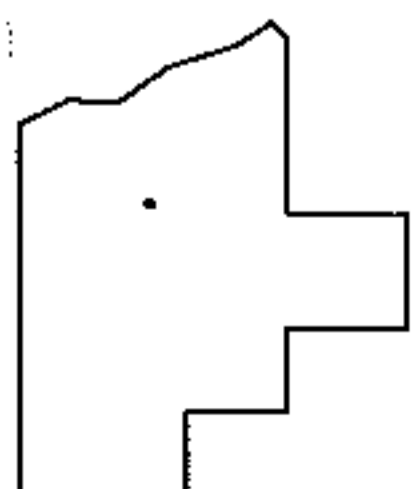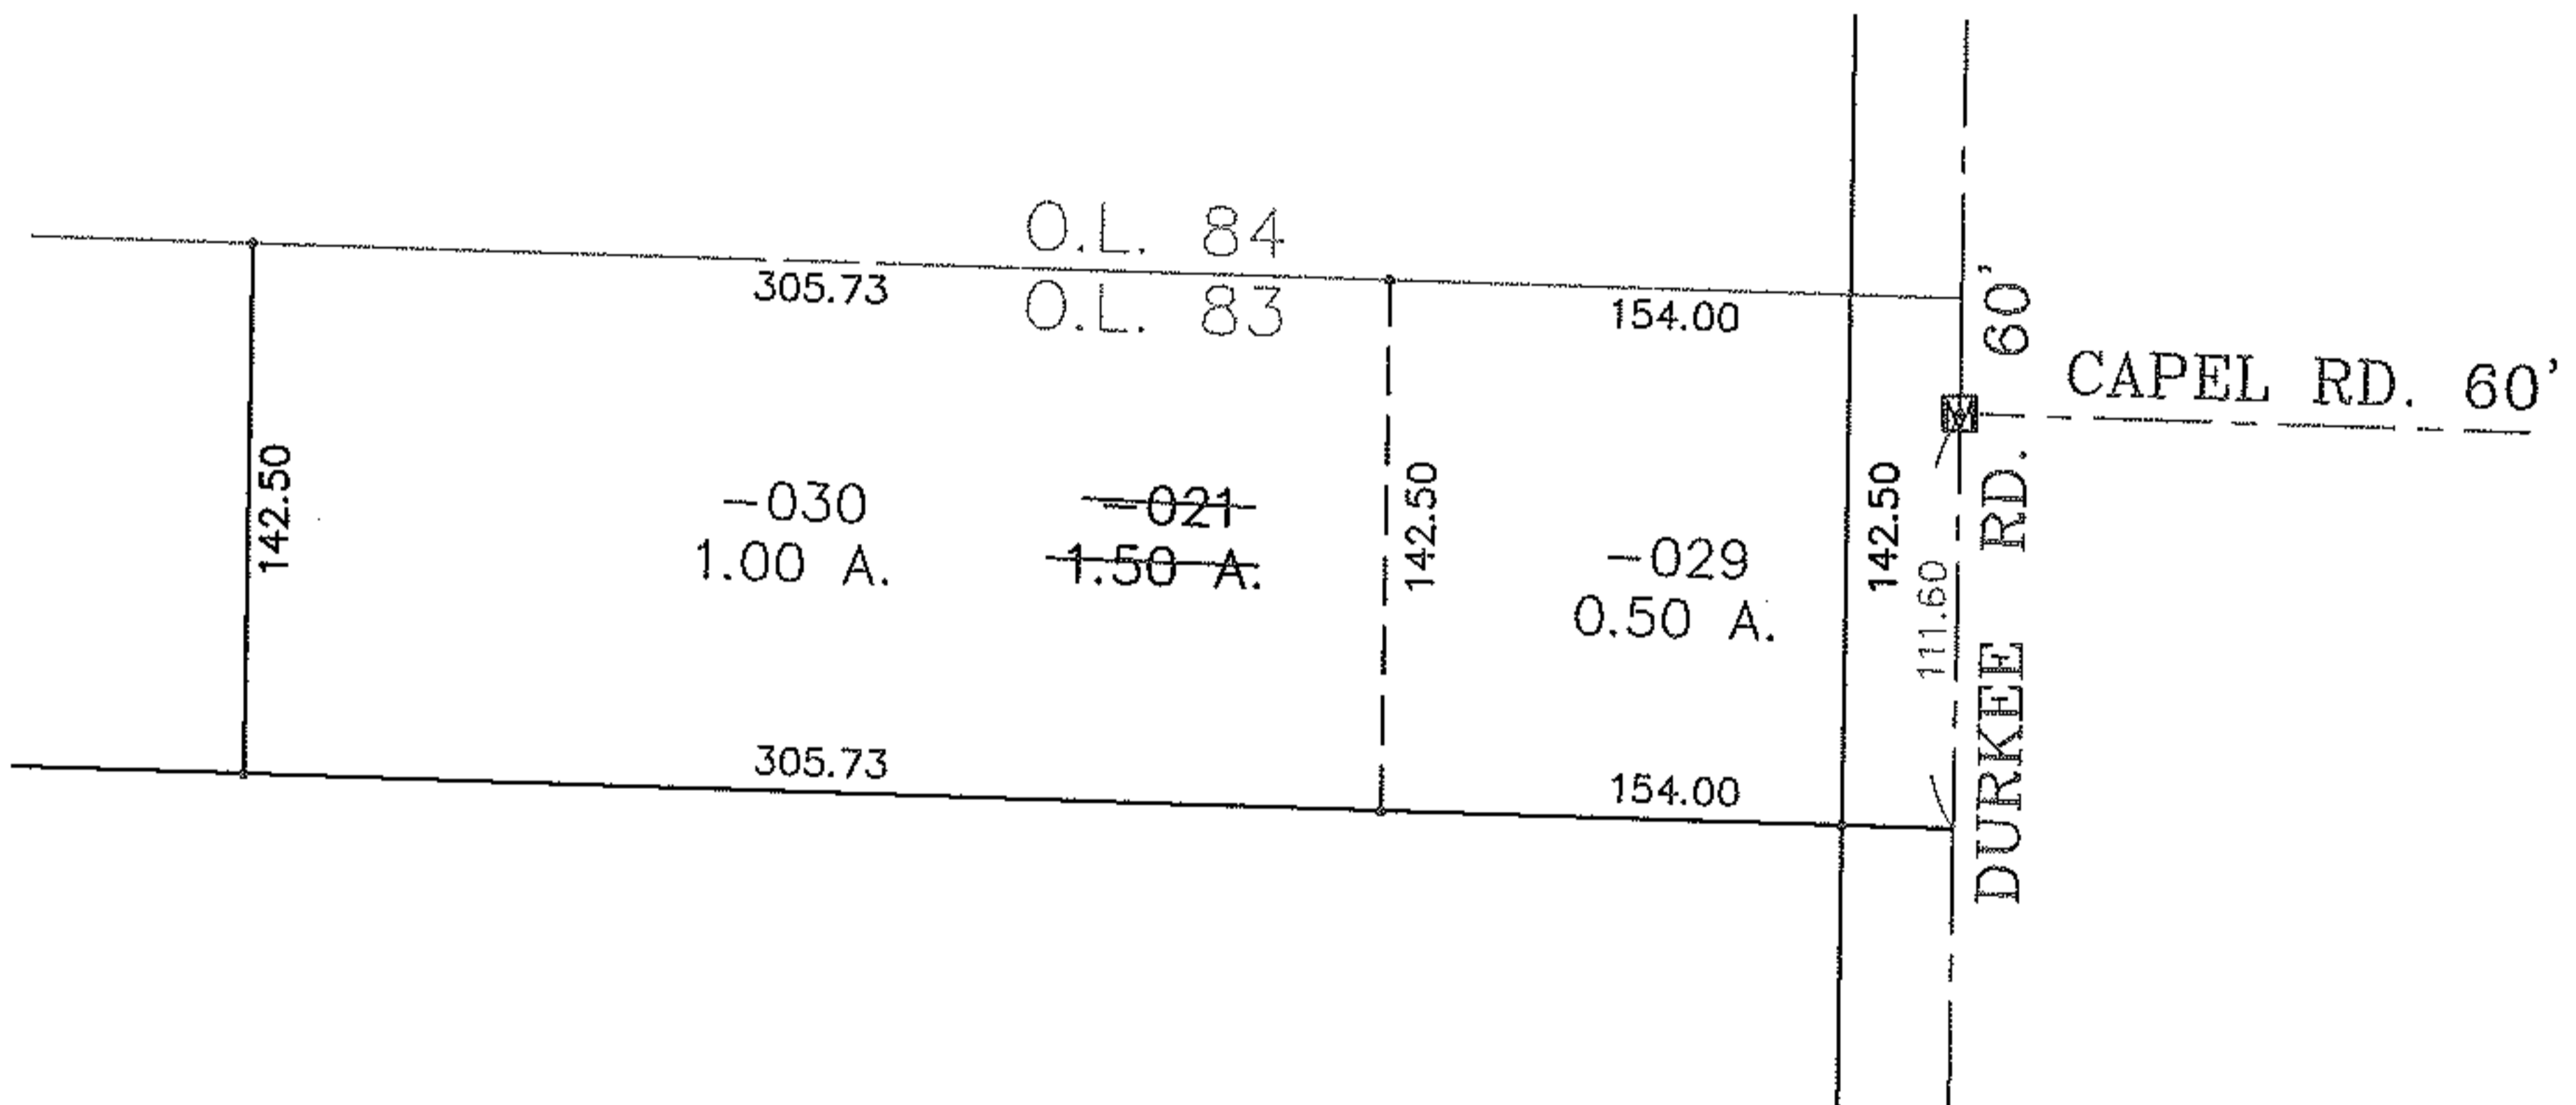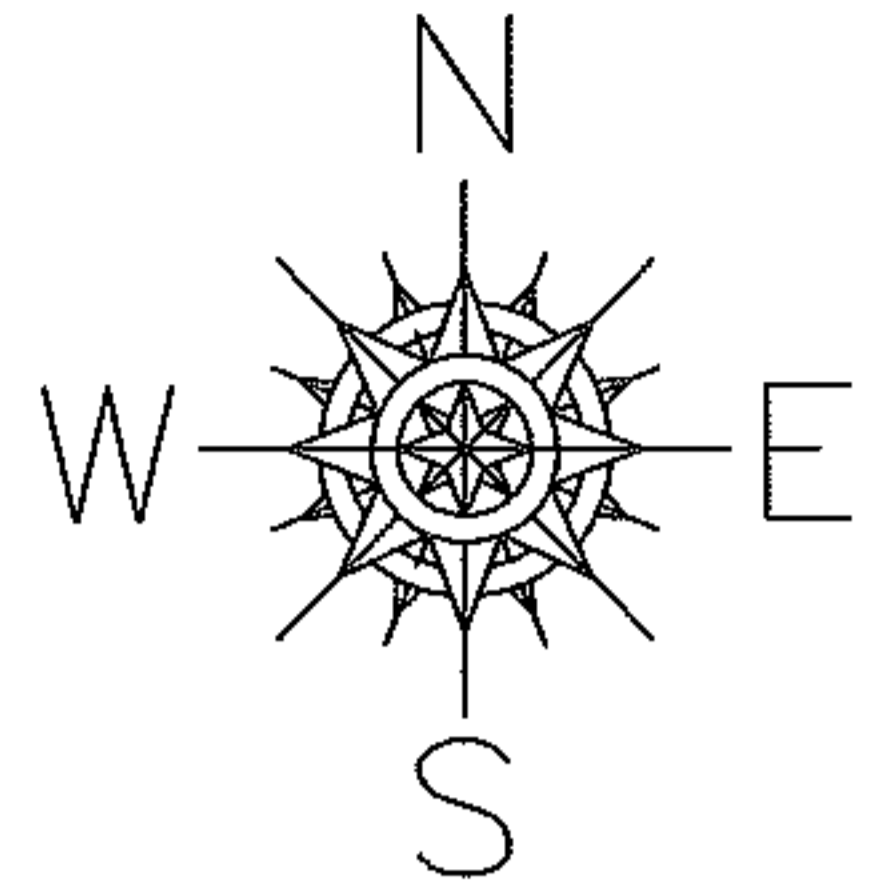

SPLITS/DEEDS PROCESSED

LORAIN COUNTY TAX MAP DEPARTMENT
226 MIDDLE AVE. ELYRIA, OHIO

SURVEYED BY: GARY W. PENFOUND

CLOSURE: 0.00 : 10.000

MAP PAGE(S): 11-00-083

APPROVED BY: TJS DATE: 4/16/14

SCALE: 1" = 100 PRIOR INSTRUMENT: 20020868998