

PARENT PARCEL: 12-00-047-103-012

CHILD PARCEL: 12-00-047-630-002

STARTING POINT: XXXXXX




14-02924-A

ADD TO DUPLICATE

12-00-047-630-002

10 X 10

API# 34093212700

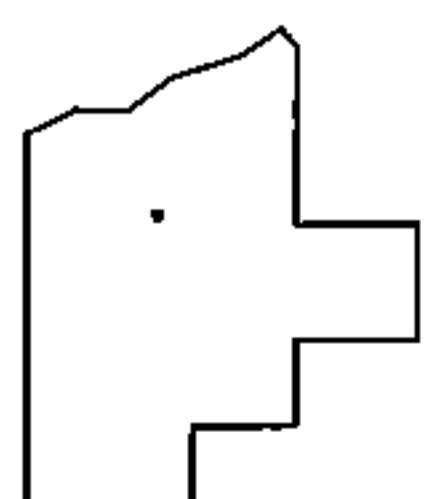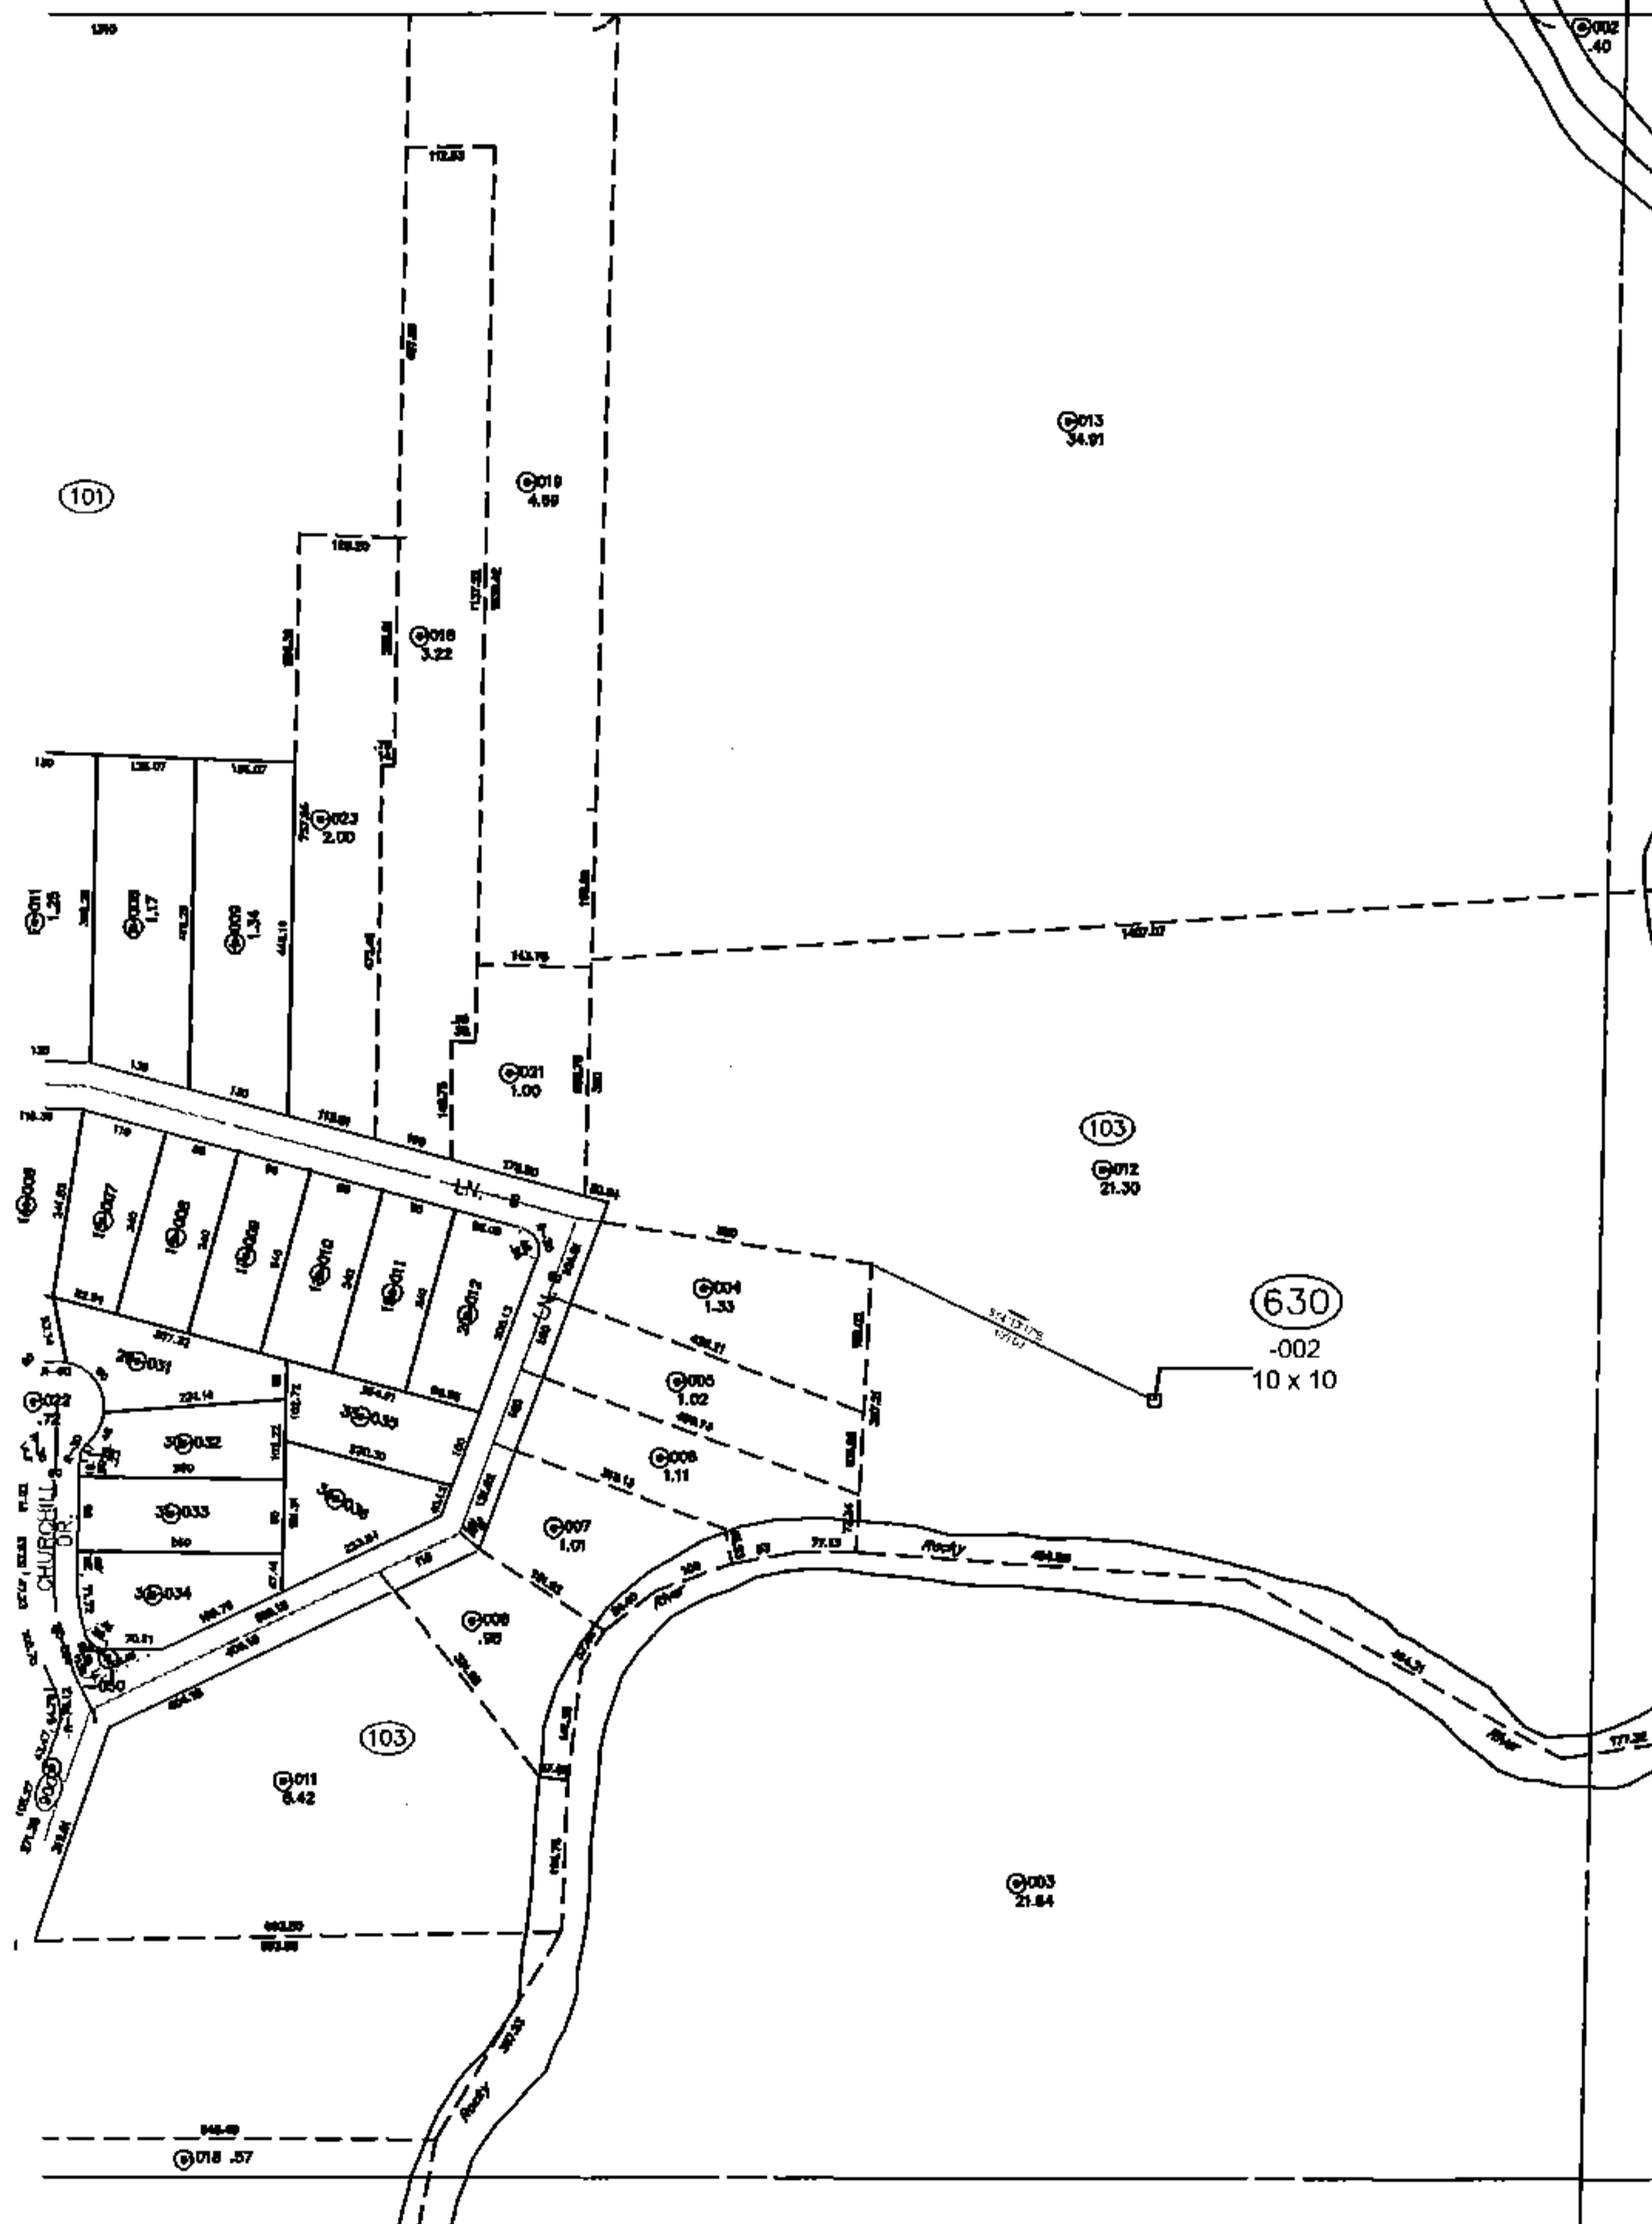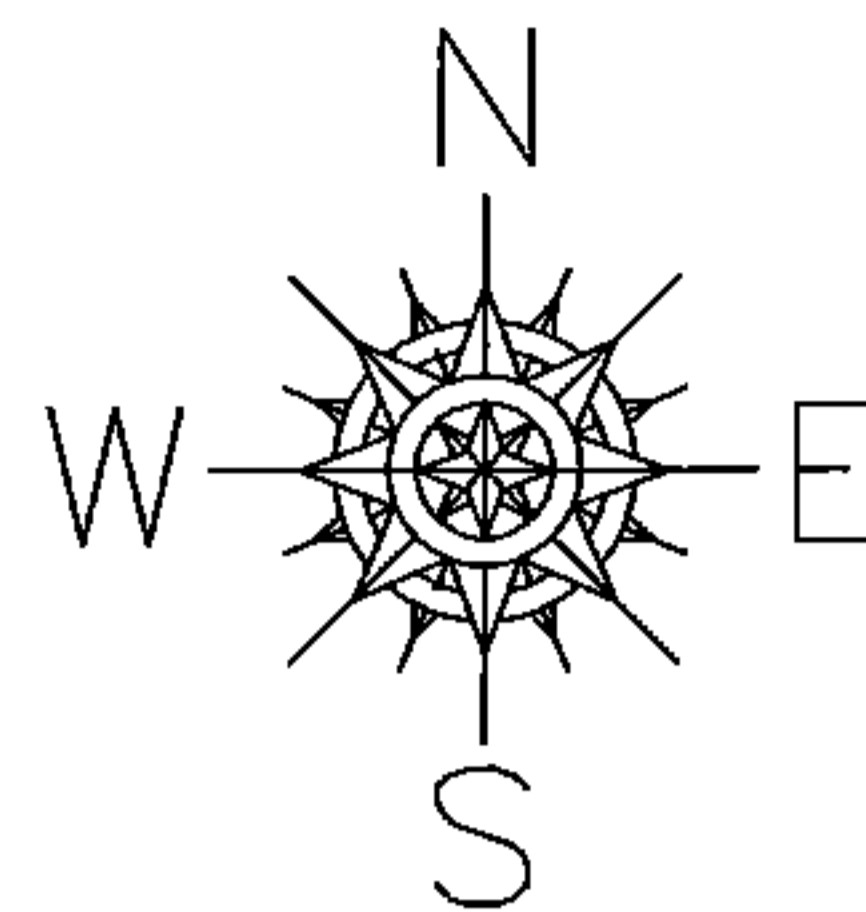

SPLITS/DEEDS PROCESSED
LORAIN COUNTY TAX MAP DEPARTMENT
226 MIDDLE AVE. ELYRIA, OHIO

SURVEYED BY: NA
CLOSURE: NA
MAP PAGE(S): 12-00-047
APPROVED BY: TJS DATE: 4/16/14
SCALE: 1" = 400 PRIOR INSTRUMENT: NA