


RASTER

PARENT PARCEL: 03-00-055-121-006



CHILD PARCEL: 03-00-055-121-033, -034

STARTING POINT: CENTERLINE OF COLORADO AVE & O.L. 55

11-02924

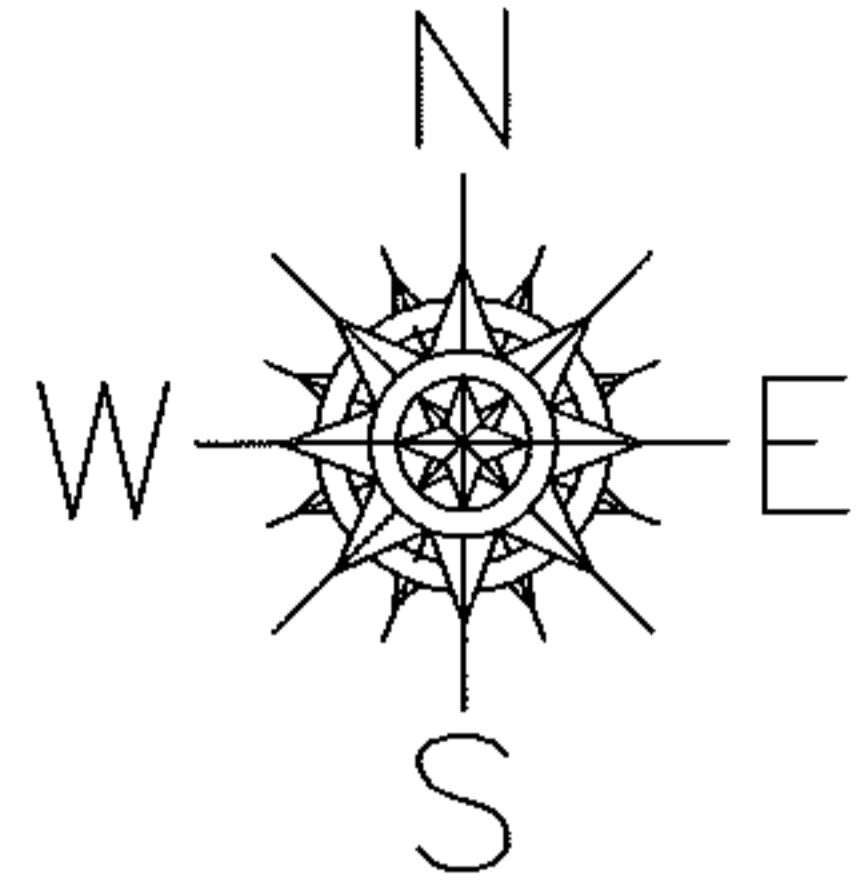

COLORADO AVE

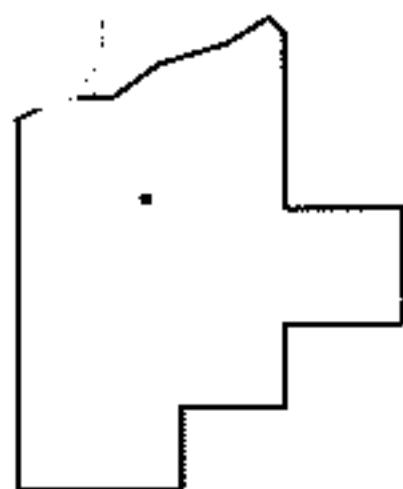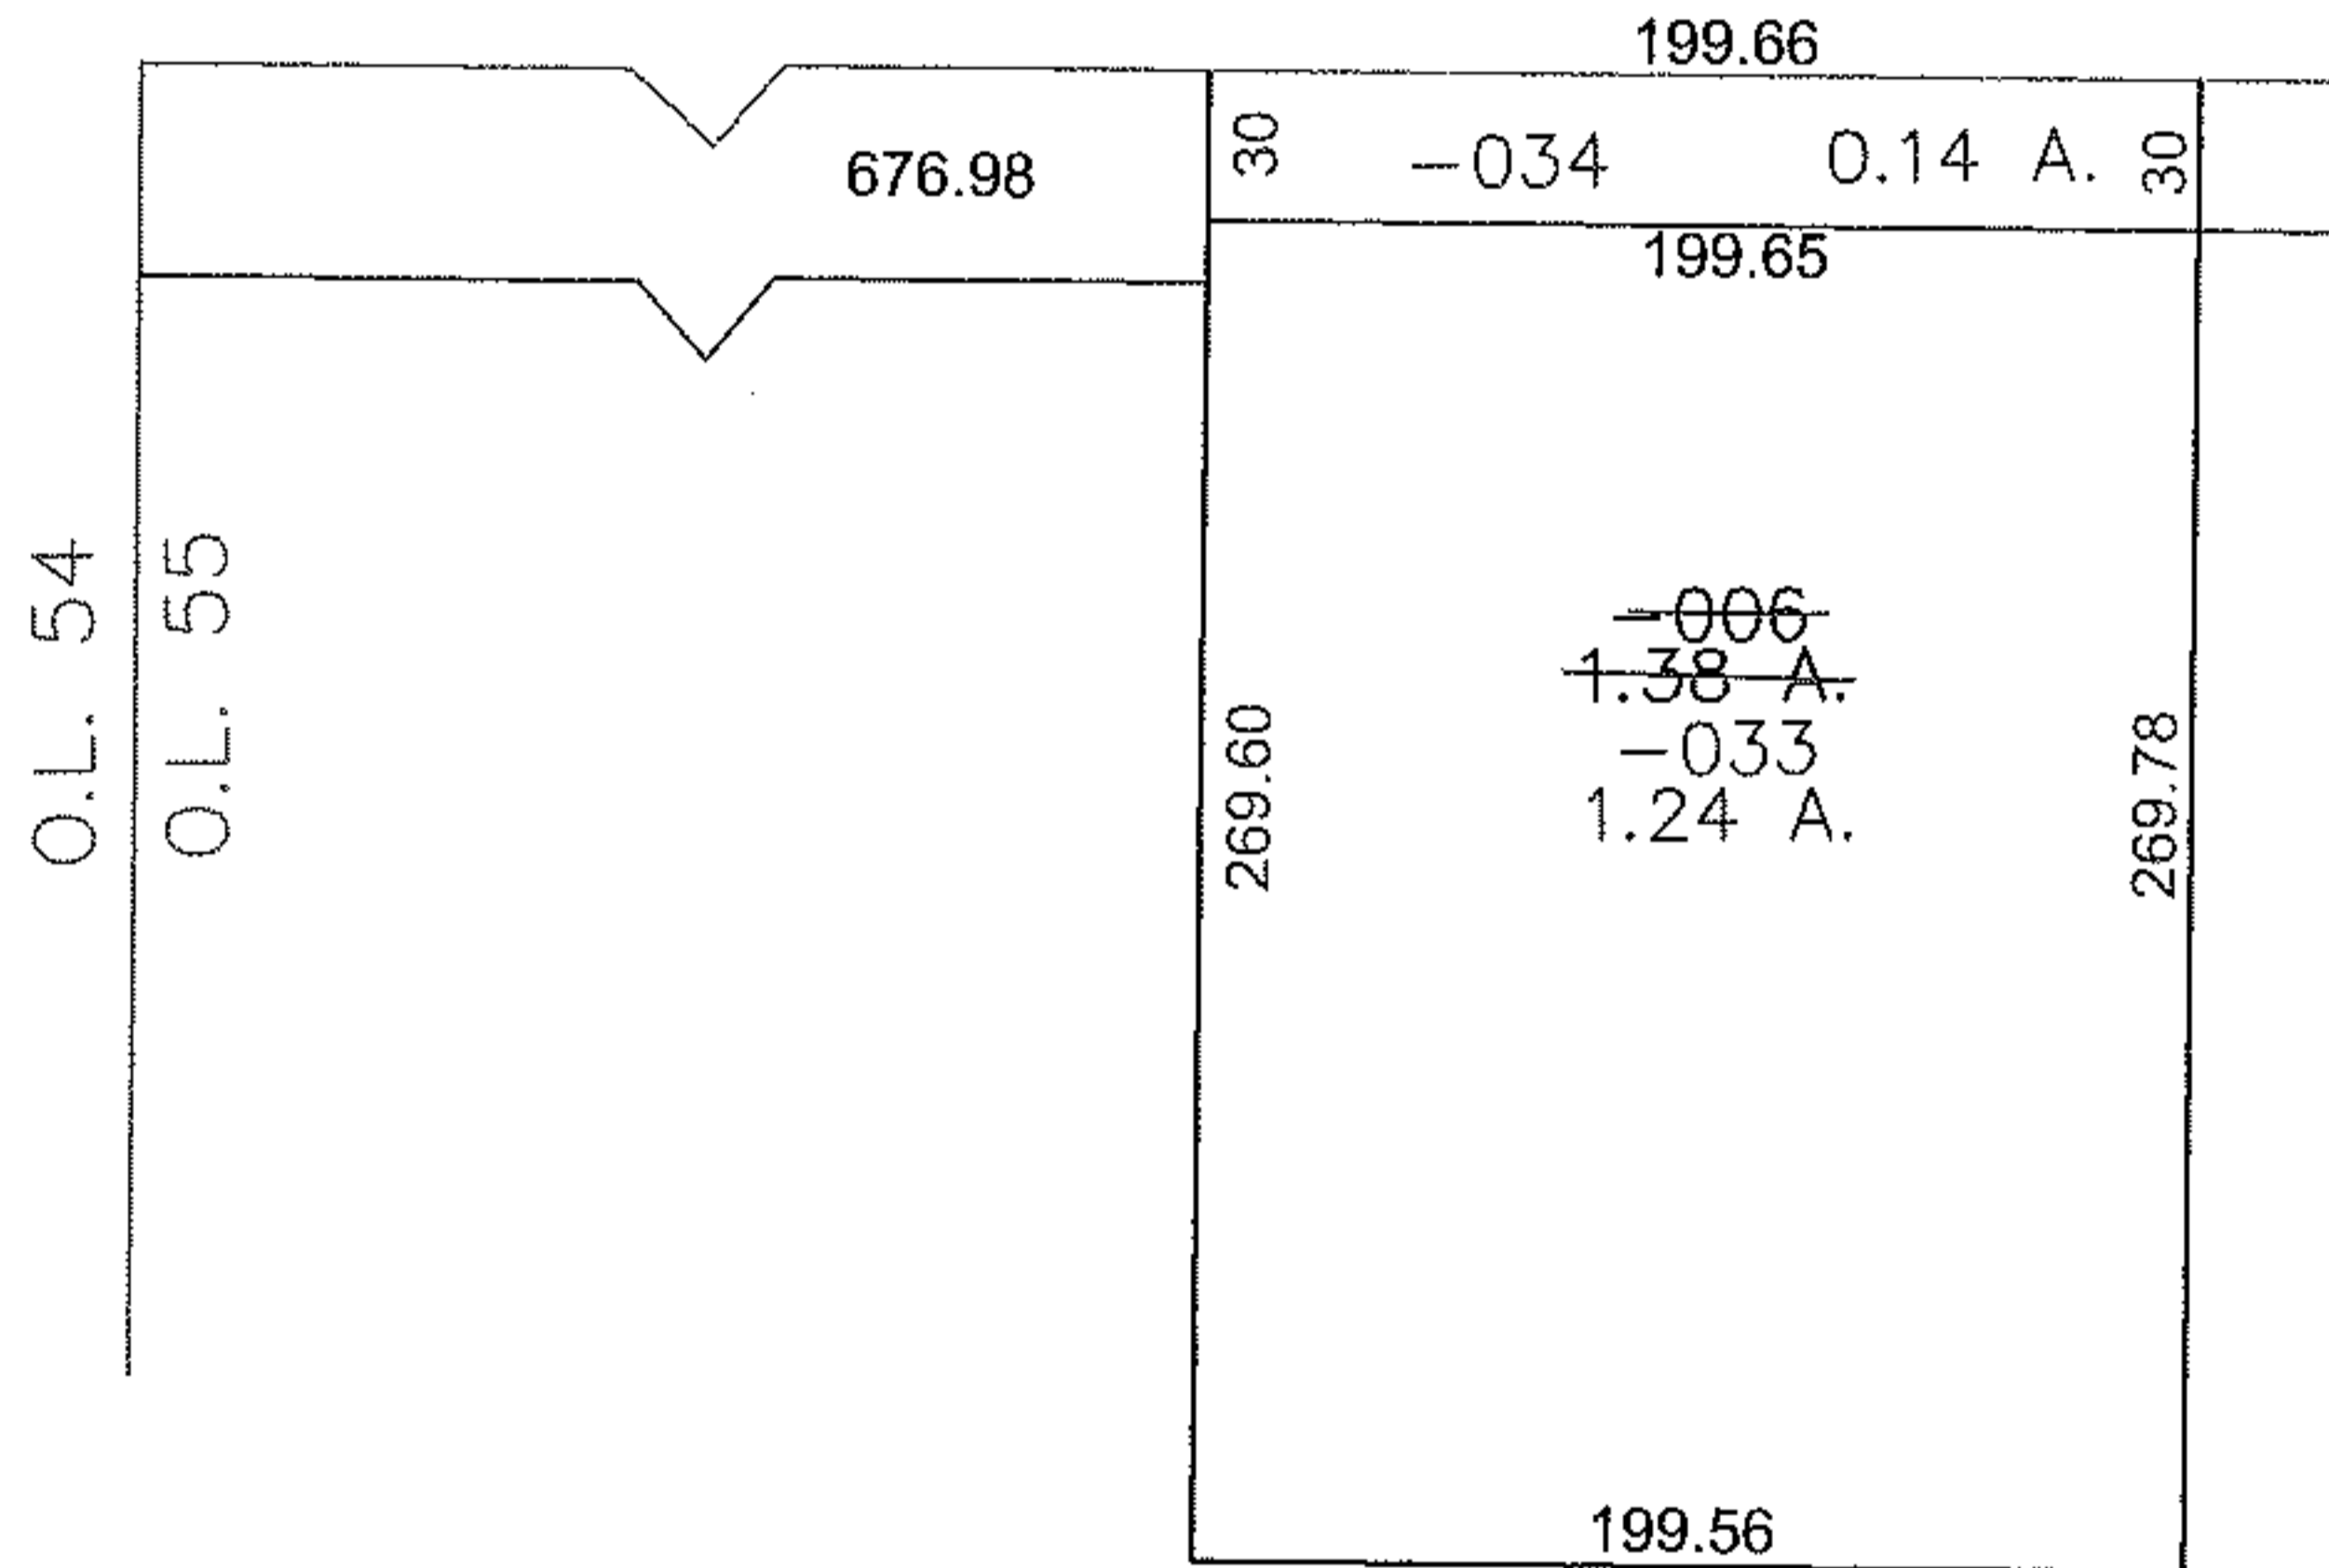

SPLITS/DEEDS PROCESSED

LORAIN COUNTY TAX MAP DEPARTMENT
226 MIDDLE AVE. ELYRIA, OHIO

SURVEYED BY: JOAN BOLSER

CLOSURE: 0.00 : 10.000

MAP PAGE(S): 03-00-055-A

APPROVED BY: JAH DATE: 5-19-2011

SCALE: 1" = 100 PRIOR INSTRUMENT: 20040047141