




RASTER

PARENT PARCEL: 01-00-039-000-040

CHILD PARCEL: 01-00-039-000-062, -063 01-00-040-000-031

STARTING POINT: CENTERLINE OF NORTH RIDGE RD & O.L. 39

11-02925

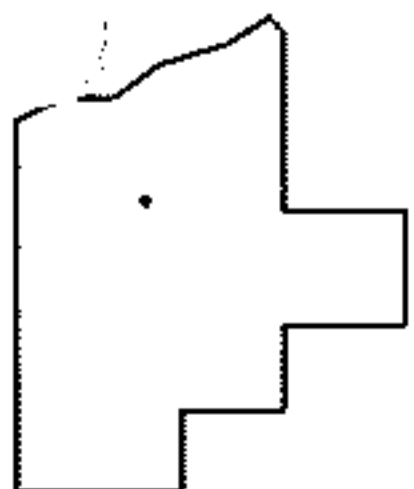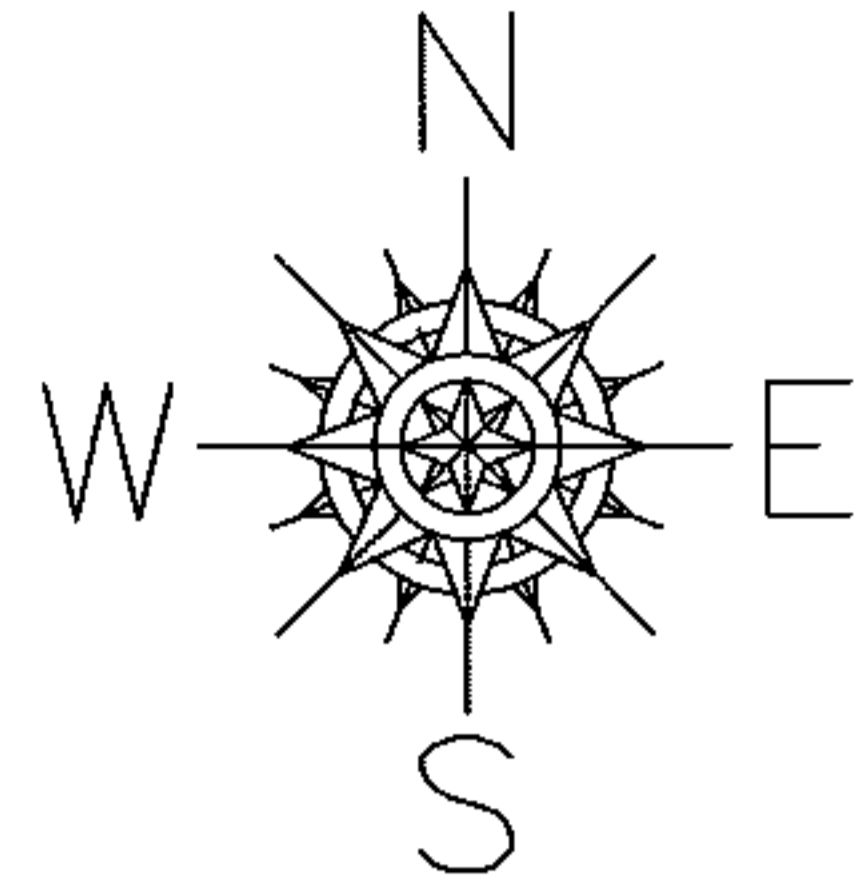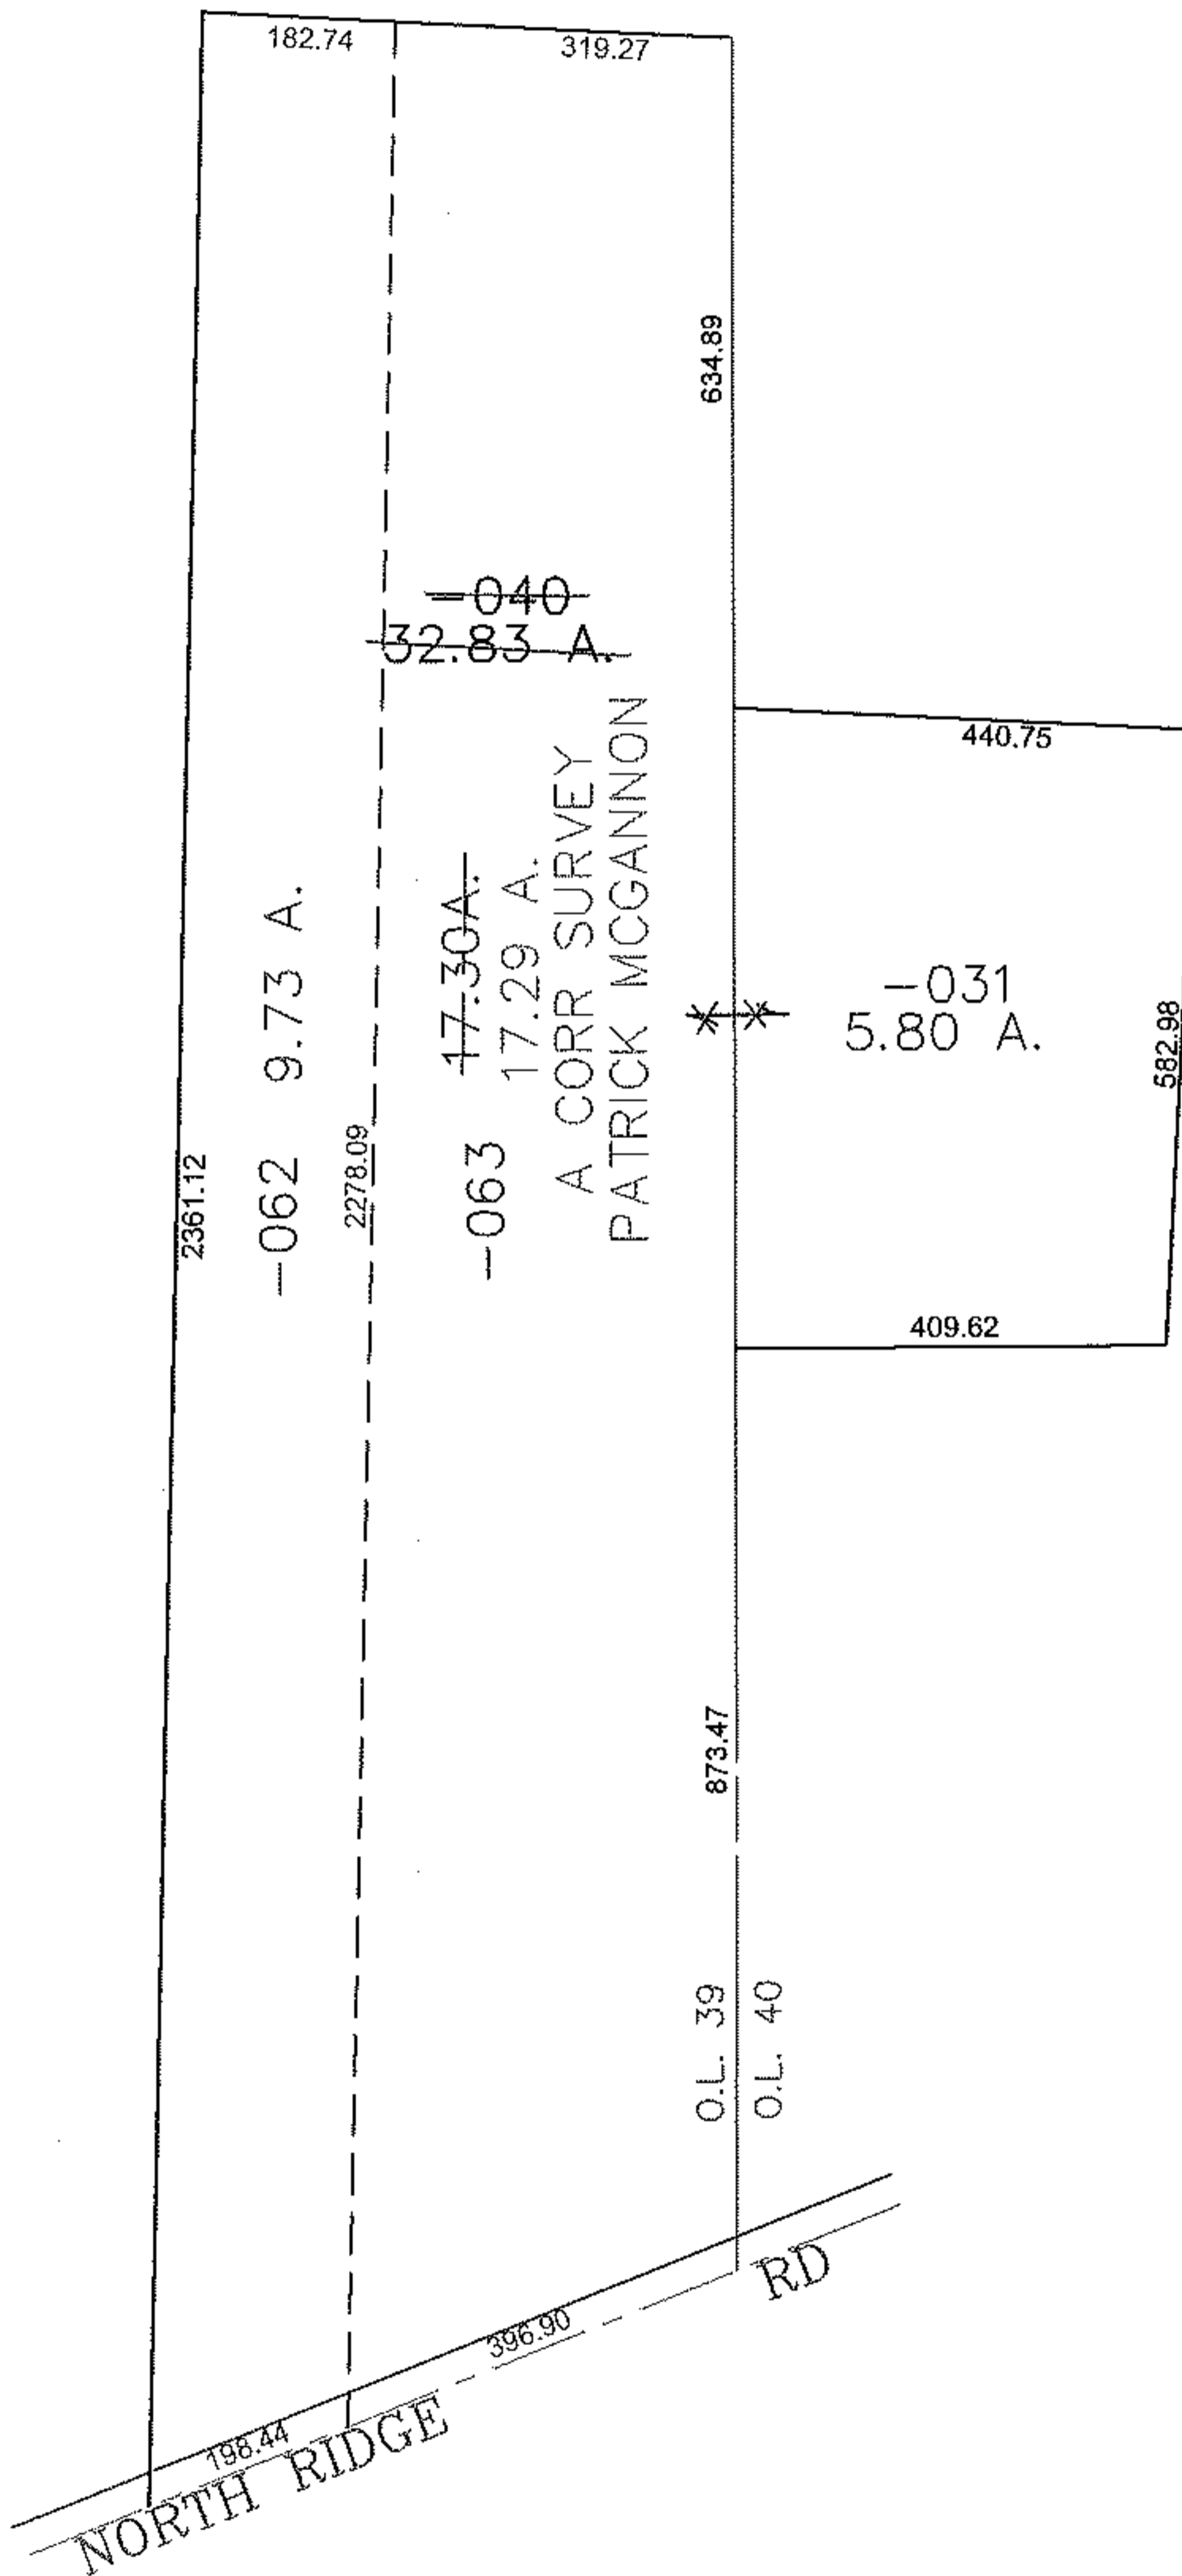

**SPLITS/DEEDS PROCESSED**

LORAIN COUNTY TAX MAP DEPARTMENT  
226 MIDDLE AVE. ELYRIA, OHIO

SURVEYED BY: PATRICK MCGANNON

CLOSURE: 0.00 : 10.000

MAP PAGE(S): 1-H

APPROVED BY: JAH DATE: 7-13-2011

SCALE: 1" = 300 PRIOR INSTRUMENT: 20000665630