




PARENT PARCEL: 16-00-052-000-001

CHILD PARCEL: _____

14-02930-A

STARTING POINT: AT A R.R.S. AT THE NORTHEAST CORNER OF O.L.53

MEDINA - ELYRIA RD. (S.R. 57)

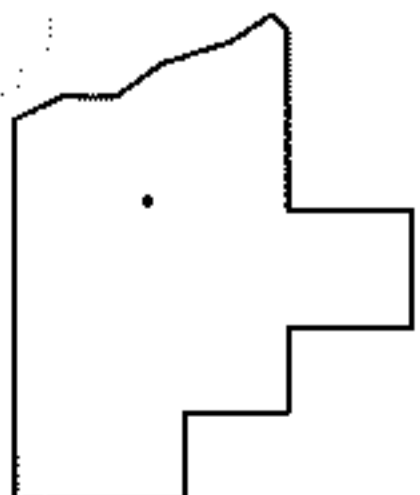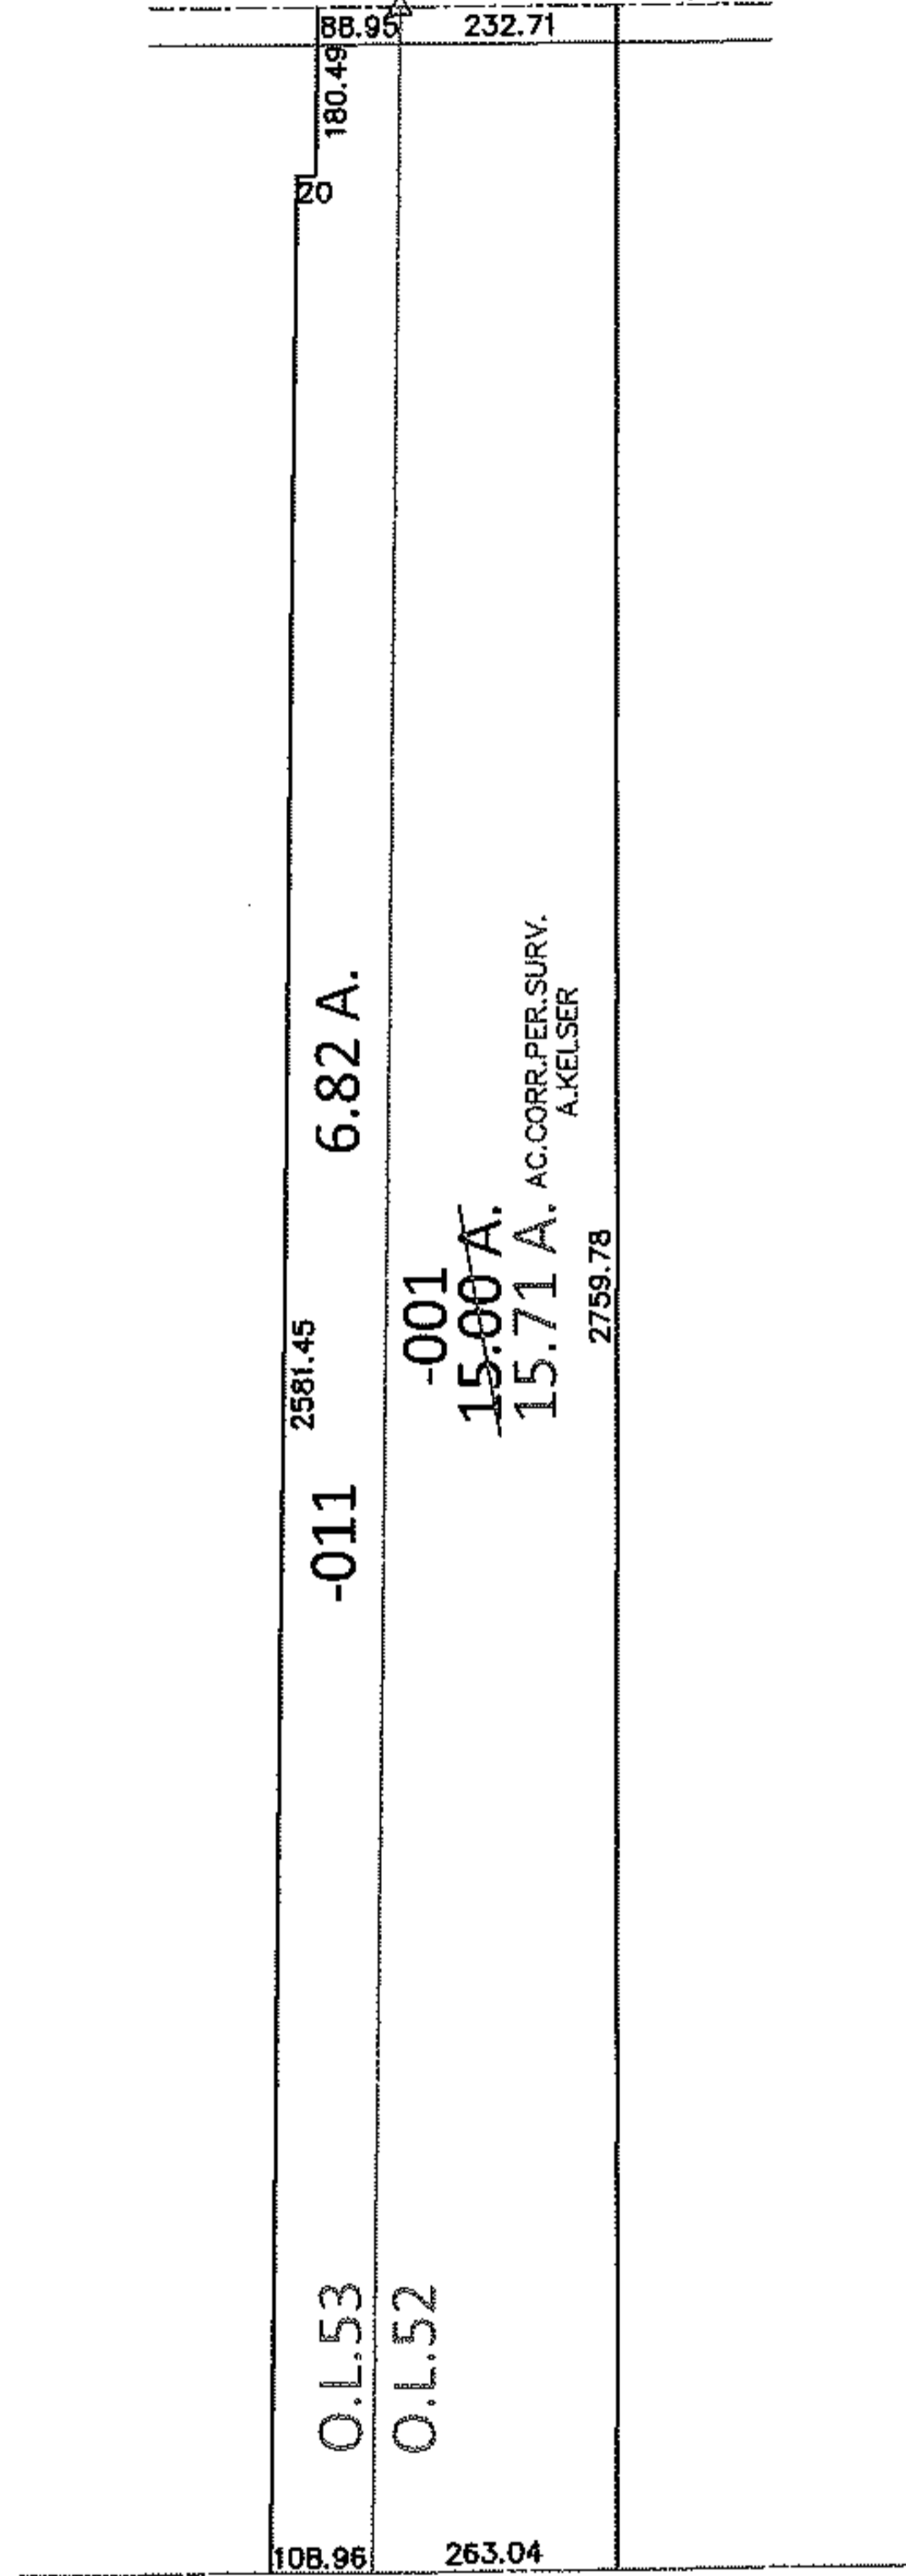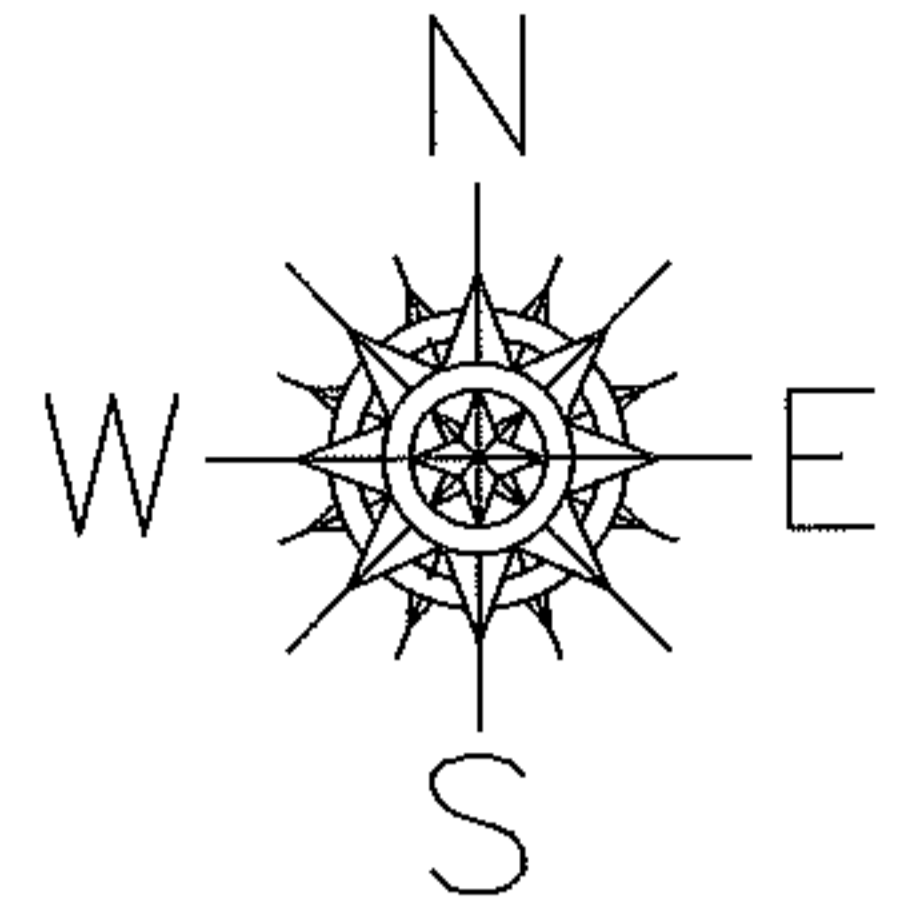

SPLITS/DEEDS PROCESSED

LORAIN COUNTY TAX MAP DEPARTMENT
226 MIDDLE AVE. ELYRIA, OHIO

SURVEYED BY: ALEX KELSER

CLOSURE: .01:10,000

MAP PAGE(S): 16-H

APPROVED BY: RRM DATE: 4-24-14

SCALE: 1" = 400 PRIOR INST.: 20140502321