
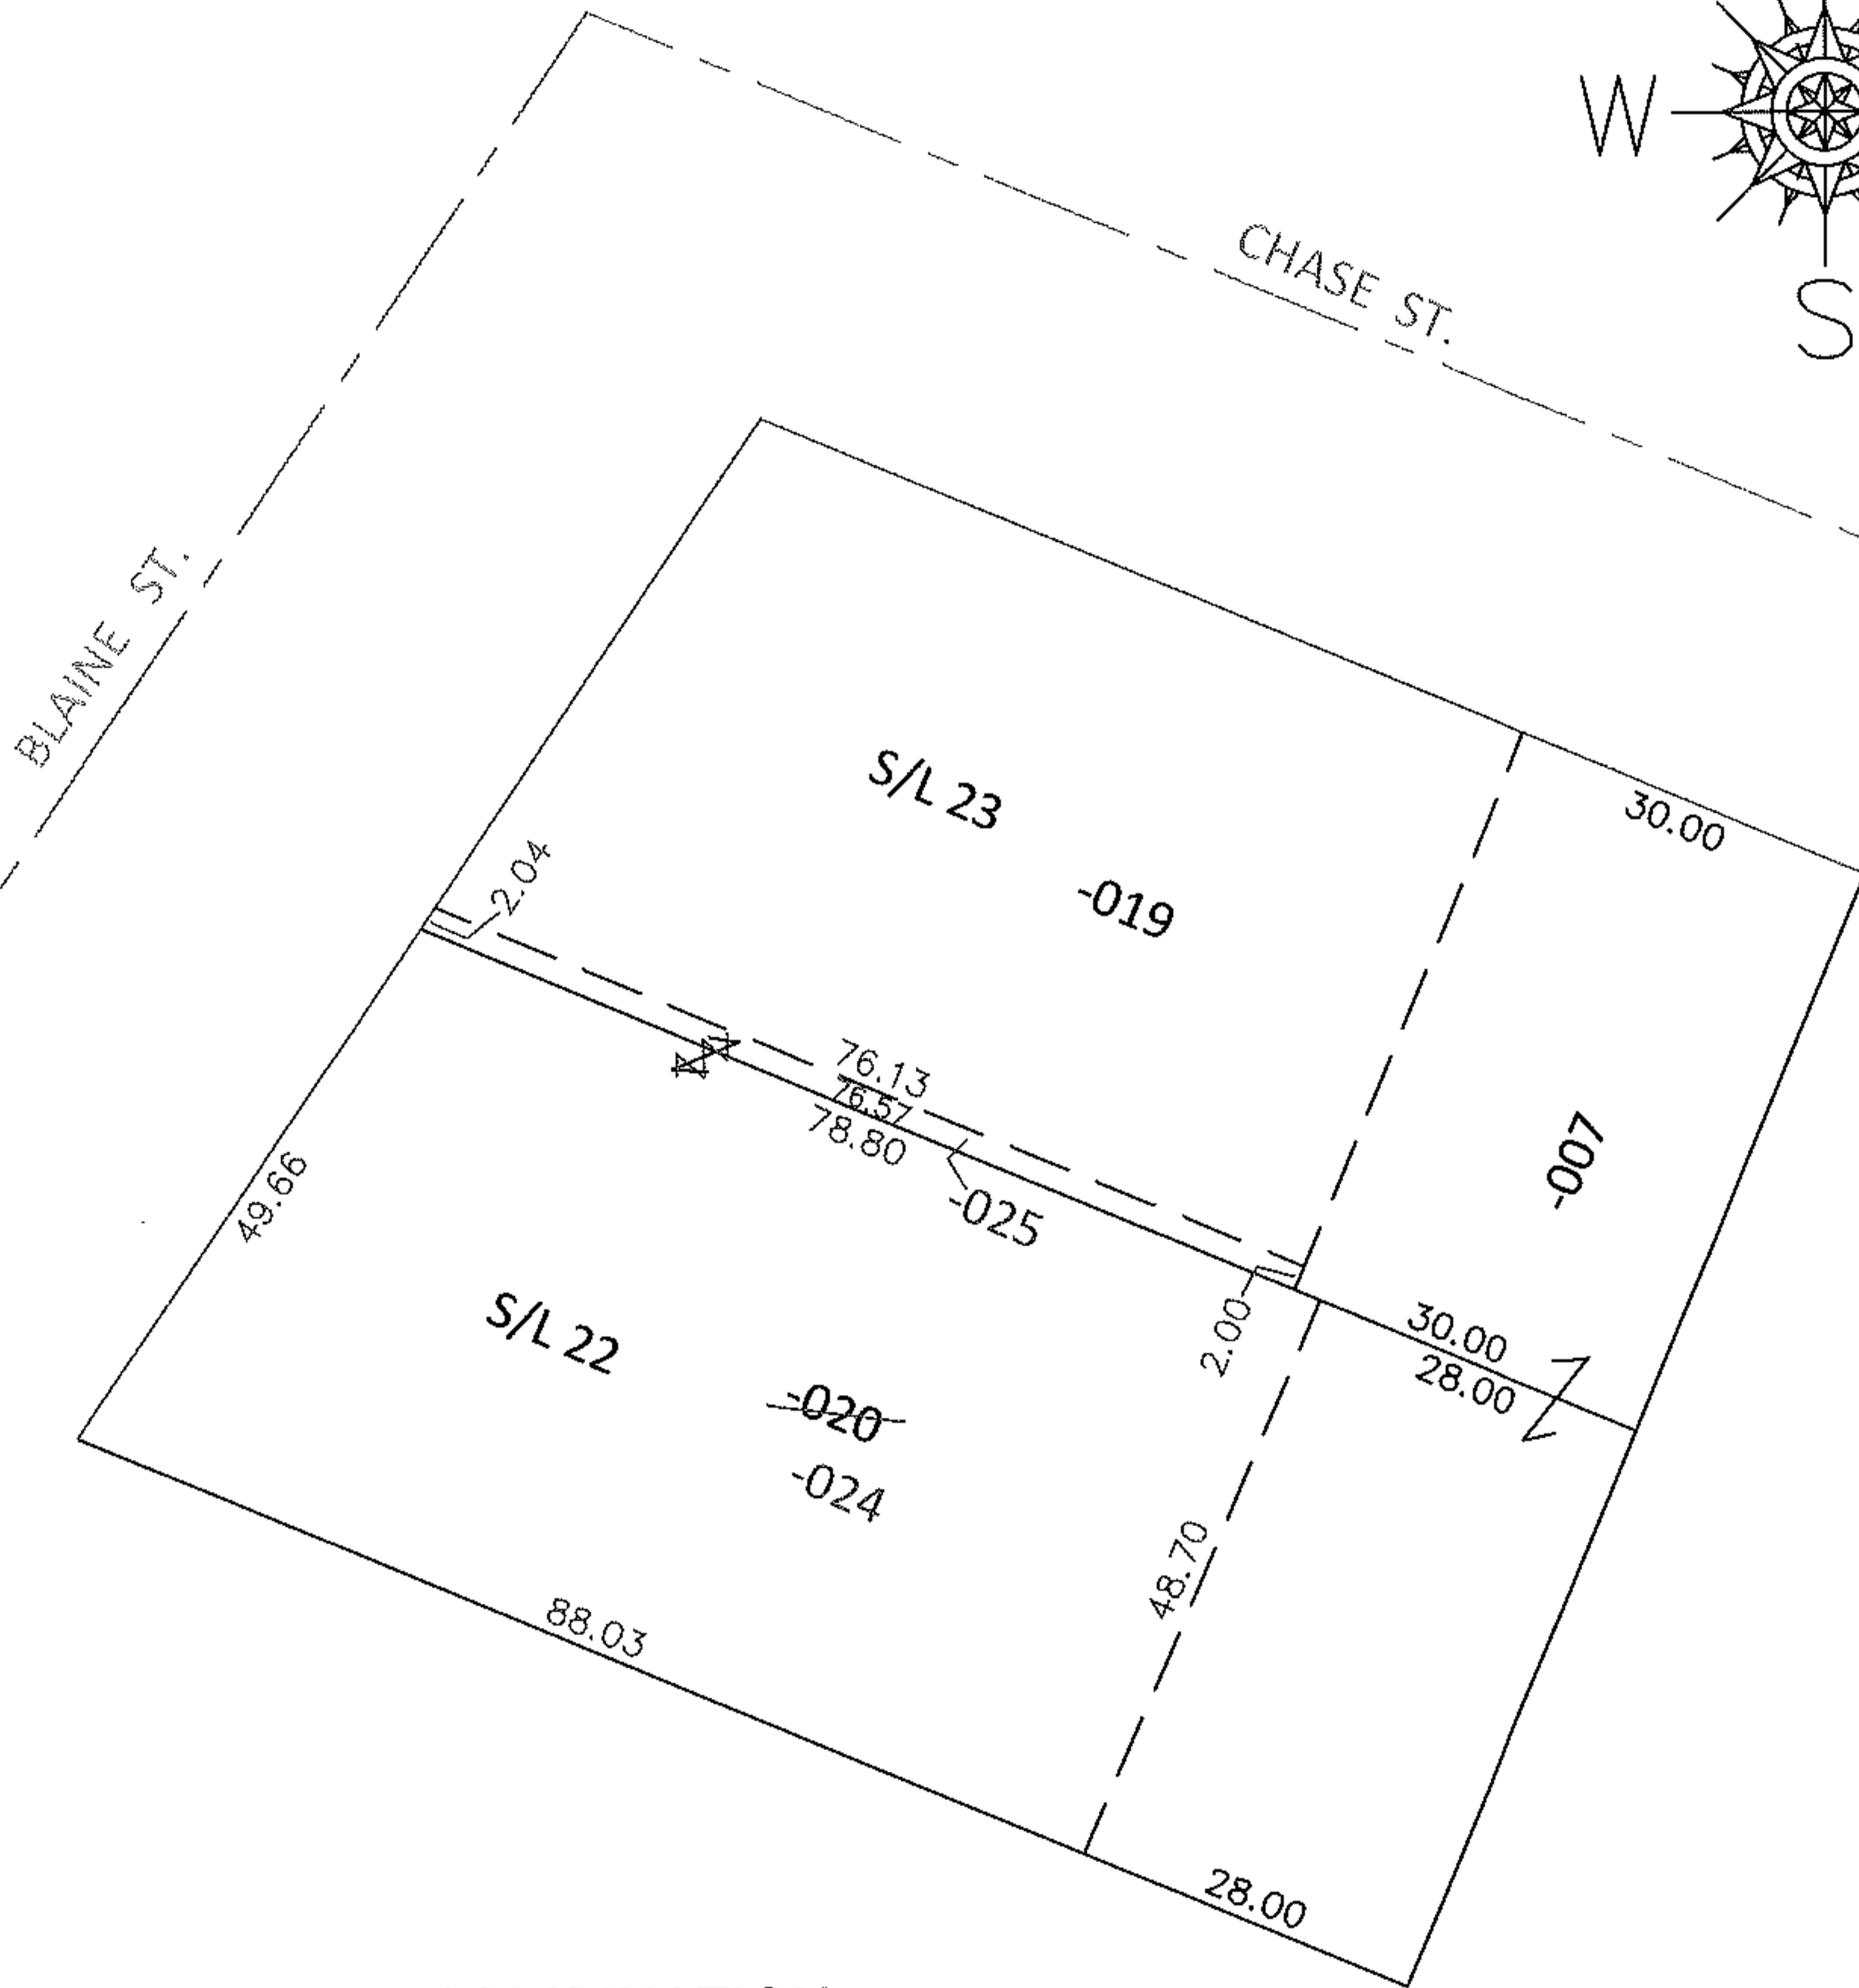


PARENT PARCEL: 06-25-102-000-020

CHILD PARCEL: 06-25-102-000-024, -025

14-02931-U

STARTING POINT: SOUTHWEST CORNER OF LOT 22 IN JOHN C. CRISP TRUSTEE SUB. (VOL.5 PG.8)

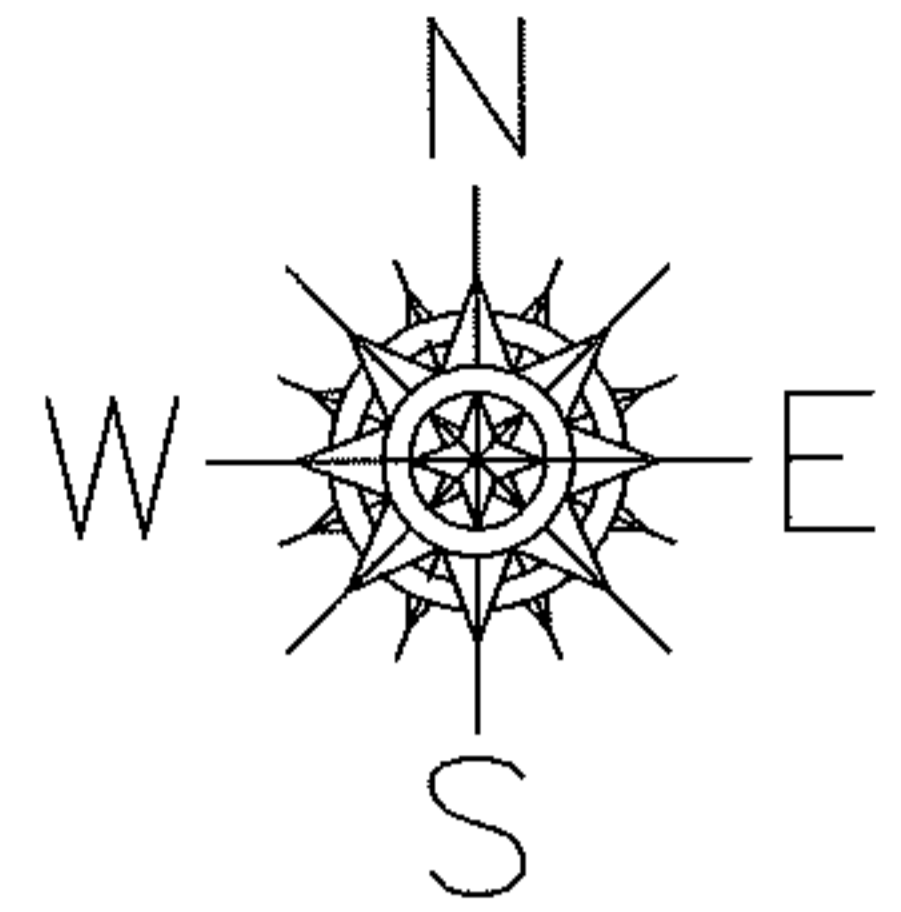


UNCOMBINATION

06-25-102-000-020

51.70 X 88.03

06-25-102-000-024	06-25-102-000-025
49.66 X 88.03	2.04 X 76.57

PER PRIOR DEEDS

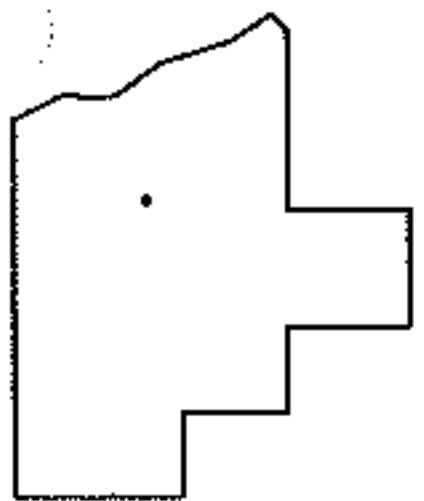

SPLITS/DEEDS PROCESSED

LORAIN COUNTY TAX MAP DEPARTMENT
226 MIDDLE AVE. ELYRIA, OHIO

SURVEYED BY: N/A

CLOSURE: N/A

MAP PAGE(S): 6-120

APPROVED BY: RRM DATE: 4-30-14

SCALE: 1"= 25' PRIOR INST.: 20130465571