




RASTER

PARENT PARCEL: 15-00-013-000-015
CHILD PARCEL: 15-00-013-000-024, -025
STARTING POINT: C/L OF WHEELER RD. AT THE NORTHWEST CORNER OF O.L. 13

11-02932

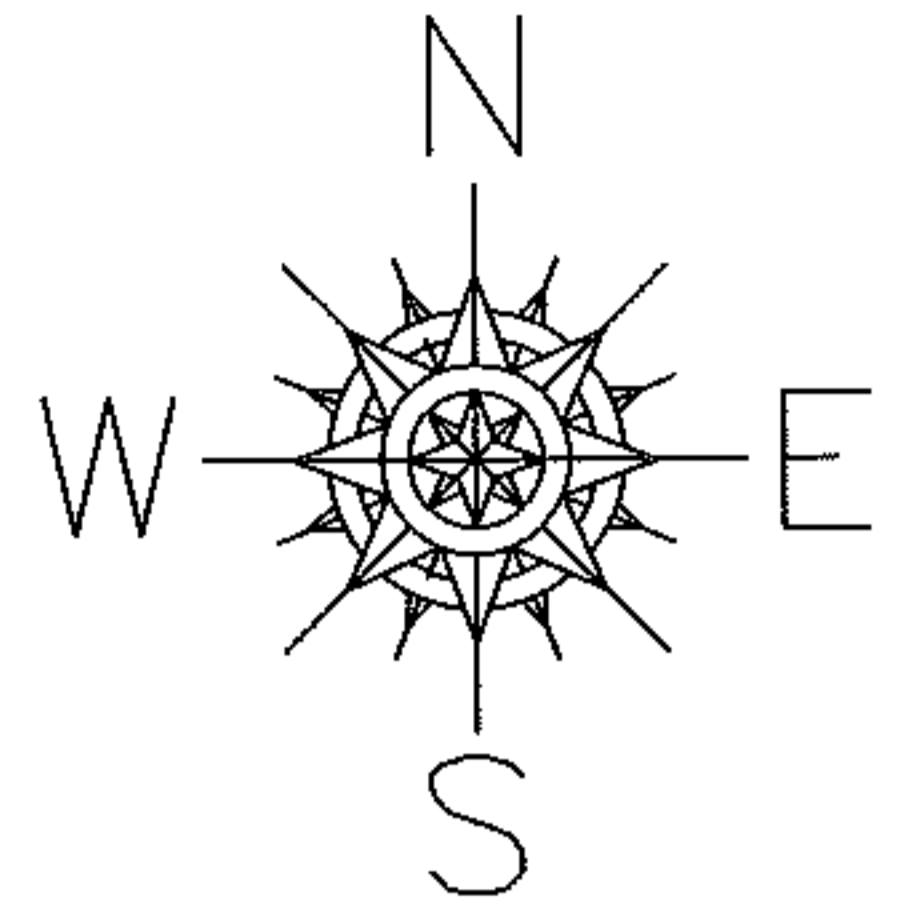

O.L.7 | O.L.8
O.L.14 | O.L.13

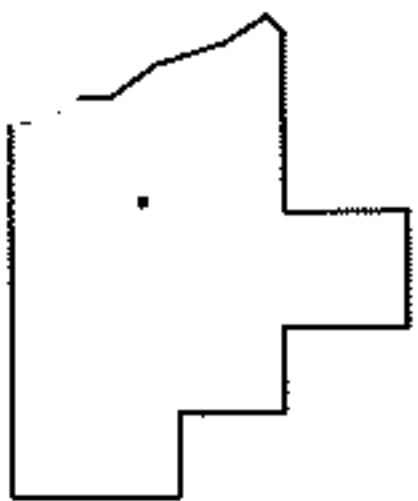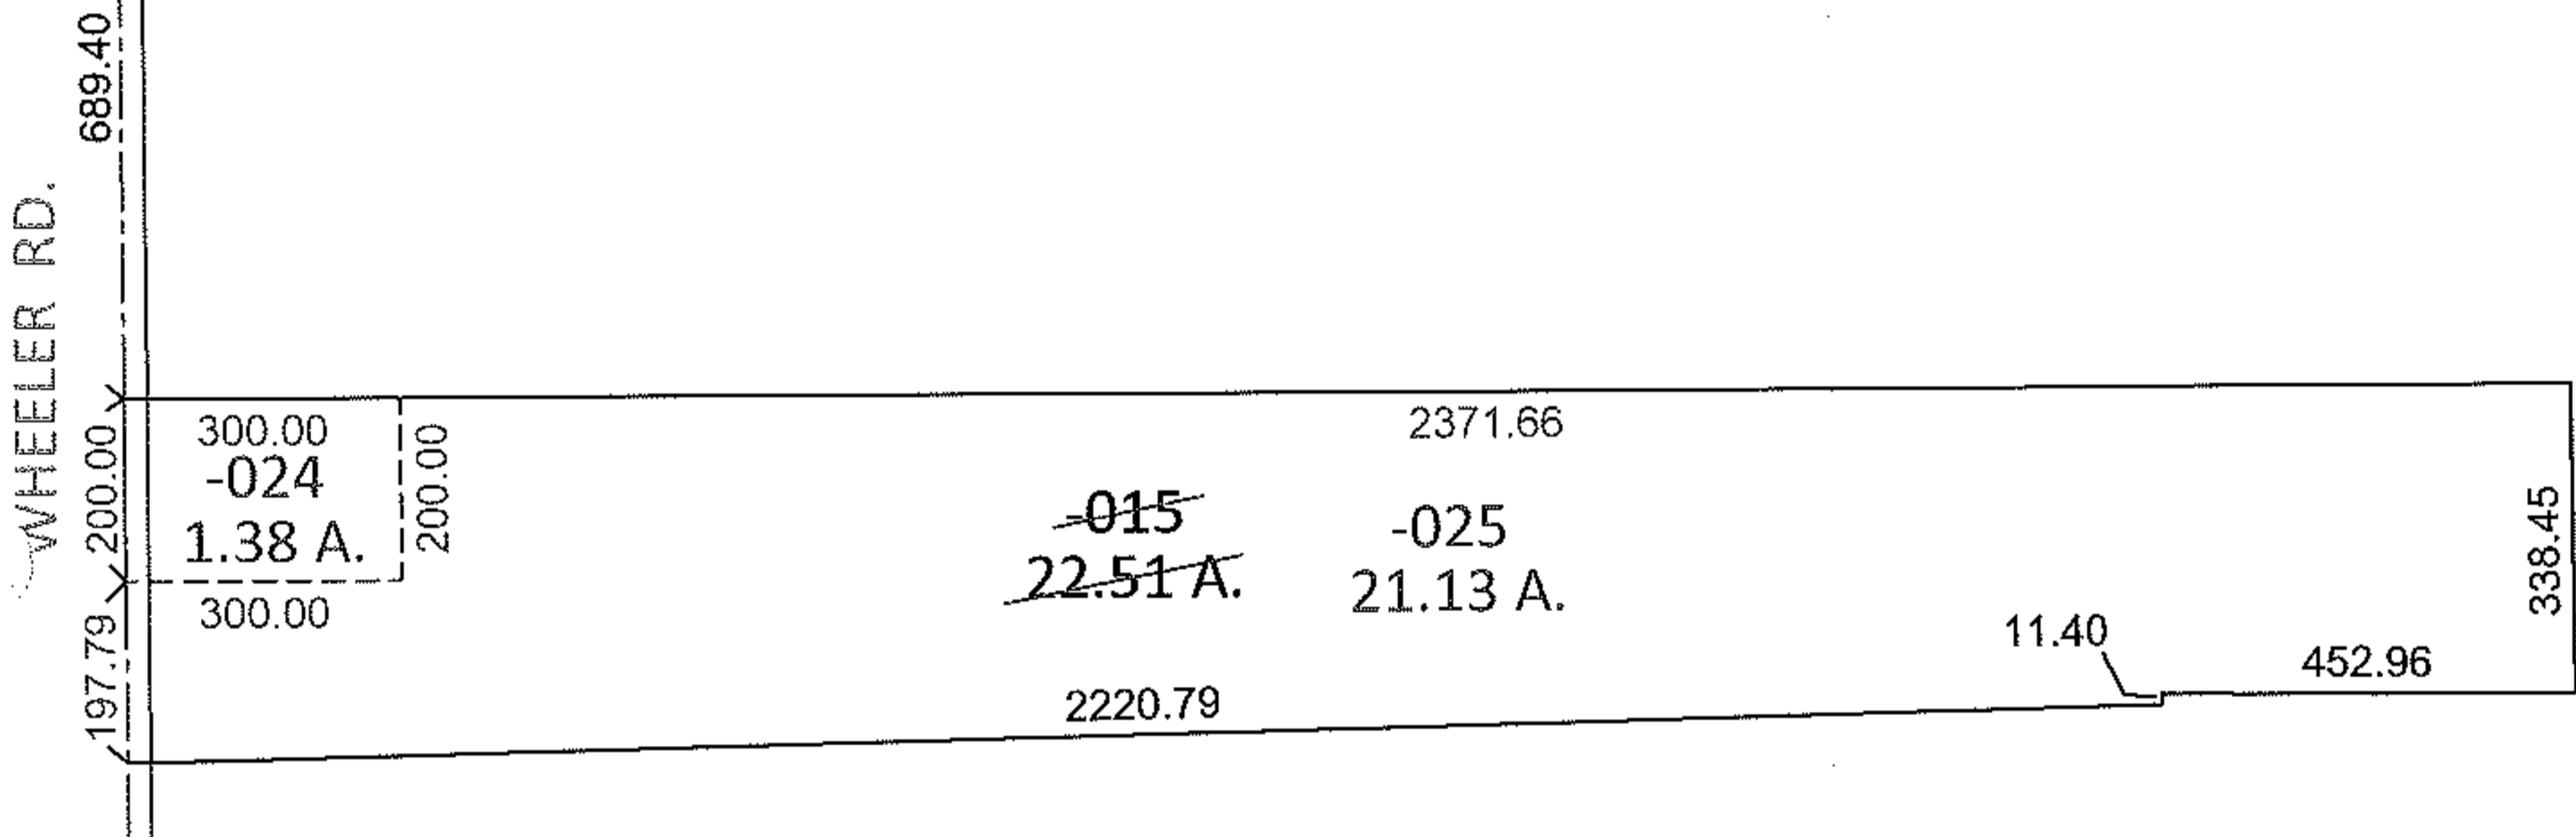

SPLITS/DEEDS PROCESSED

LORAIN COUNTY TAX MAP DEPARTMENT
226 MIDDLE AVE. ELYRIA, OHIO

SURVEYED BY: MICHAEL MACKAY
CLOSURE: .00:10,000
MAP PAGE(S): 15-D
APPROVED BY: RRM DATE: 7-28-11
SCALE: 1" = 400 PRIOR INST.: 20100323013