
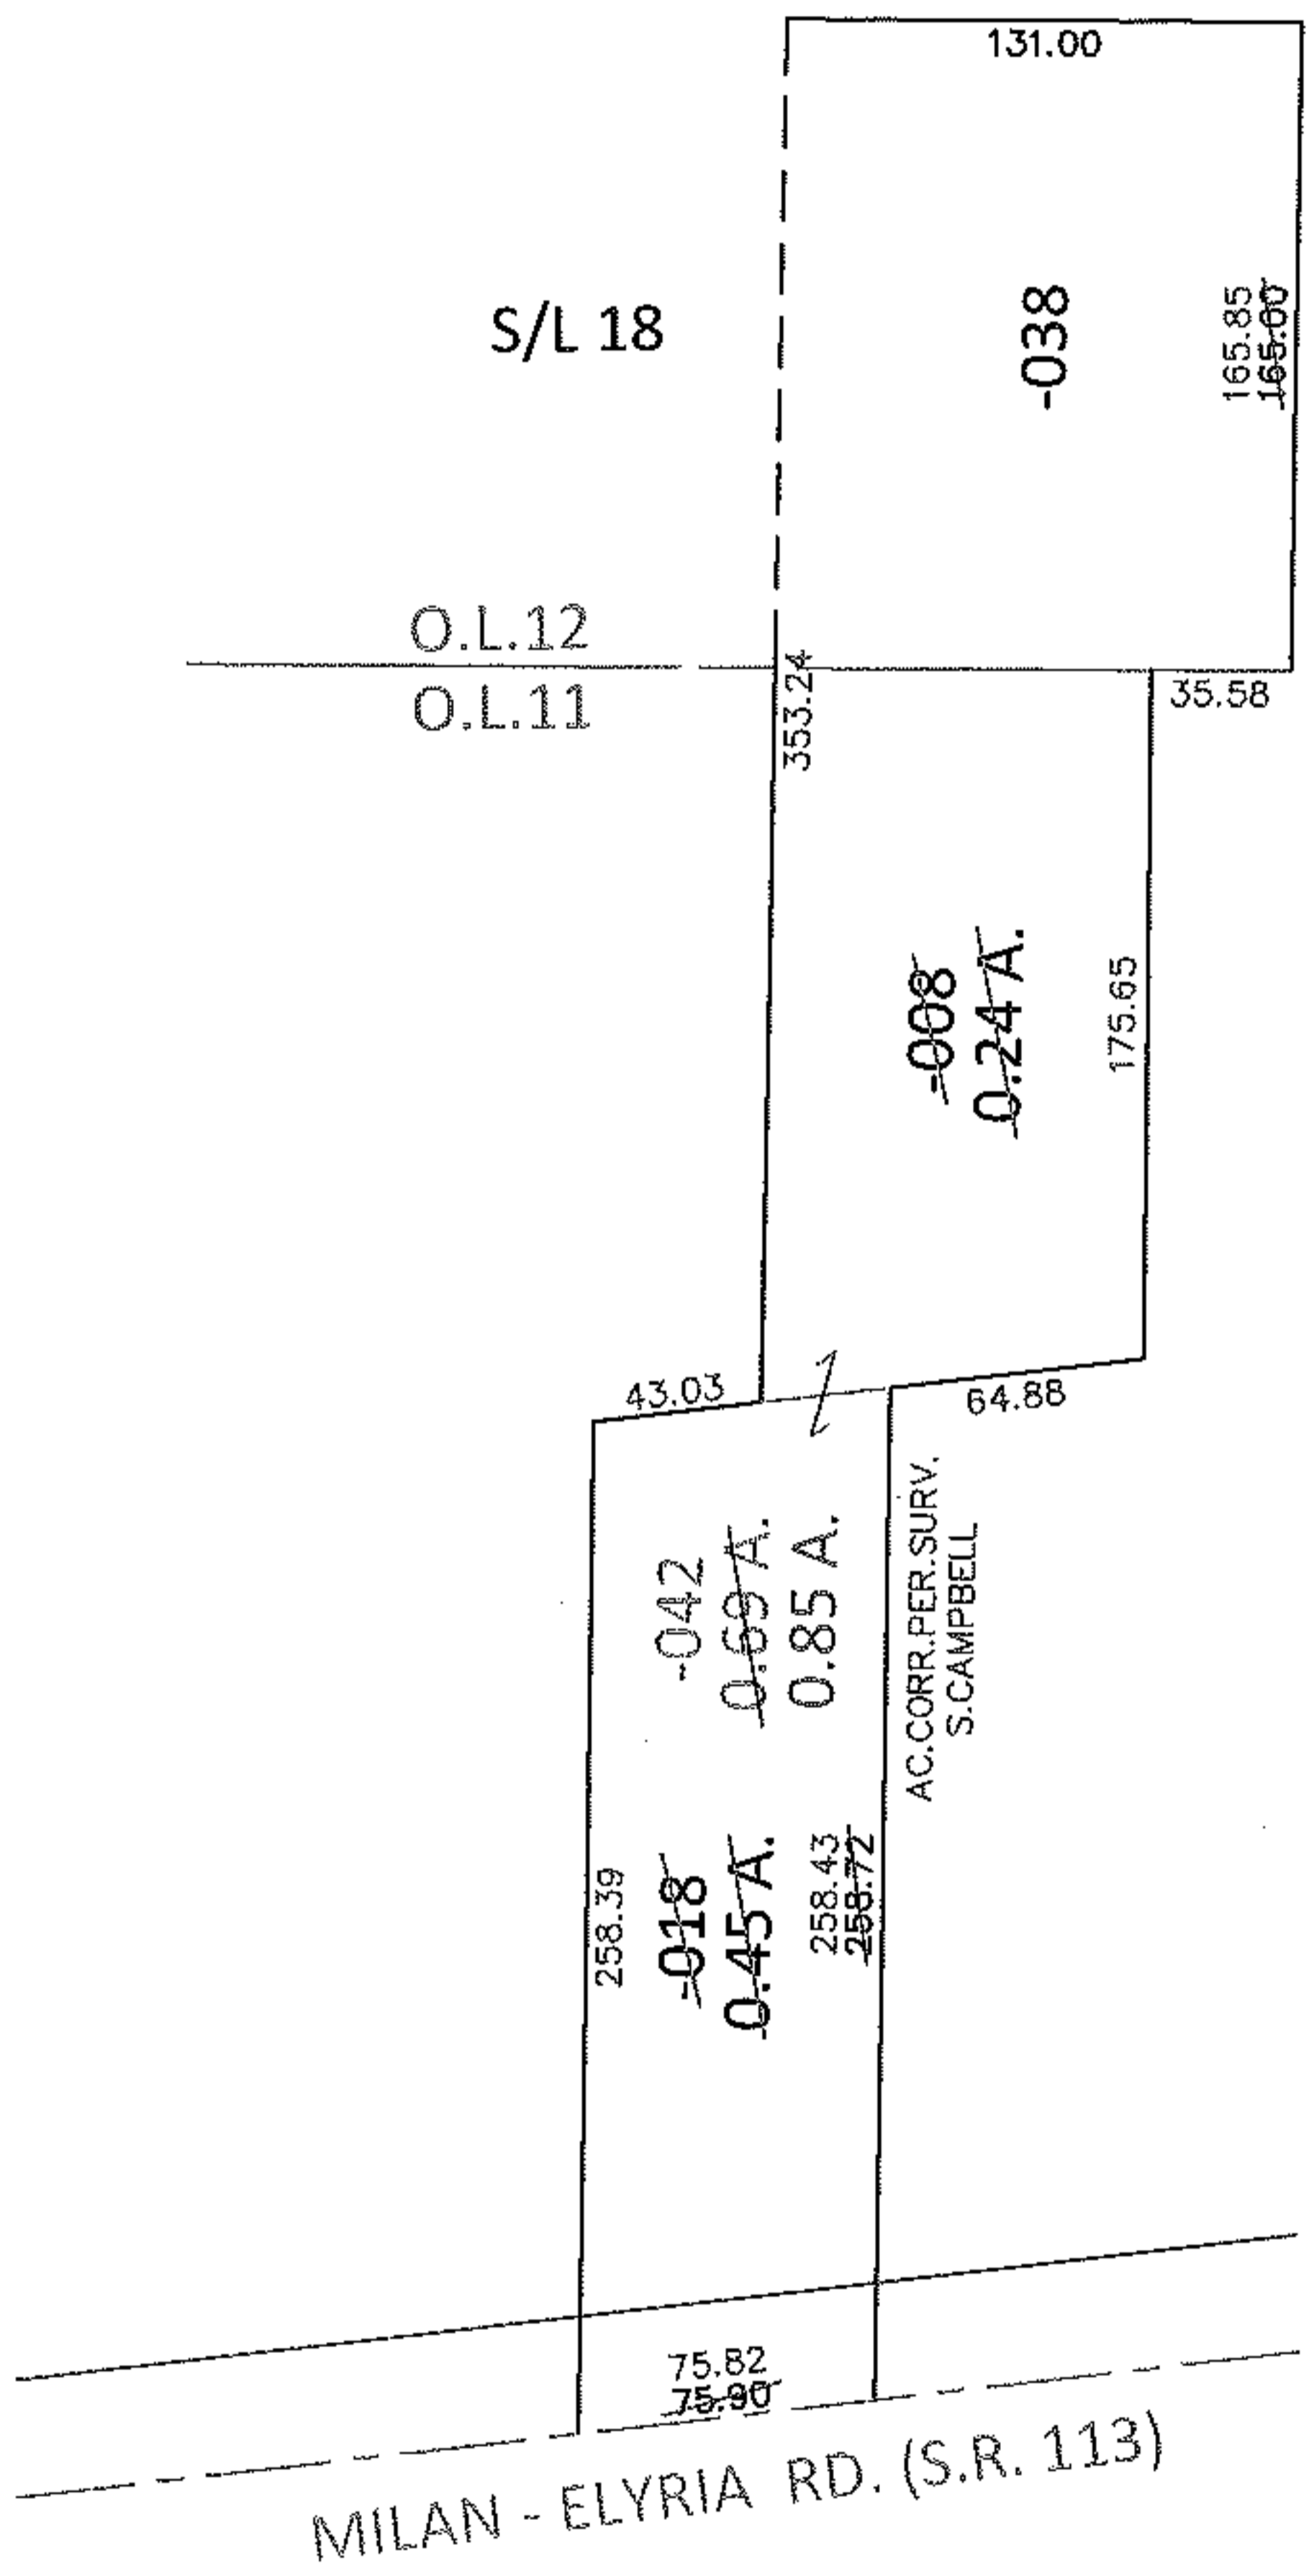


PARENT PARCEL: 05-00-011-101-008, -018, 05-00-012-101-038


CHILD PARCEL: 05-00-011-101-042, 05-00-012-101-038

STARTING POINT: SOUTHEAST CORNER OF S/L 18 IN BEN GREBE'S SUB. (VOL.8 PG.17)

14-02933-D

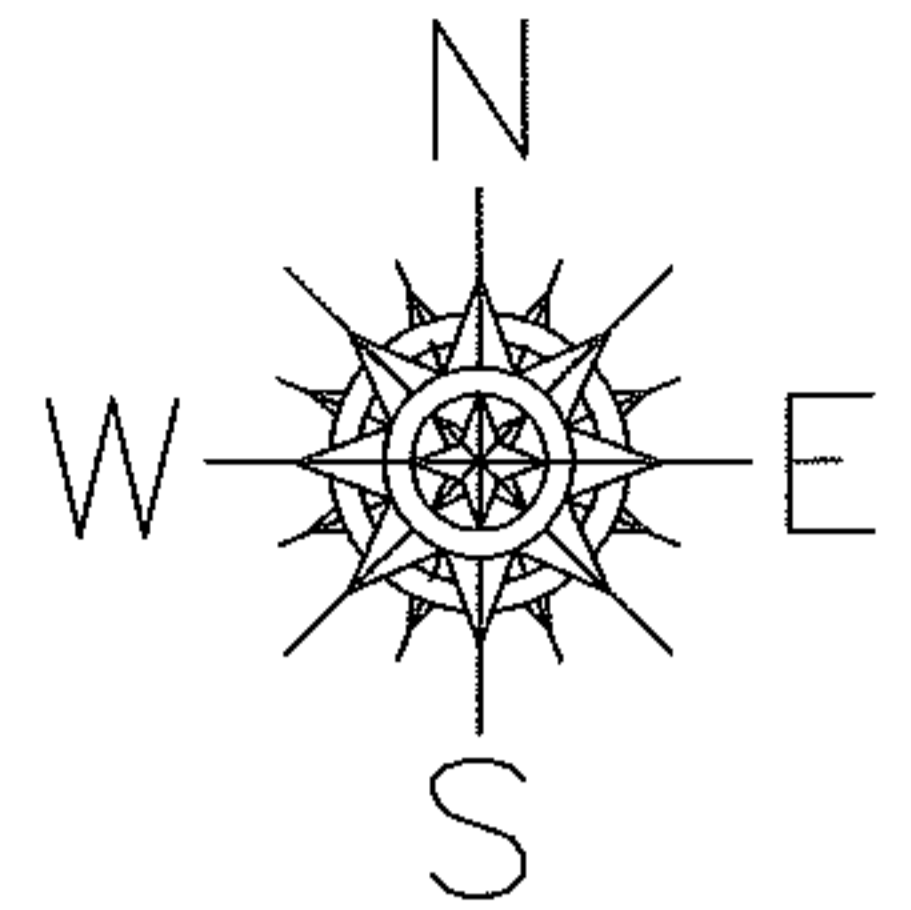

DEPTH CORRECTION  
 05-00-012-101-038  
 165.85  
 131 X .165  
 CORR. PER. SURV. S. CAMPBELL

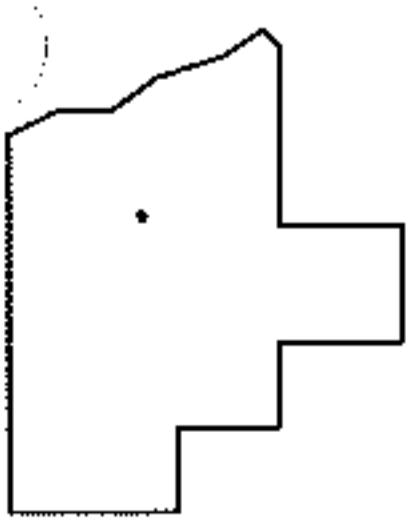

**SPLITS/DEEDS PROCESSED**  
 LORAIN COUNTY TAX MAP DEPARTMENT  
 226 MIDDLE AVE. ELYRIA, OHIO

SURVEYED BY: STEPHEN P. CAMPBELL  
 CLOSURE: .01:10,000  
 MAP PAGE(S): 5-00-011-A, 5-00-012-A  
 APPROVED BY: RRM DATE: 5-2-14  
 SCALE: 1"= 100 PRIOR INST.: 20130486174