
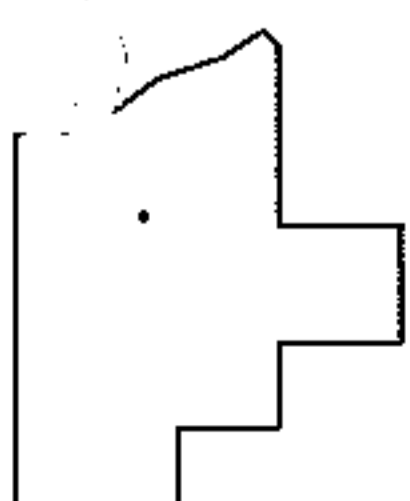
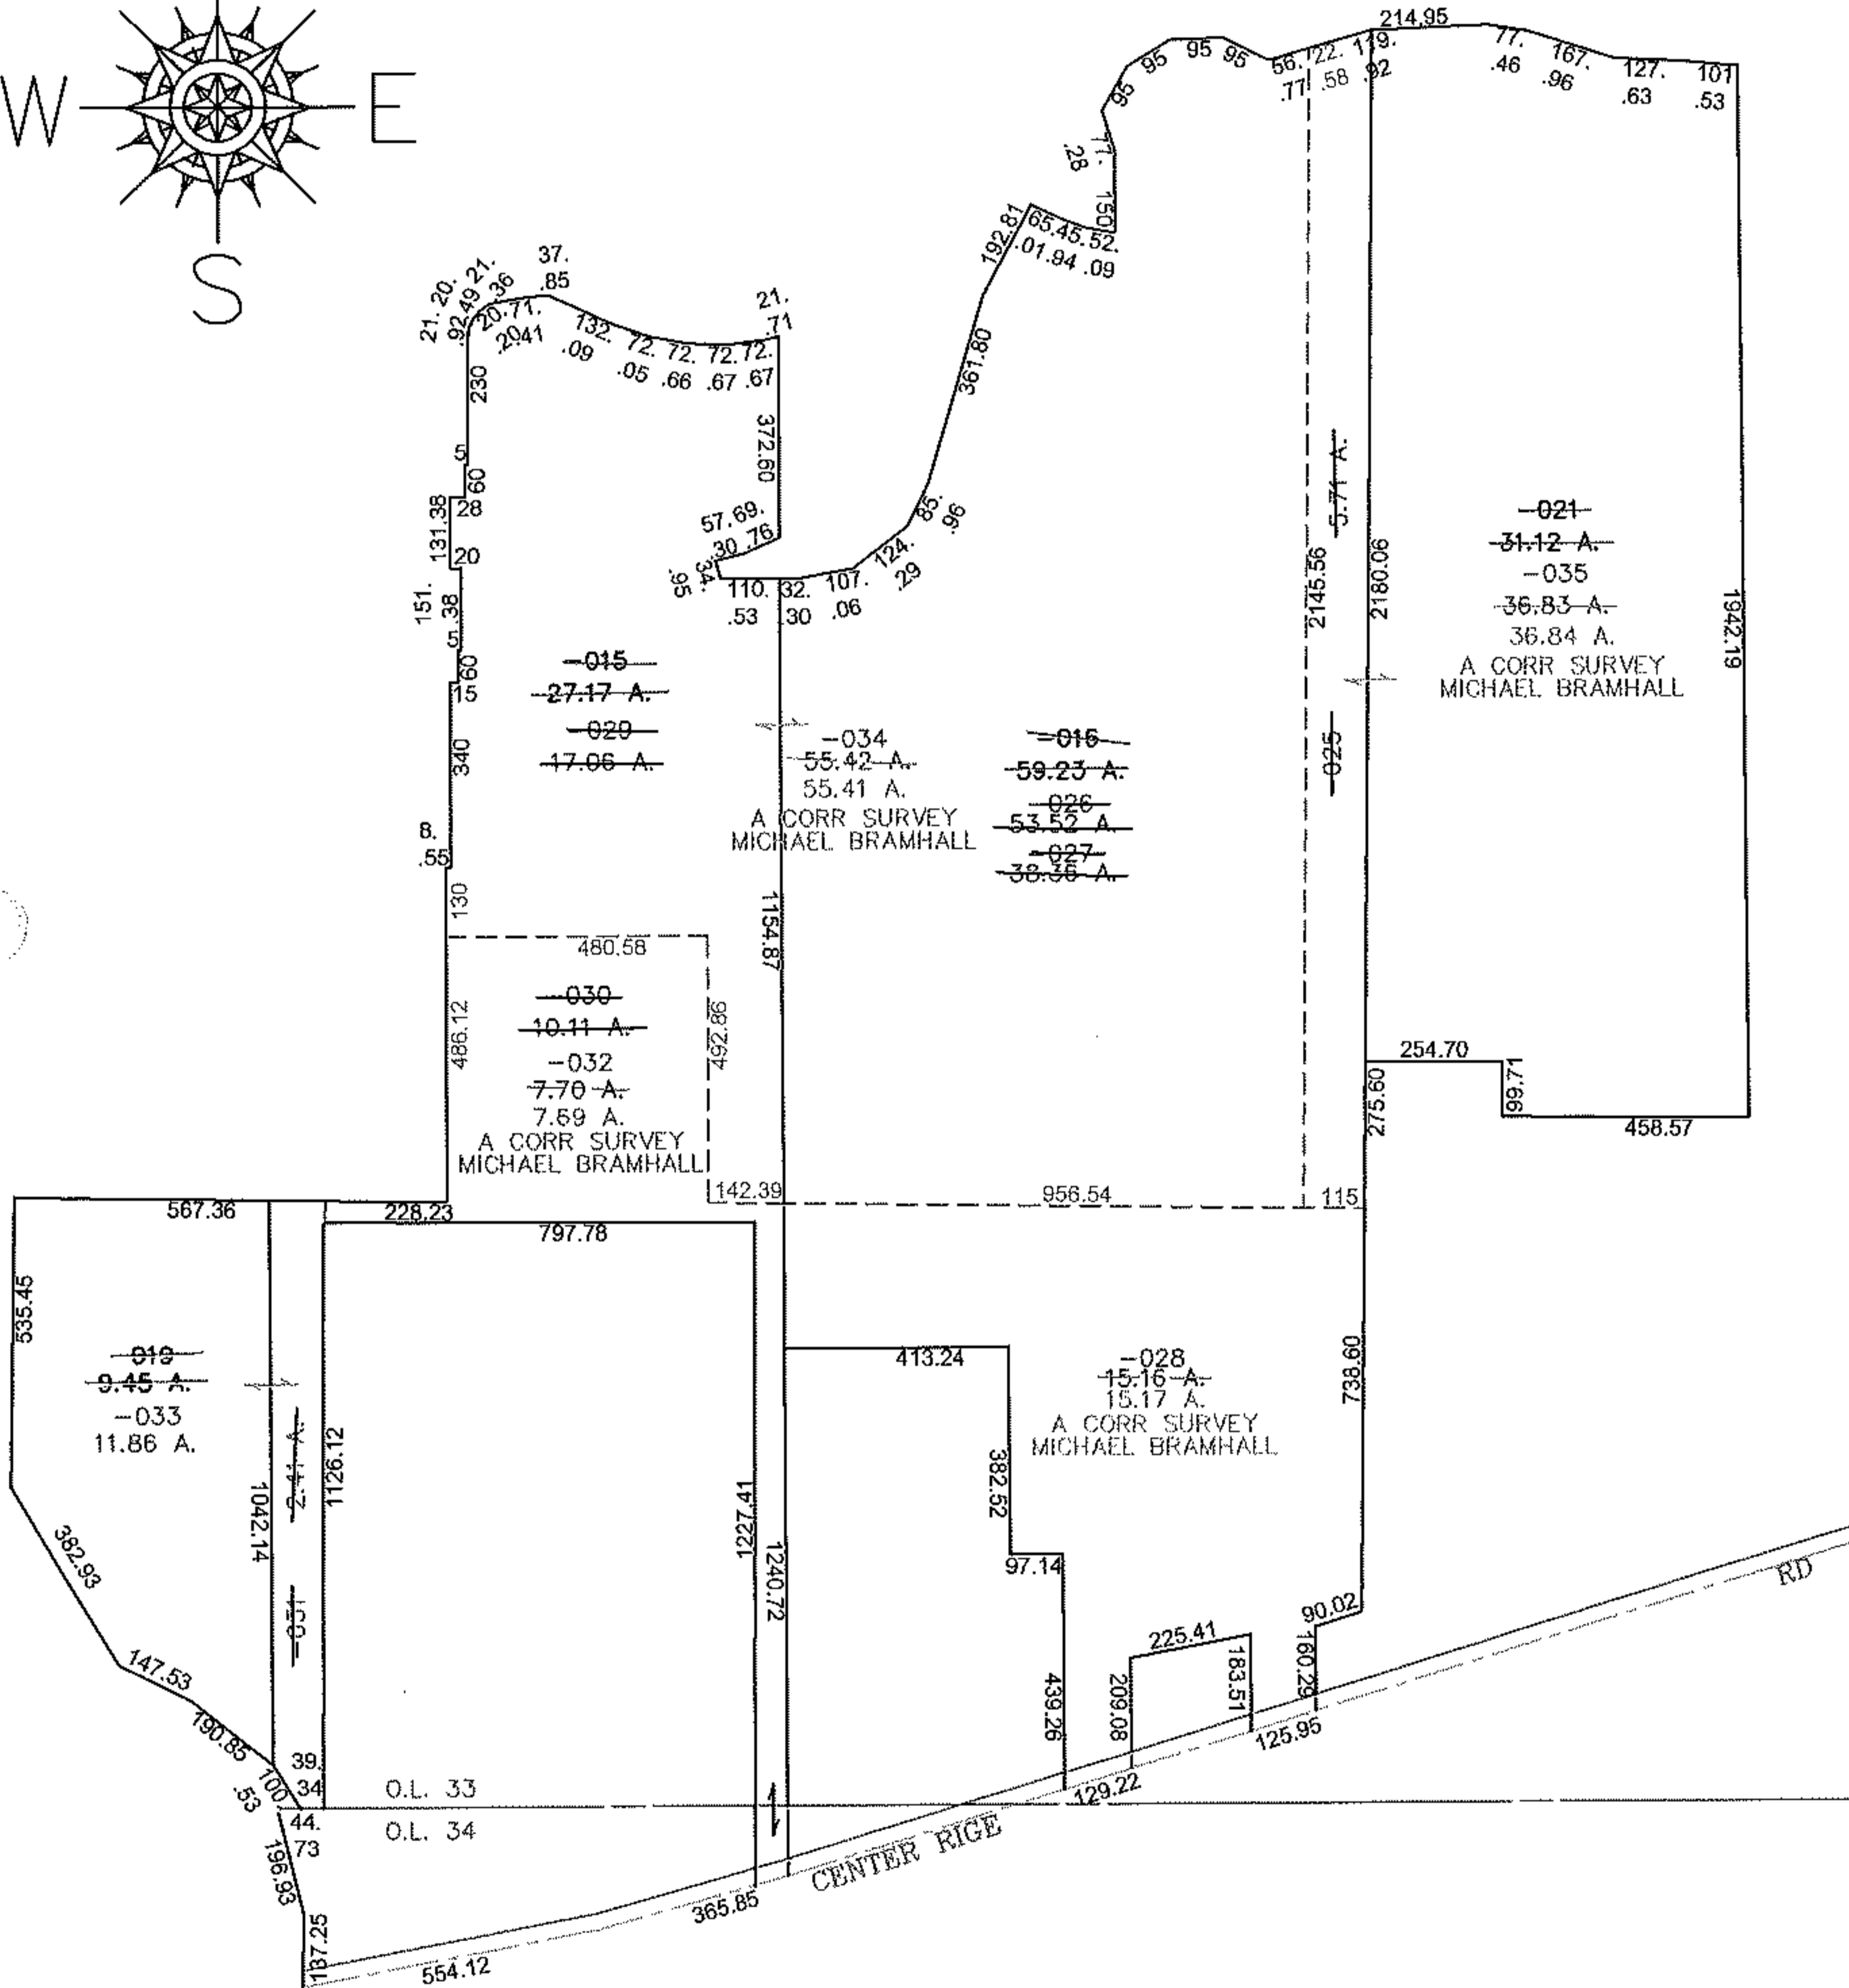


PARENT PARCEL: 07-00-033-101-016, -015, -019, -021

CHILD PARCEL: 07-00-033-101-025 THRU -035

STARTING POINT: CENTERLINE OF CENTER RIDGE RD & O.L. 33

11-02935

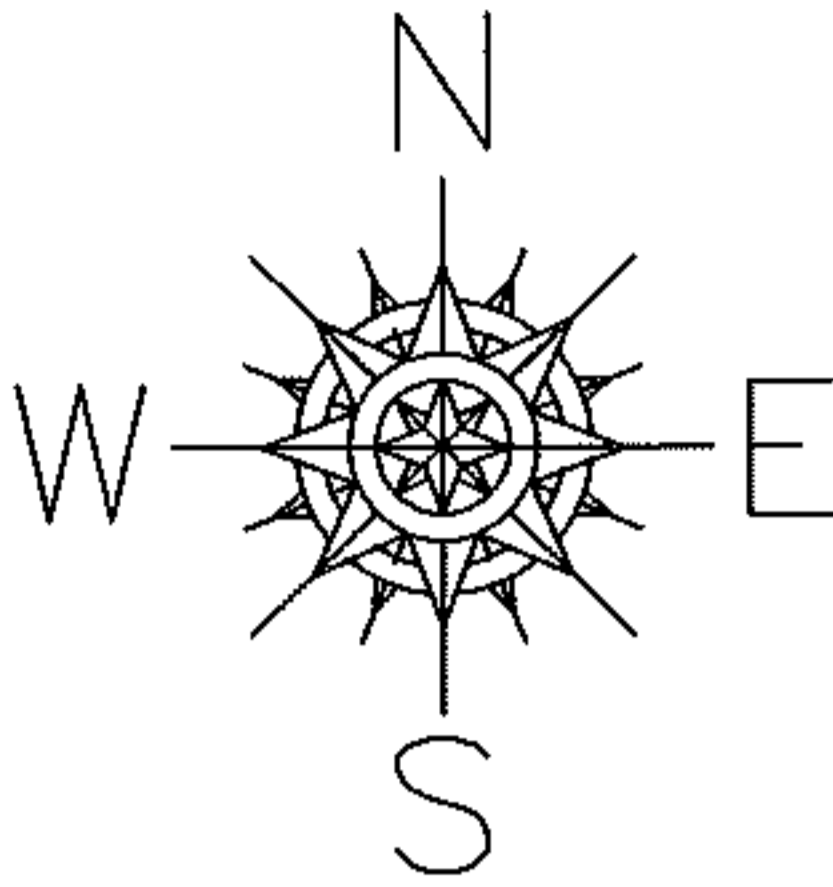

**SPLITS/DEEDS PROCESSED**

LORAIN COUNTY TAX MAP DEPARTMENT  
226 MIDDLE AVE. ELYRIA, OHIO

SURVEYED BY: MICHAEL BRAMHALL  
CLOSURE: 0.00 : 10.000  
MAP PAGE(S): 7-B  
APPROVED BY: JAH DATE: 8/5/2011  
SCALE: 1" = 500 PRIOR INSTRUMENT: 20100357713