
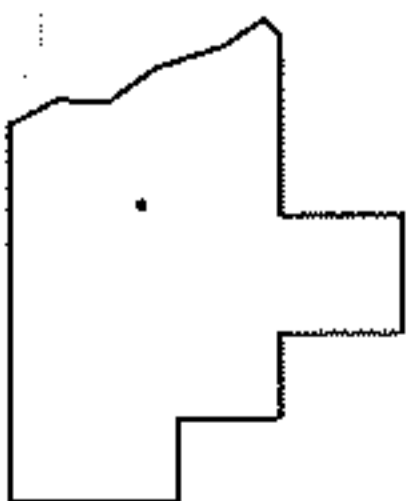
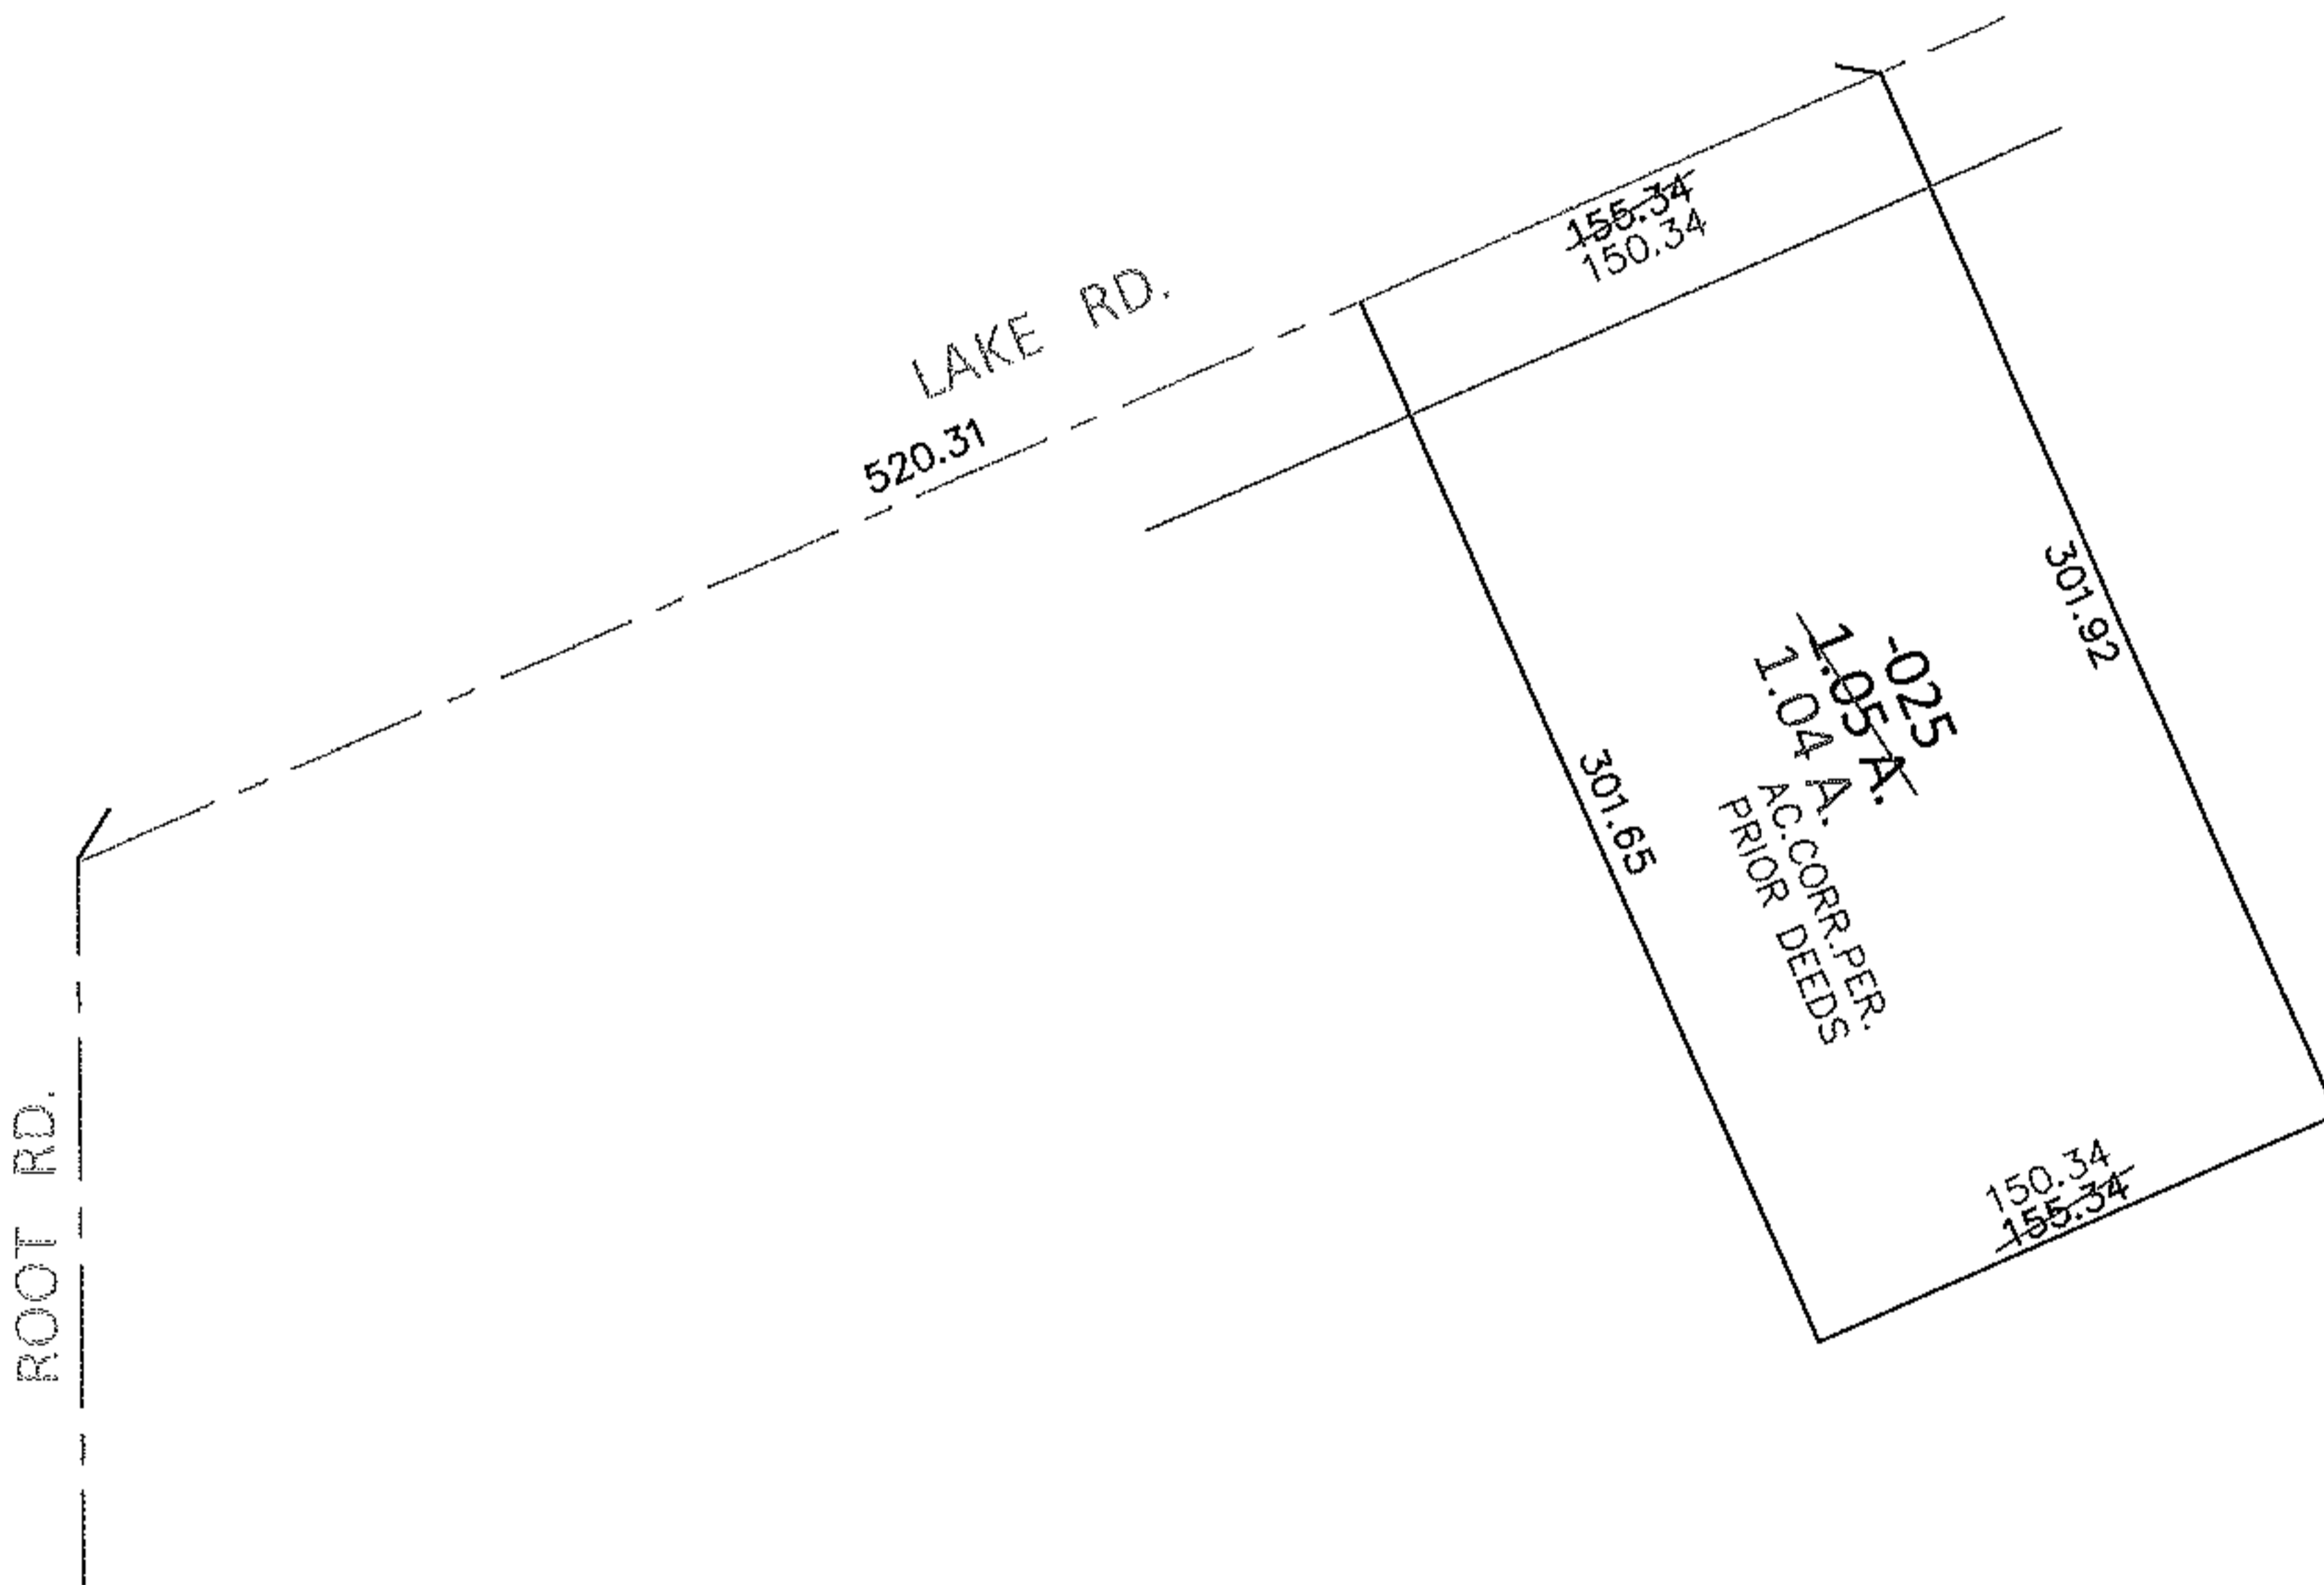


PARENT PARCEL: 03-00-045-102-025

CHILD PARCEL: _____

14-02936-A

STARTING POINT: INTERSECTION OF C/L OF ROOT RD. AND C/L OF LAKE RD.

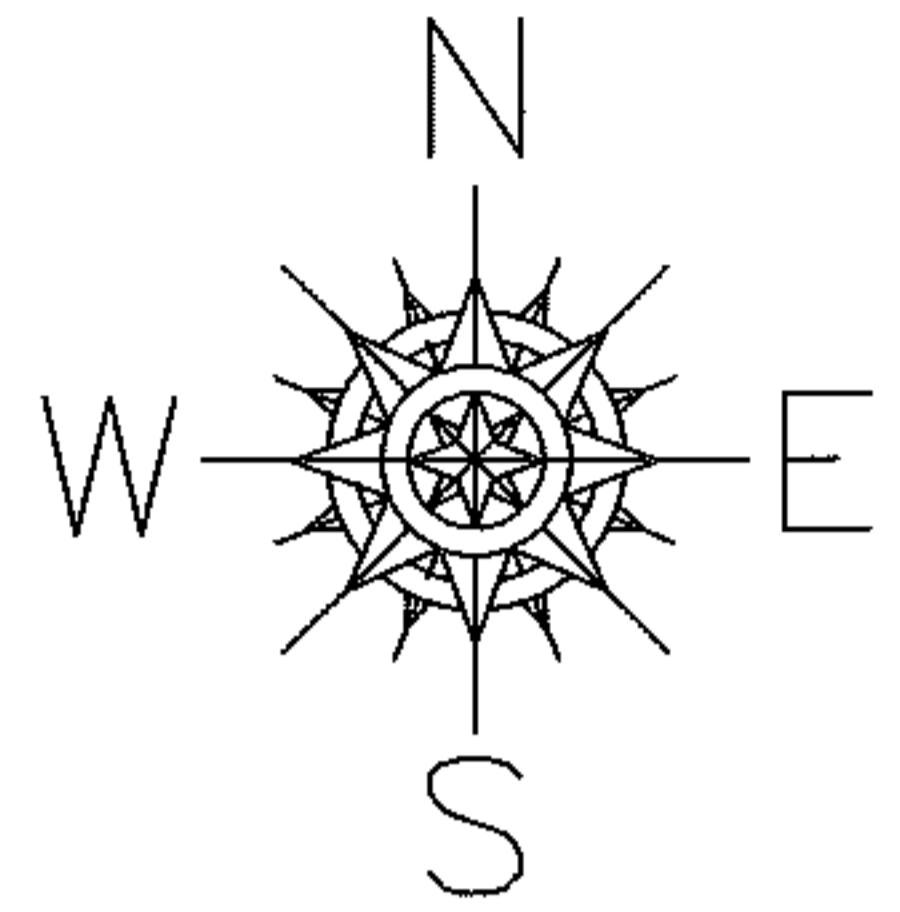

SPLITS/DEEDS PROCESSED

LORAIN COUNTY TAX MAP DEPARTMENT
226 MIDDLE AVE. ELYRIA, OHIO

SURVEYED BY: N/A

CLOSURE: .01:10,000

MAP PAGE(S): 3-00-045

APPROVED BY: RRM DATE: 5-7-14

SCALE: 1"= 100 PRIOR INST.: 20140500277