
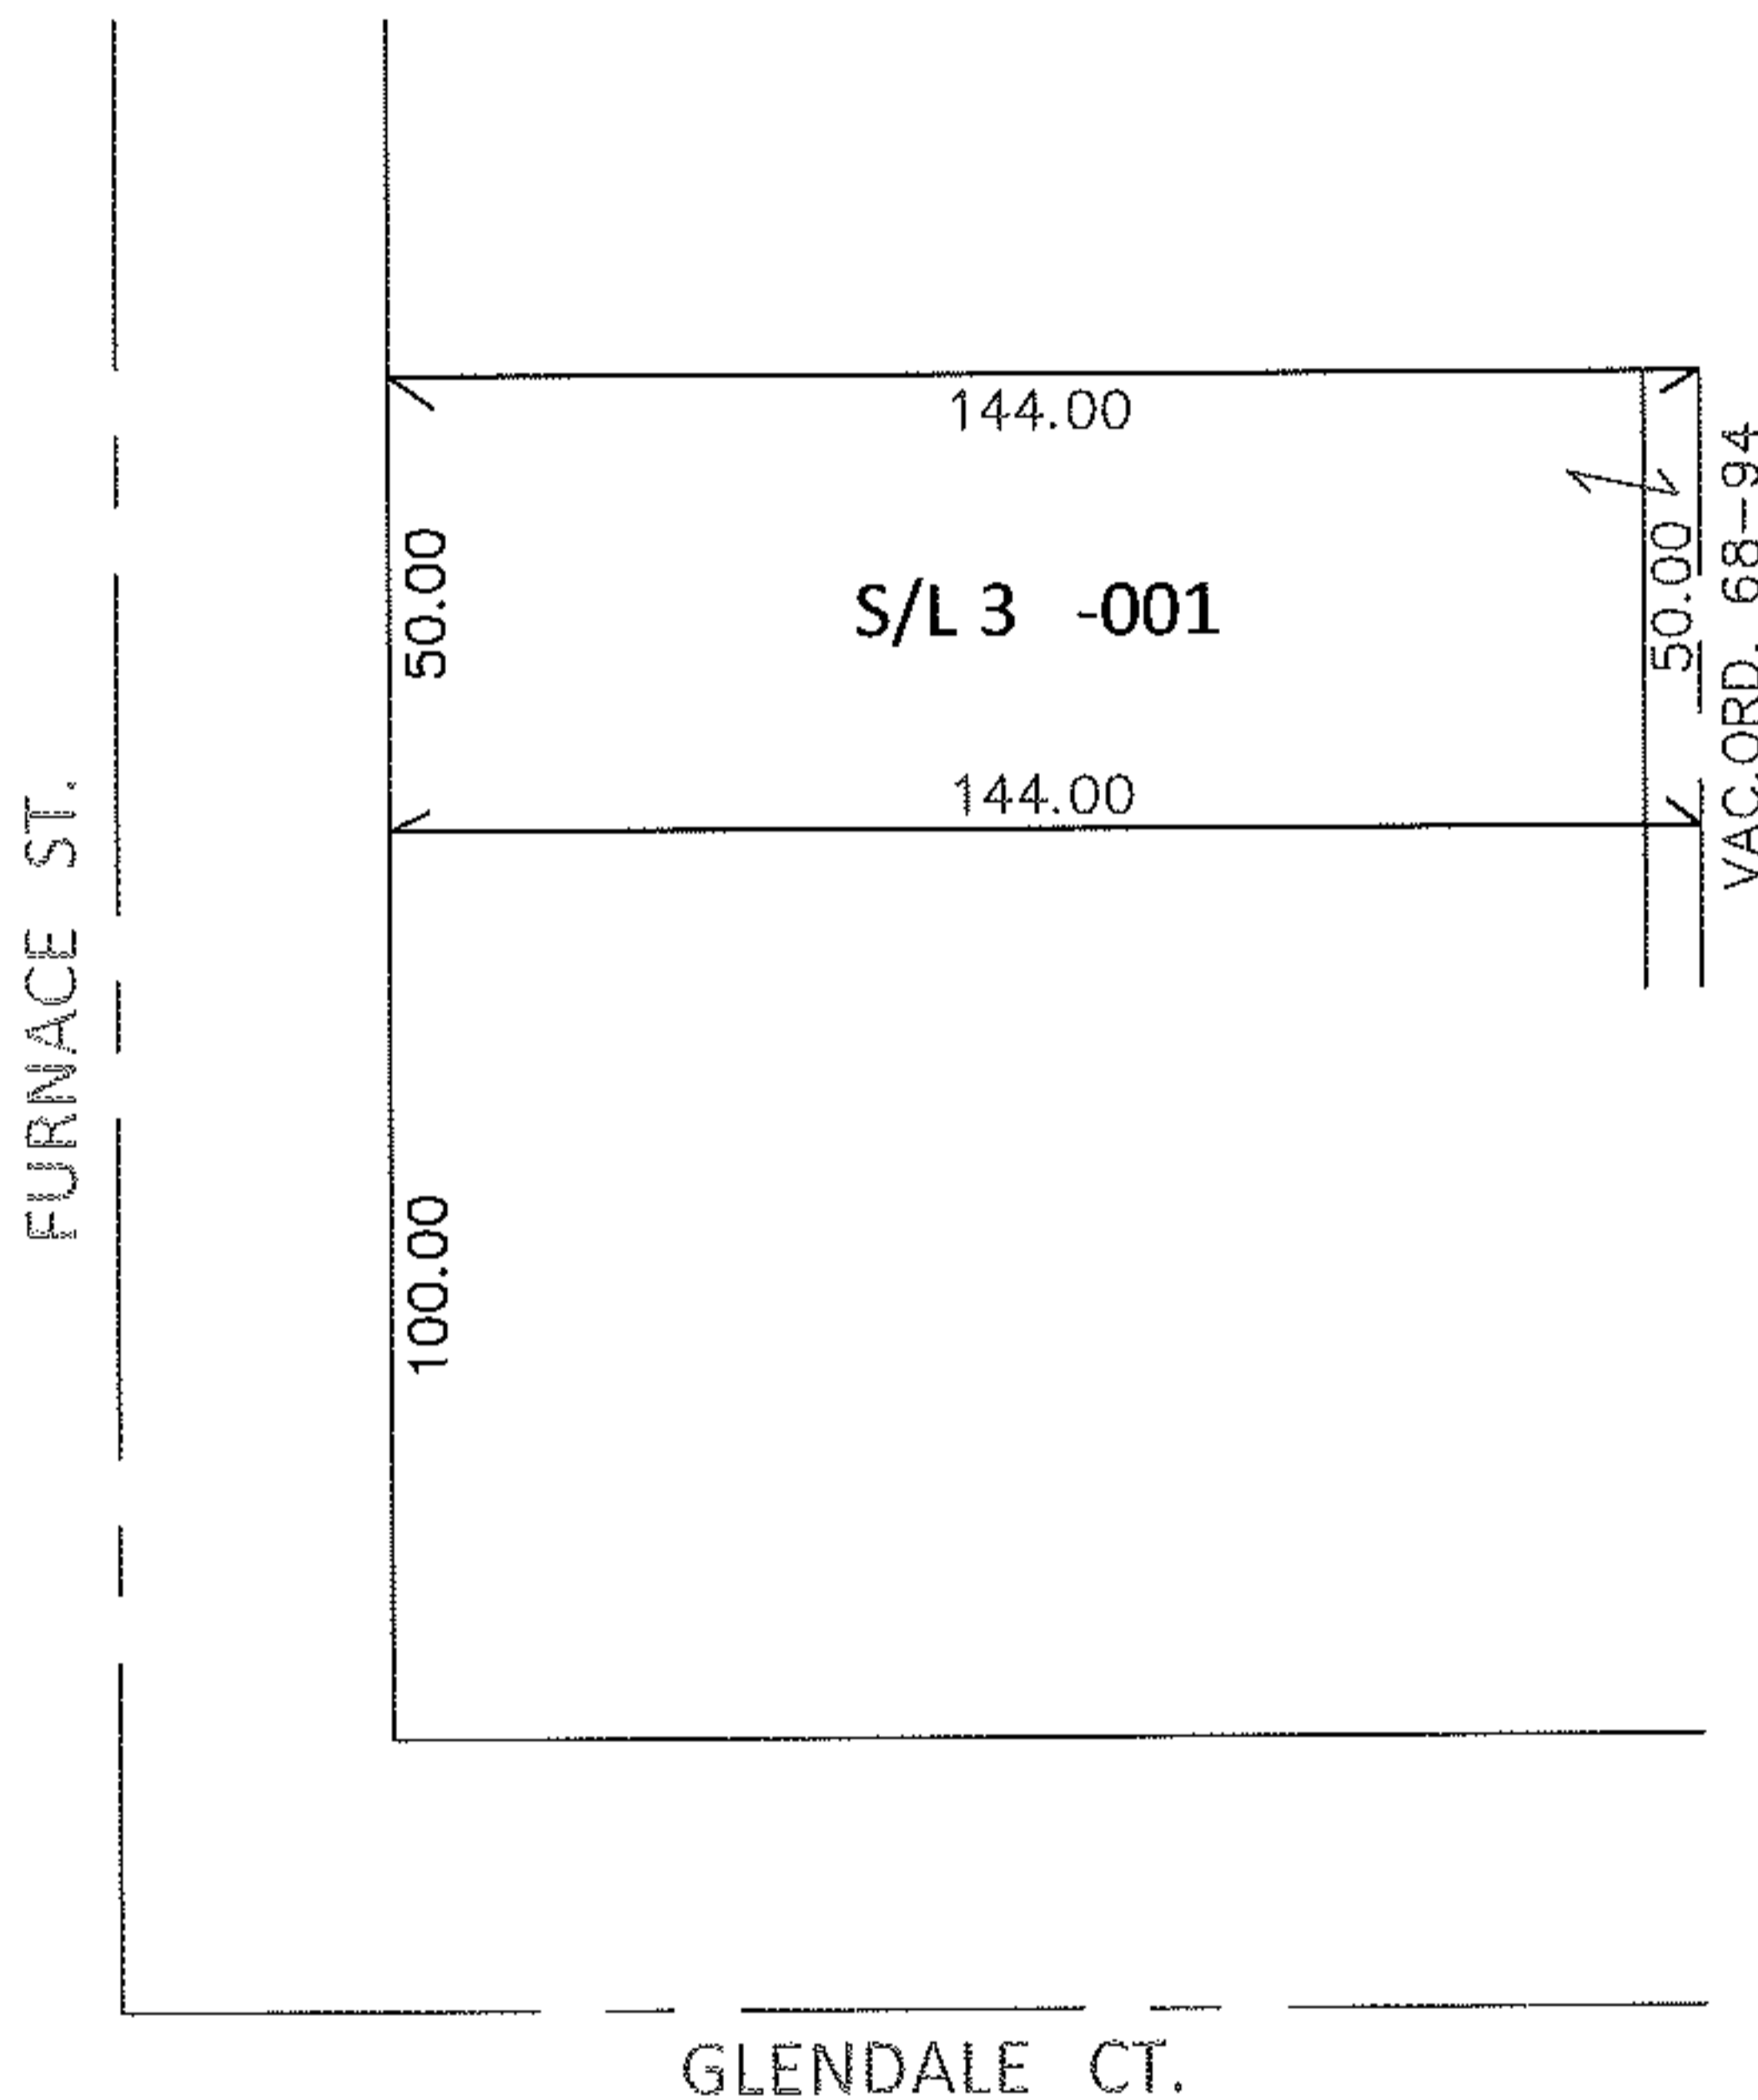


PARENT PARCEL: 06-24-158-000-001

CHILD PARCEL:

14-02937-C

STARTING POINT: INTERSECTION OF NORTH LINE OF GLENDALE CT. AND EAST LINE OF FURNACE ST.

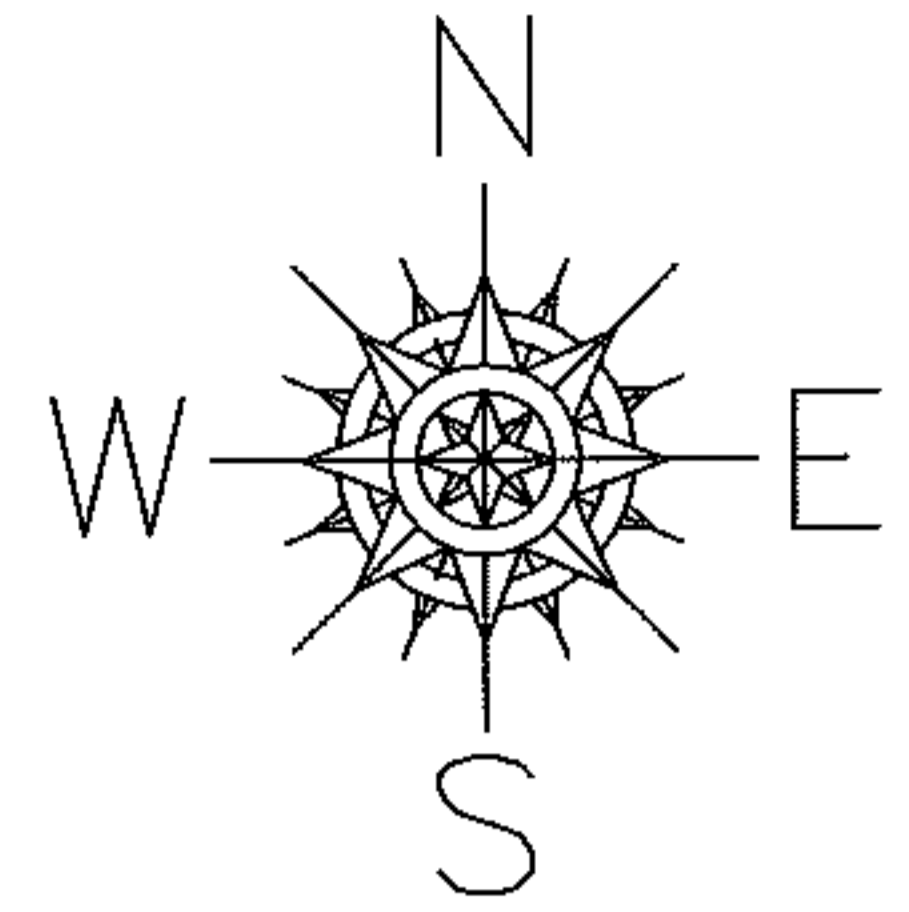


DEPTH CORRECTION

06-24-158-000-001

144

50 X ~~138~~

PER SURV. D.HAYWOOD

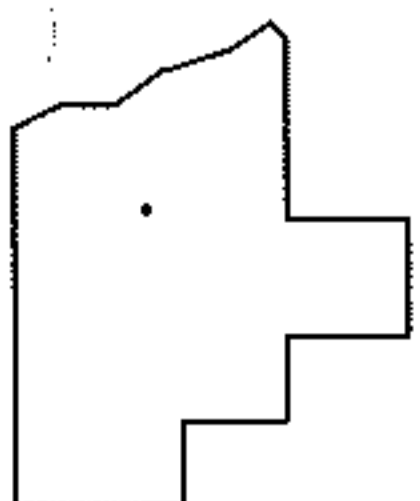

SPLITS/DEEDS PROCESSED

LORAIN COUNTY TAX MAP DEPARTMENT
226 MIDDLE AVE. ELYRIA, OHIO

SURVEYED BY: DALE R. HAYWOOD

CLOSURE: .00:10,000

MAP PAGE(S): 6-101

APPROVED BY: RRM DATE: 5-7-14

SCALE: 1"= 50' PRIOR INST.: 20120399986