



RASTER

PARENT PARCEL: 04-00-024-101-018

CHILD PARCEL: 04-00-024-101-163, -164

STARTING POINT: CENTERLINE OF FAIRWAY DR & JAYCOX RD

11-02942

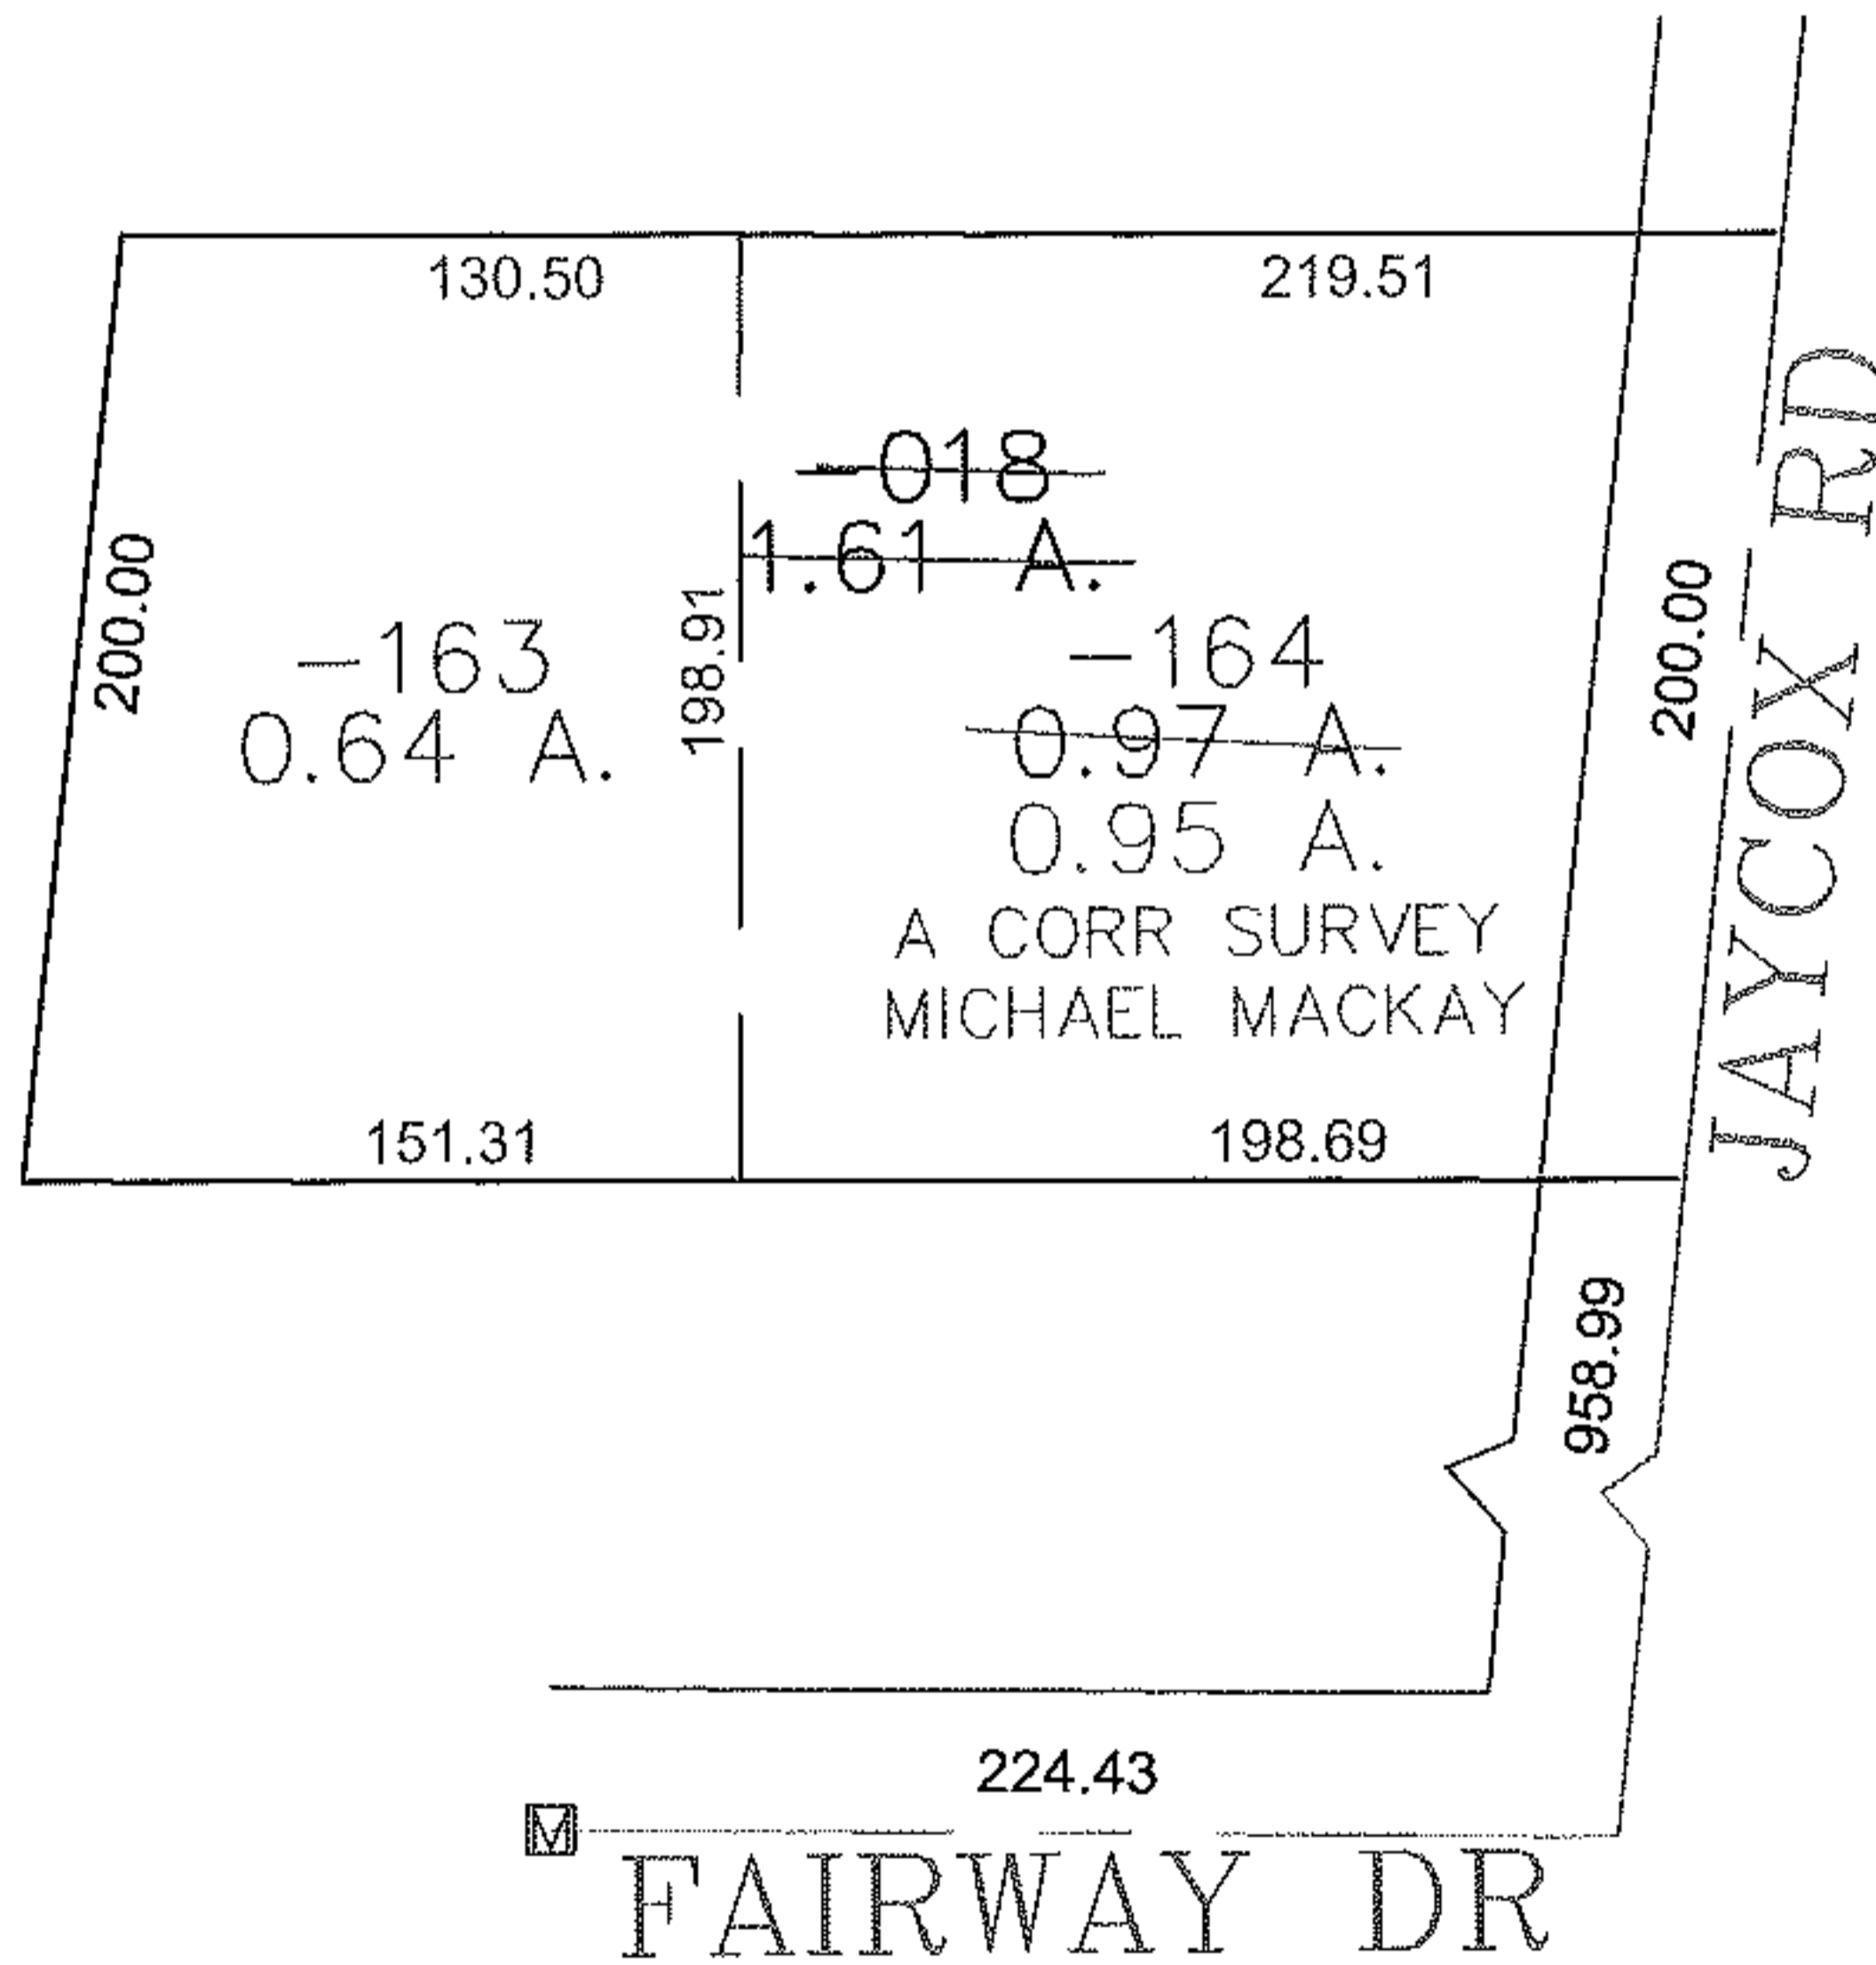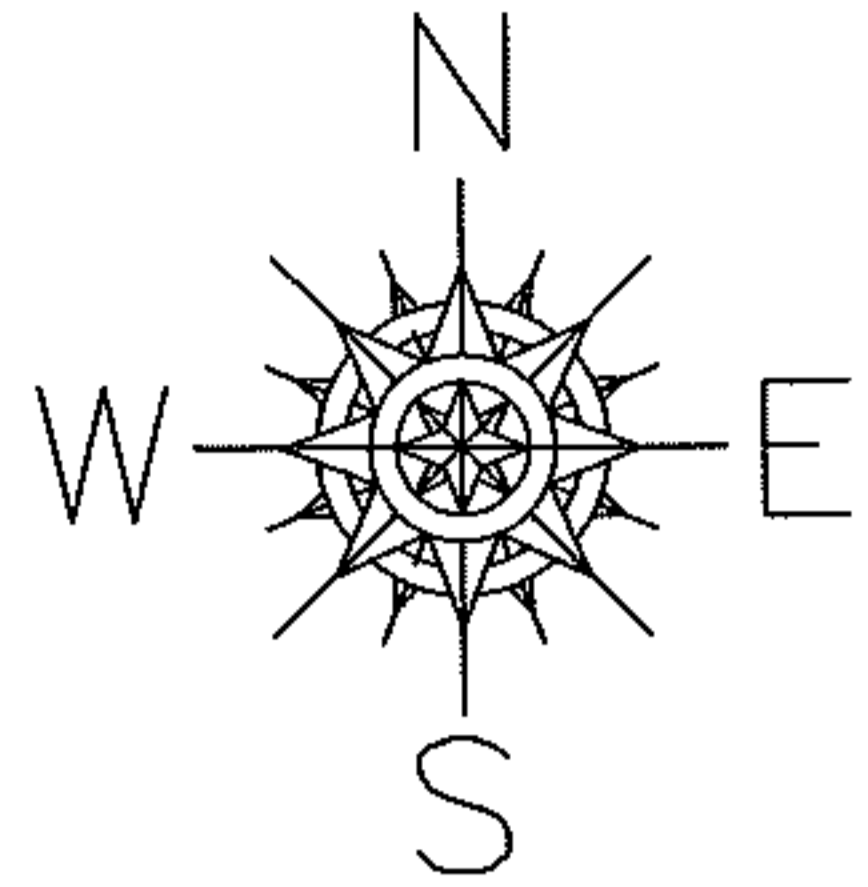

SPLITS/DEEDS PROCESSED

LORAIN COUNTY TAX MAP DEPARTMENT
226 MIDDLE AVE. ELYRIA, OHIO

SURVEYED BY: MICHAEL MACKAY

CLOSURE: 0.00 : 10.000

MAP PAGE(S): 04-00-024-E

APPROVED BY: JAH DATE: 8/18/2011

SCALE: 1" = 100 PRIOR INSTRUMENT: 20110364941