
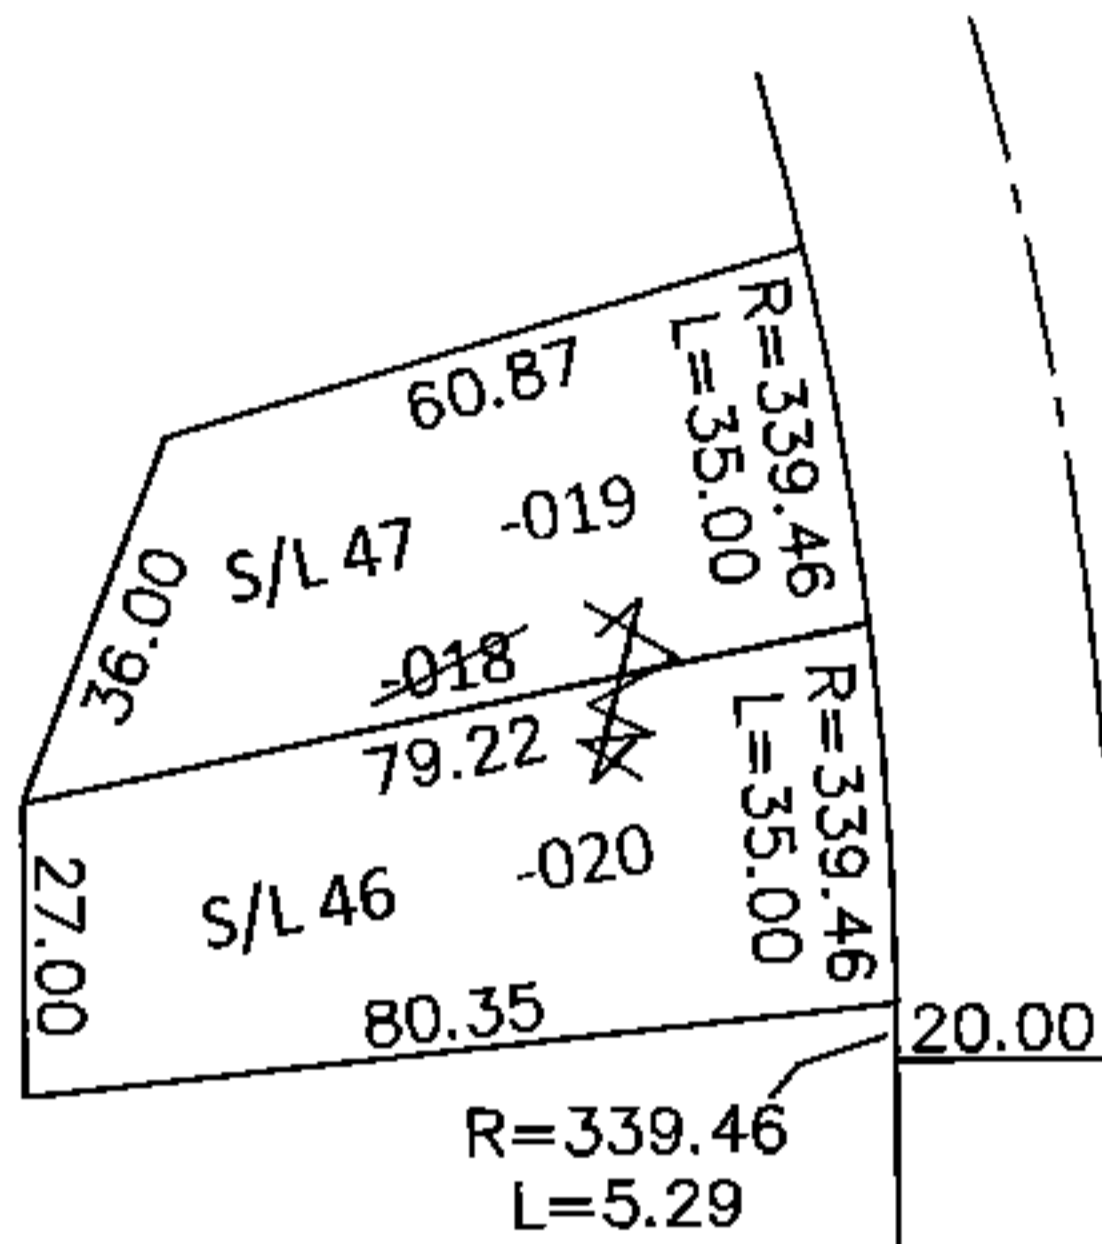


PARENT PARCEL: 04-00-006-102-018

CHILD PARCEL: 04-00-006-102-019, -020

STARTING POINT: INTERSECTION OF C/L OF MOORE RD. AND C/L OF LAKE RD.

14-02944-U

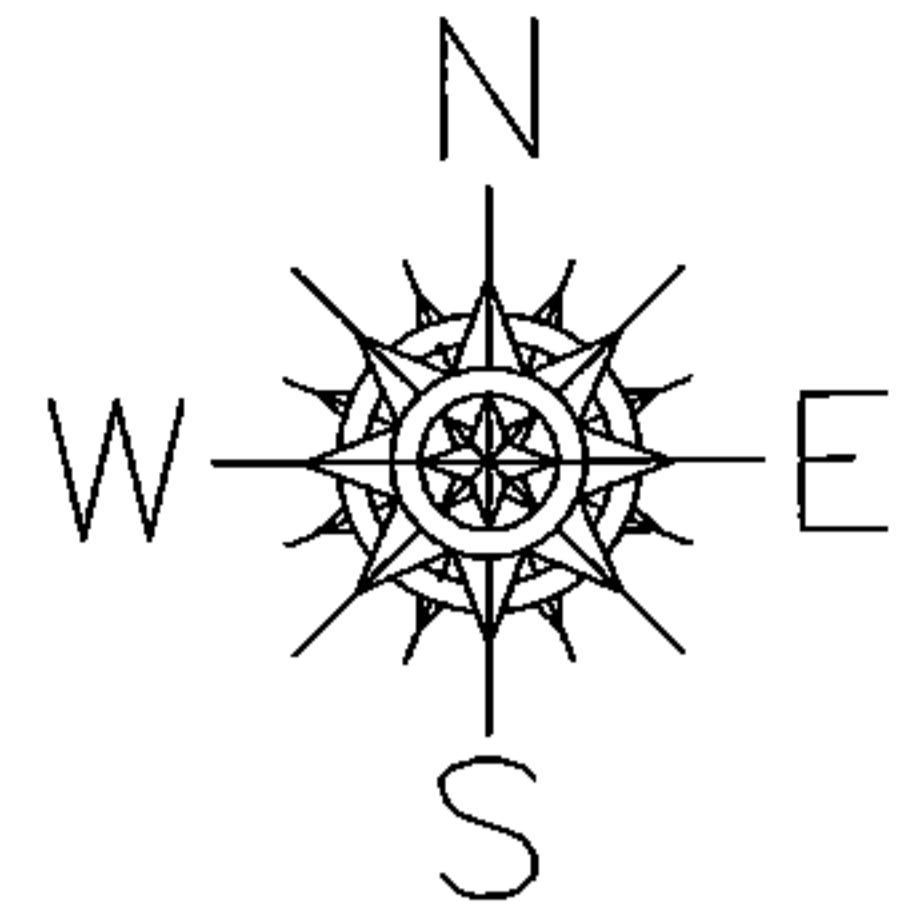

AVALON RD.

UNCOMBINATION

~~04-00-006-102-018~~
~~70 X 80.35~~


04-00-006-102-019 04-00-006-102-020
35 X 79.22 35 X 80.35

PER PRIOR DEEDS

MOORE RD.

235.00

221.30
LAKE RD.

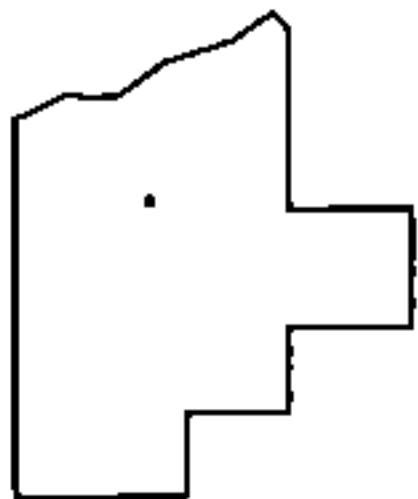

SPLITS/DEEDS PROCESSED

LORAIN COUNTY TAX MAP DEPARTMENT
226 MIDDLE AVE. ELYRIA, OHIO

SURVEYED BY: N/A

CLOSURE: .01:10,000

MAP PAGE(S): 4-00-006-A

APPROVED BY: RRM DATE: 5-19-14

SCALE: 1"= 50' PRIOR INST.: 20050091304