


PARENT PARCEL: 13-09-022-000-004

CHILD PARCEL: \_\_\_\_\_

STARTING POINT: INTERSECTION OF C/L OF BRONSON RD. AND C/L OF S.R. 511

14-02945-A

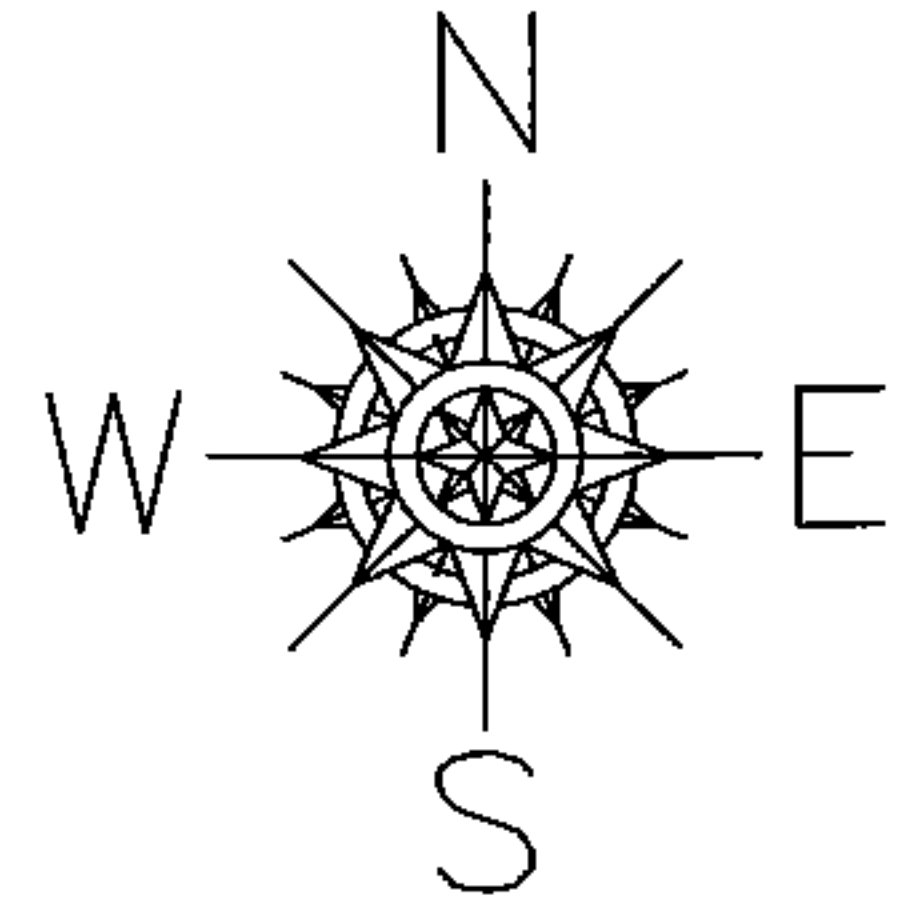

BRONSON RD.

969.86

S.R. 511

1785.11

470.13

987.13


981.98

-004  
~~39.67 A.~~  
40.01 A.

AC. CORR. PER. SURV.  
T. SIMON

1756.96

TR.9 TR.9  
O.L.21 O.L.22  
O.L.34 O.L.33  
TR.9 TR.9

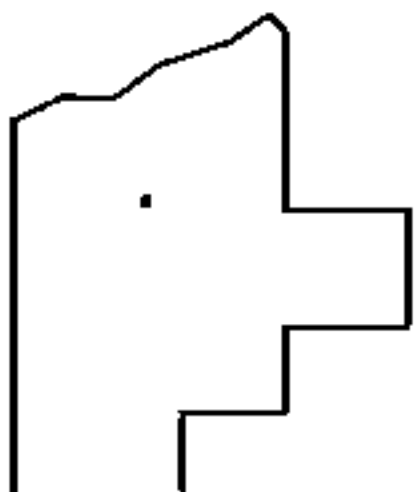

**SPLITS/DEEDS PROCESSED**

LORAIN COUNTY TAX MAP DEPARTMENT  
226 MIDDLE AVE. ELYRIA, OHIO

SURVEYED BY: THOMAS A. SIMON

CLOSURE: .01:10,000

MAP PAGE(S): 13-F

APPROVED BY: RRM DATE: 5-20-14

SCALE: 1" = 400 PRIOR INST.: 20080240339