
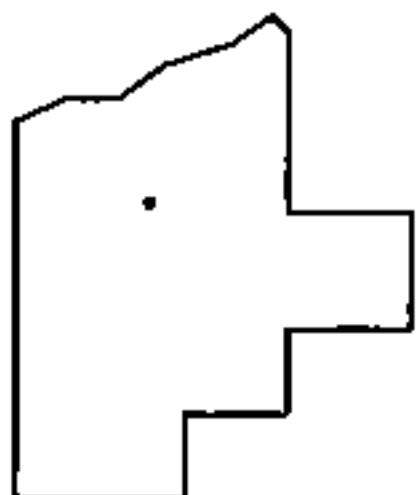
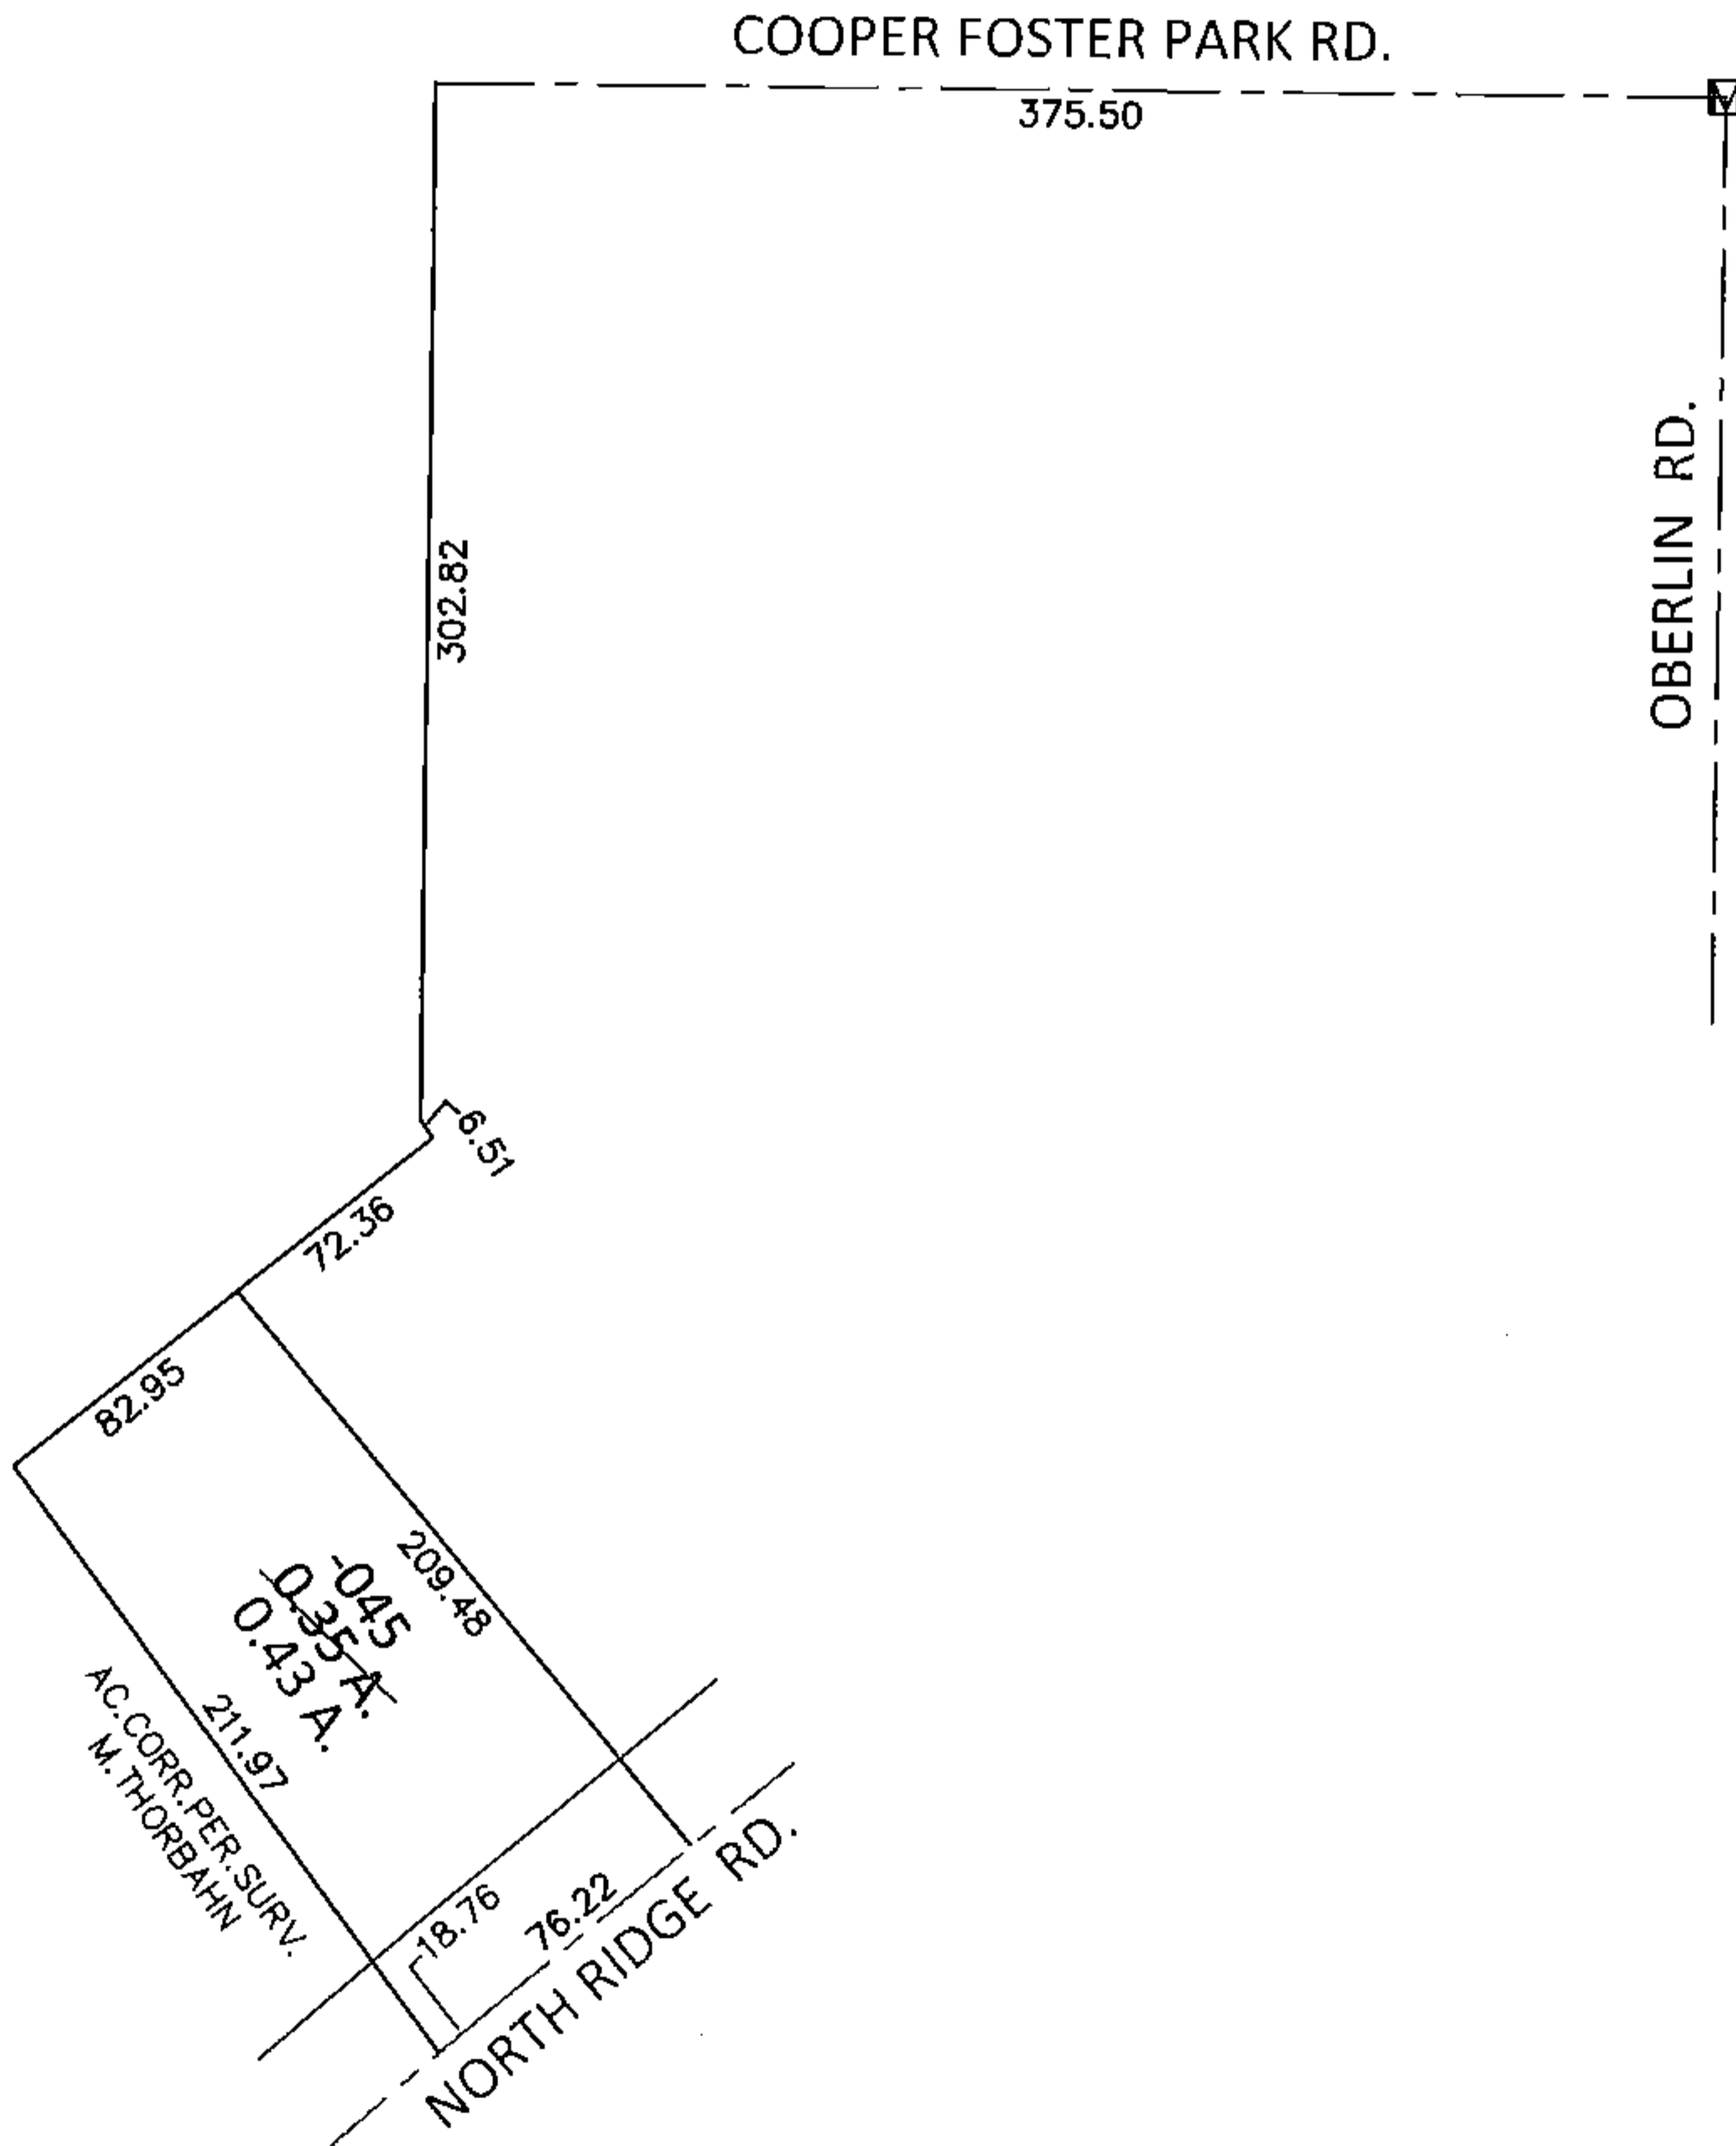


PARENT PARCEL: 05-00-061-101-045

CHILD PARCEL: _____

STARTING POINT: AT A MON BOX AT THE INTERSECTION OF C/L OF OBERLIN RD. AND C/L OF COOPER FOSTER PARK RD.

14-02946-A

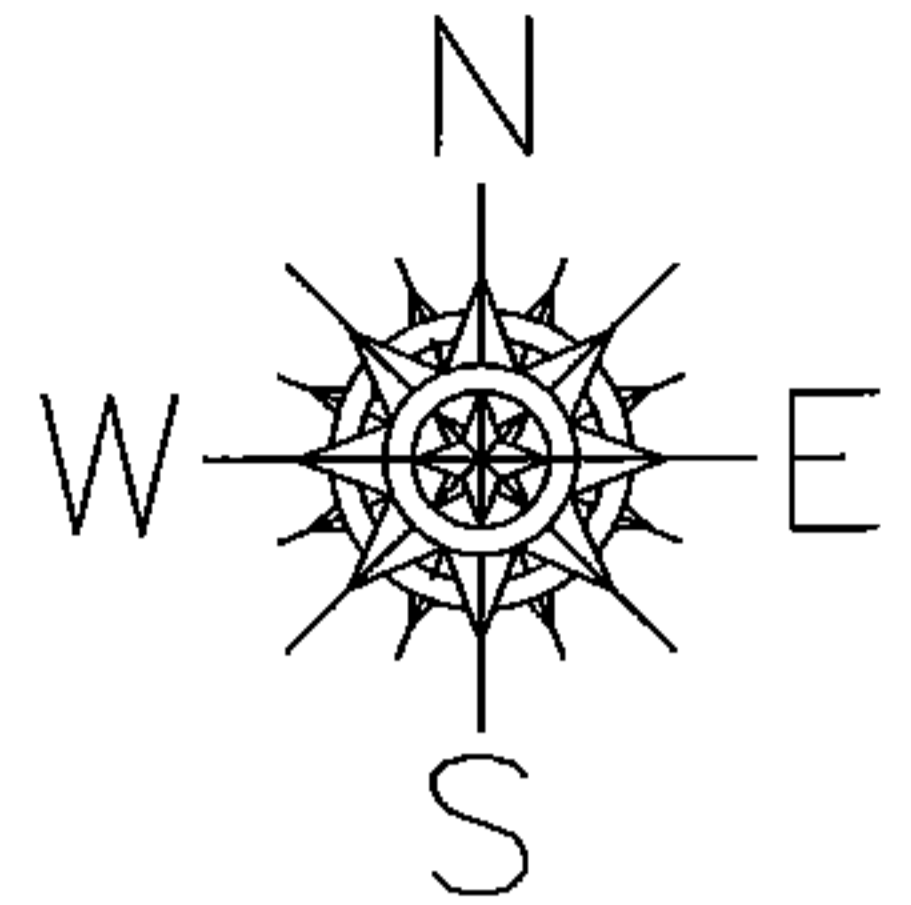

SPLITS/DEEDS PROCESSED

LORAIN COUNTY TAX MAP DEPARTMENT
226 MIDDLE AVE. ELYRIA, OHIO

SURVEYED BY: MICHAEL J. THORBAHN
 CLOSURE: .01:10,000
 MAP PAGE(S): 5-00-061-A
 APPROVED BY: RRM DATE: 5-22-14
 SCALE: 1"= 100 PRIOR INST.: 20010775096