
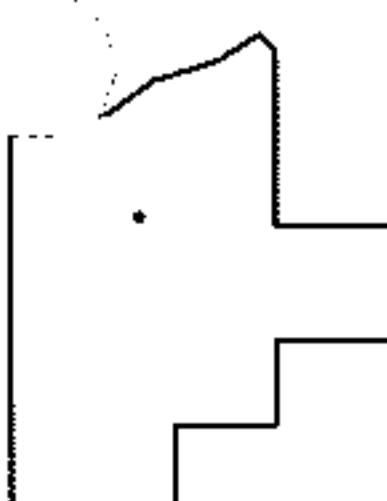
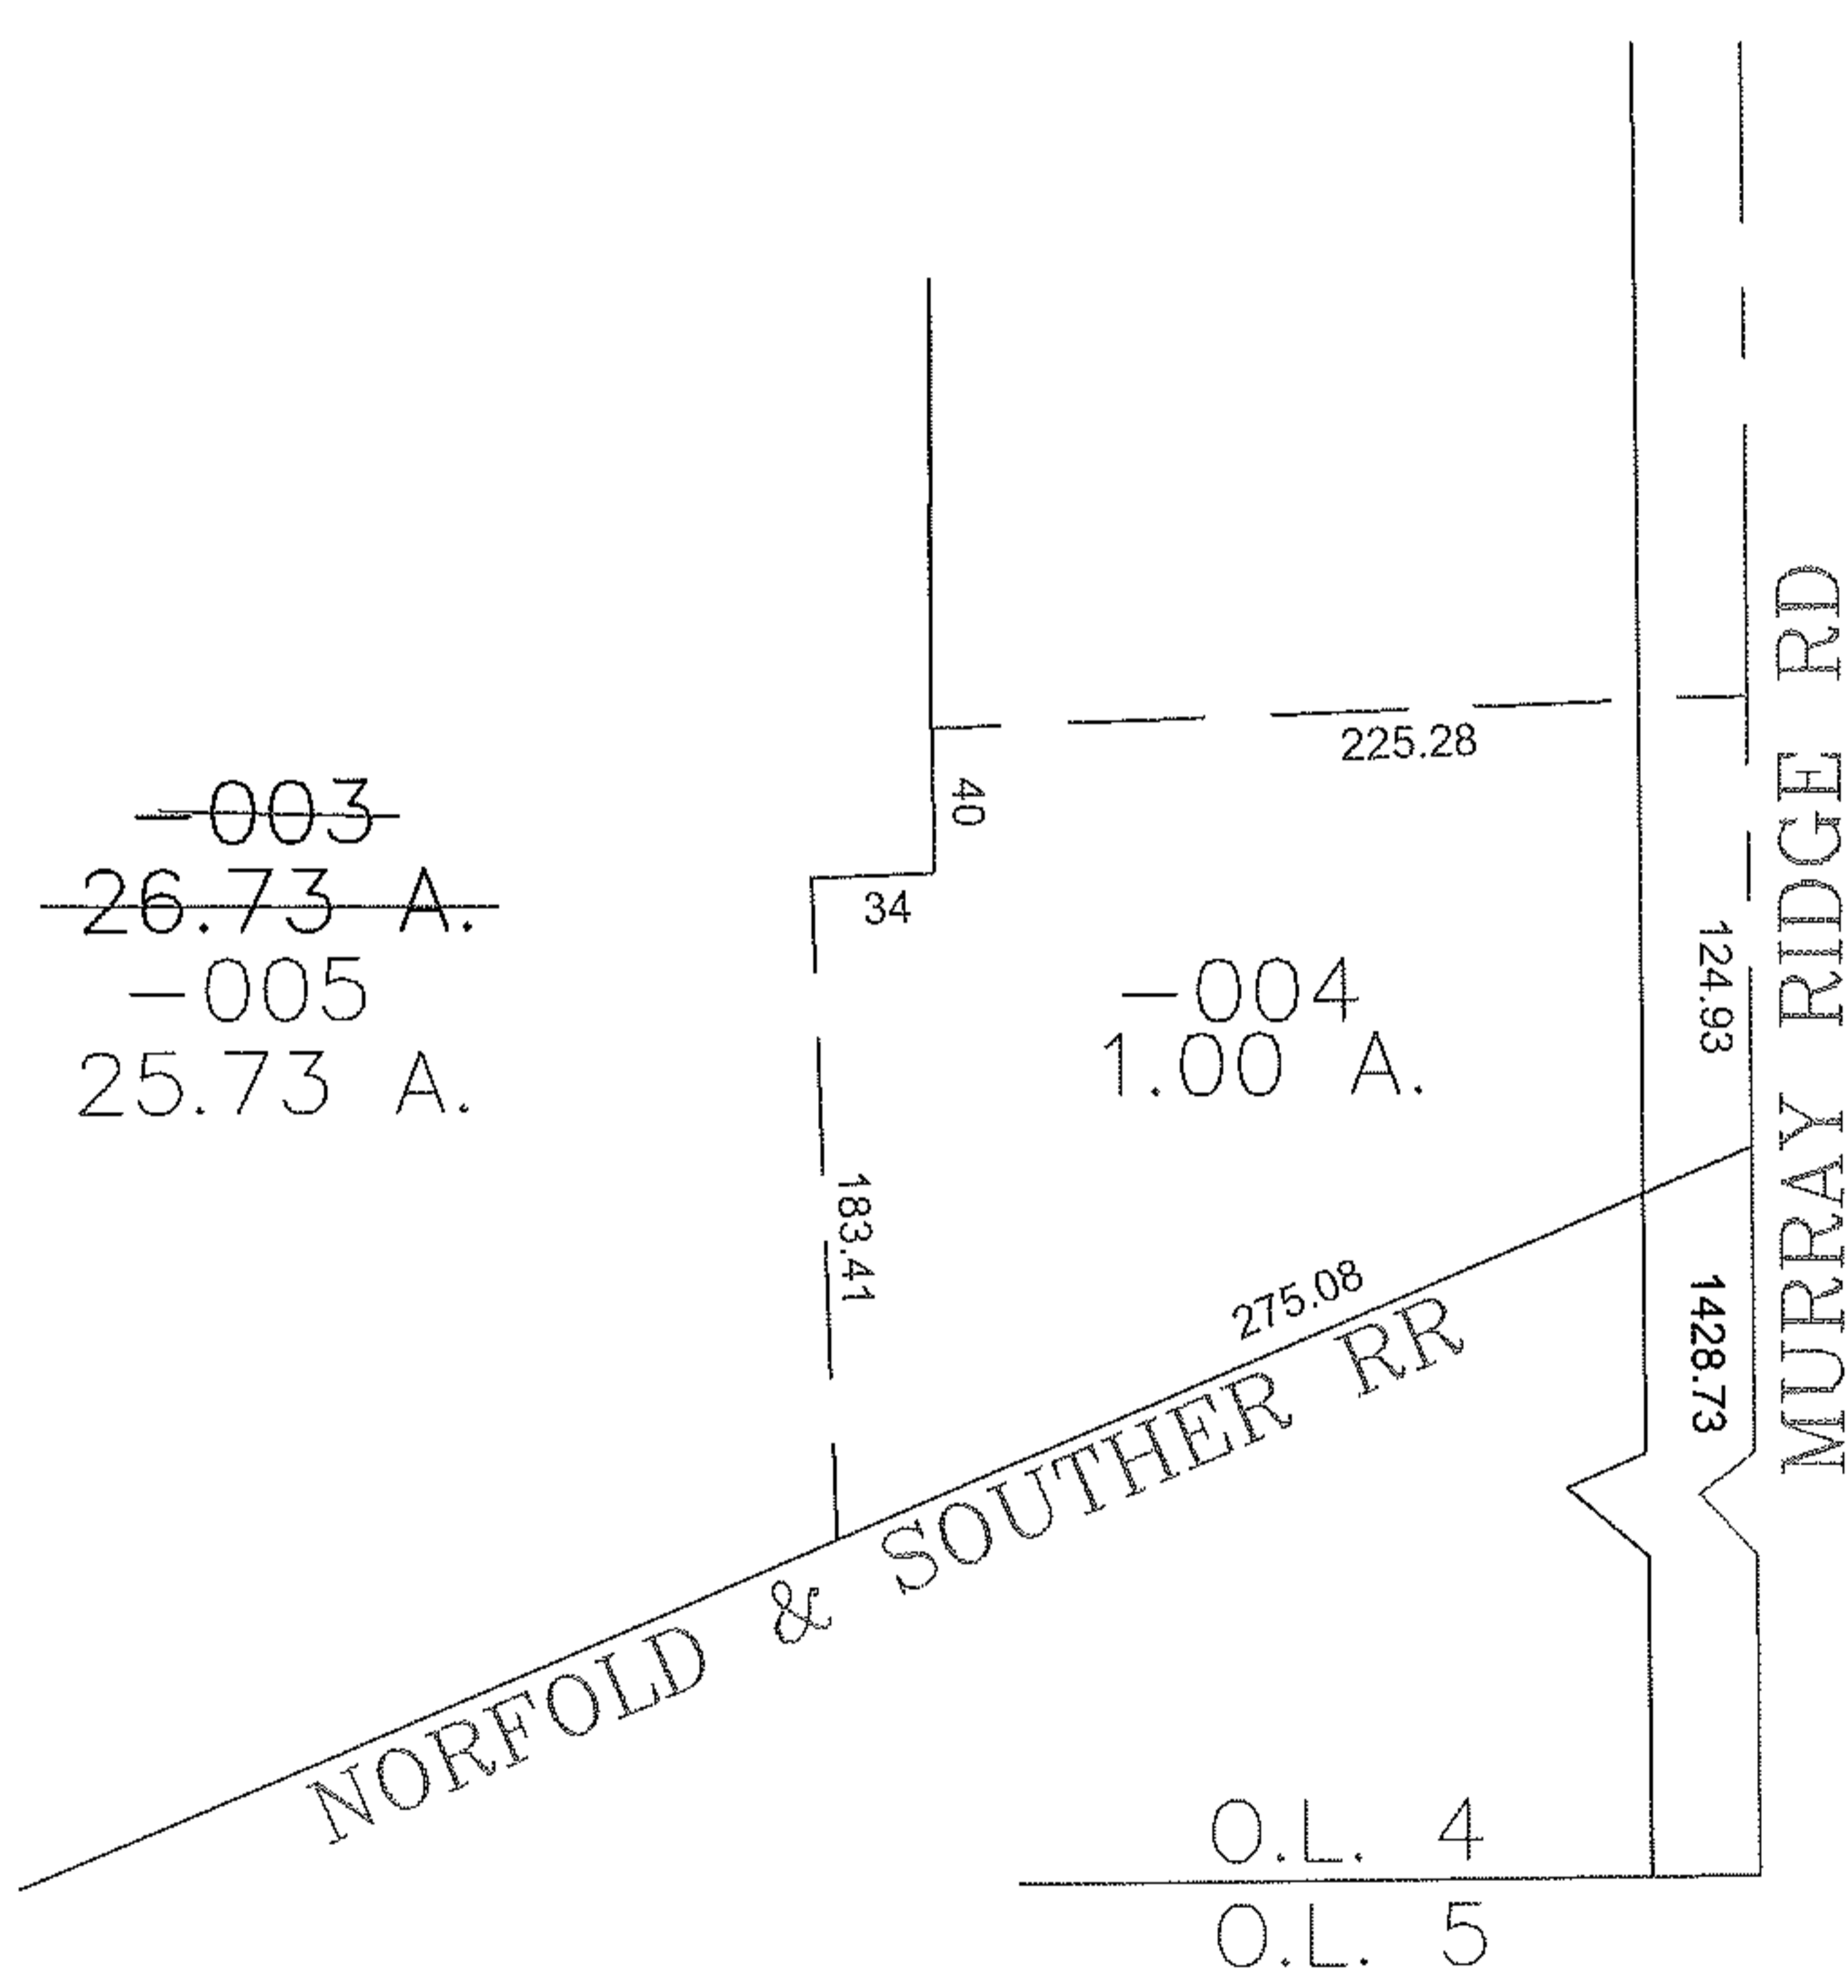


PARENT PARCEL: 06-23-002-101-003

CHILD PARCEL: 06-23-002-101-004, -005

STARTING POINT: CENTERLINE OF MURRAY RIDGE RD & O.L. 4

11-02947

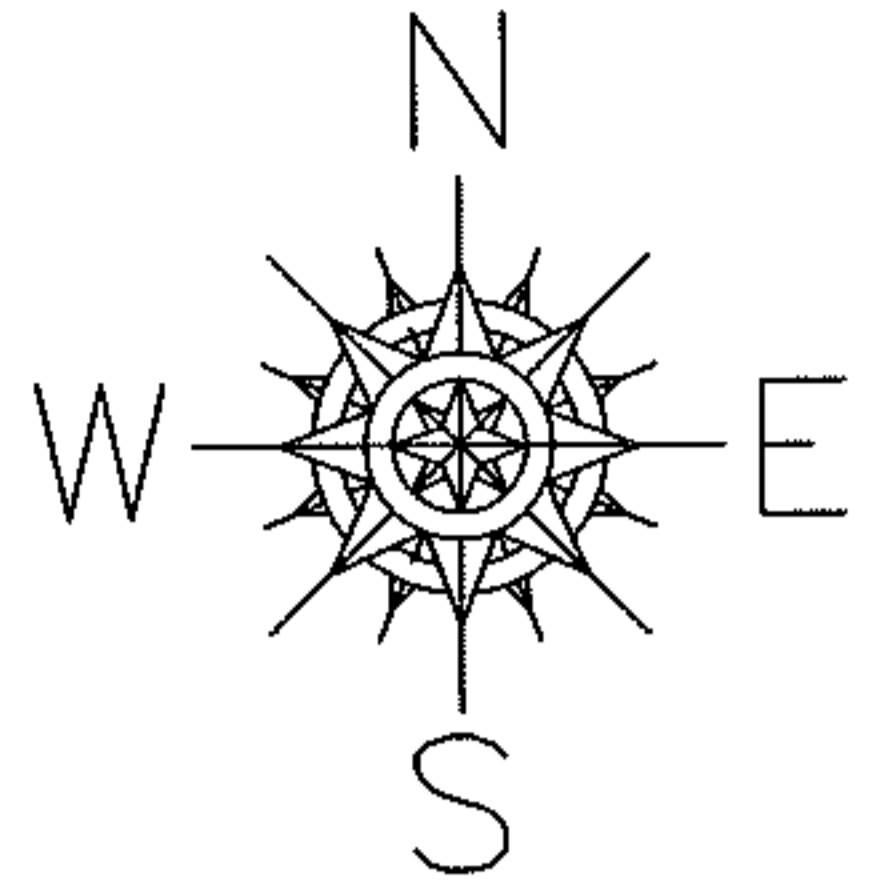

SPLITS/DEEDS PROCESSED

LORAIN COUNTY TAX MAP DEPARTMENT
226 MIDDLE AVE. ELYRIA, OHIO

SURVEYED BY: THOMAS SIMON

CLOSURE: 0.00 : 10,000

MAP PAGE(S): 6-21, 6-22

APPROVED BY: JAH DATE: 9-12-2011

SCALE: 1" = 100 PRIOR INSTRUMENT: DV 1418/234