
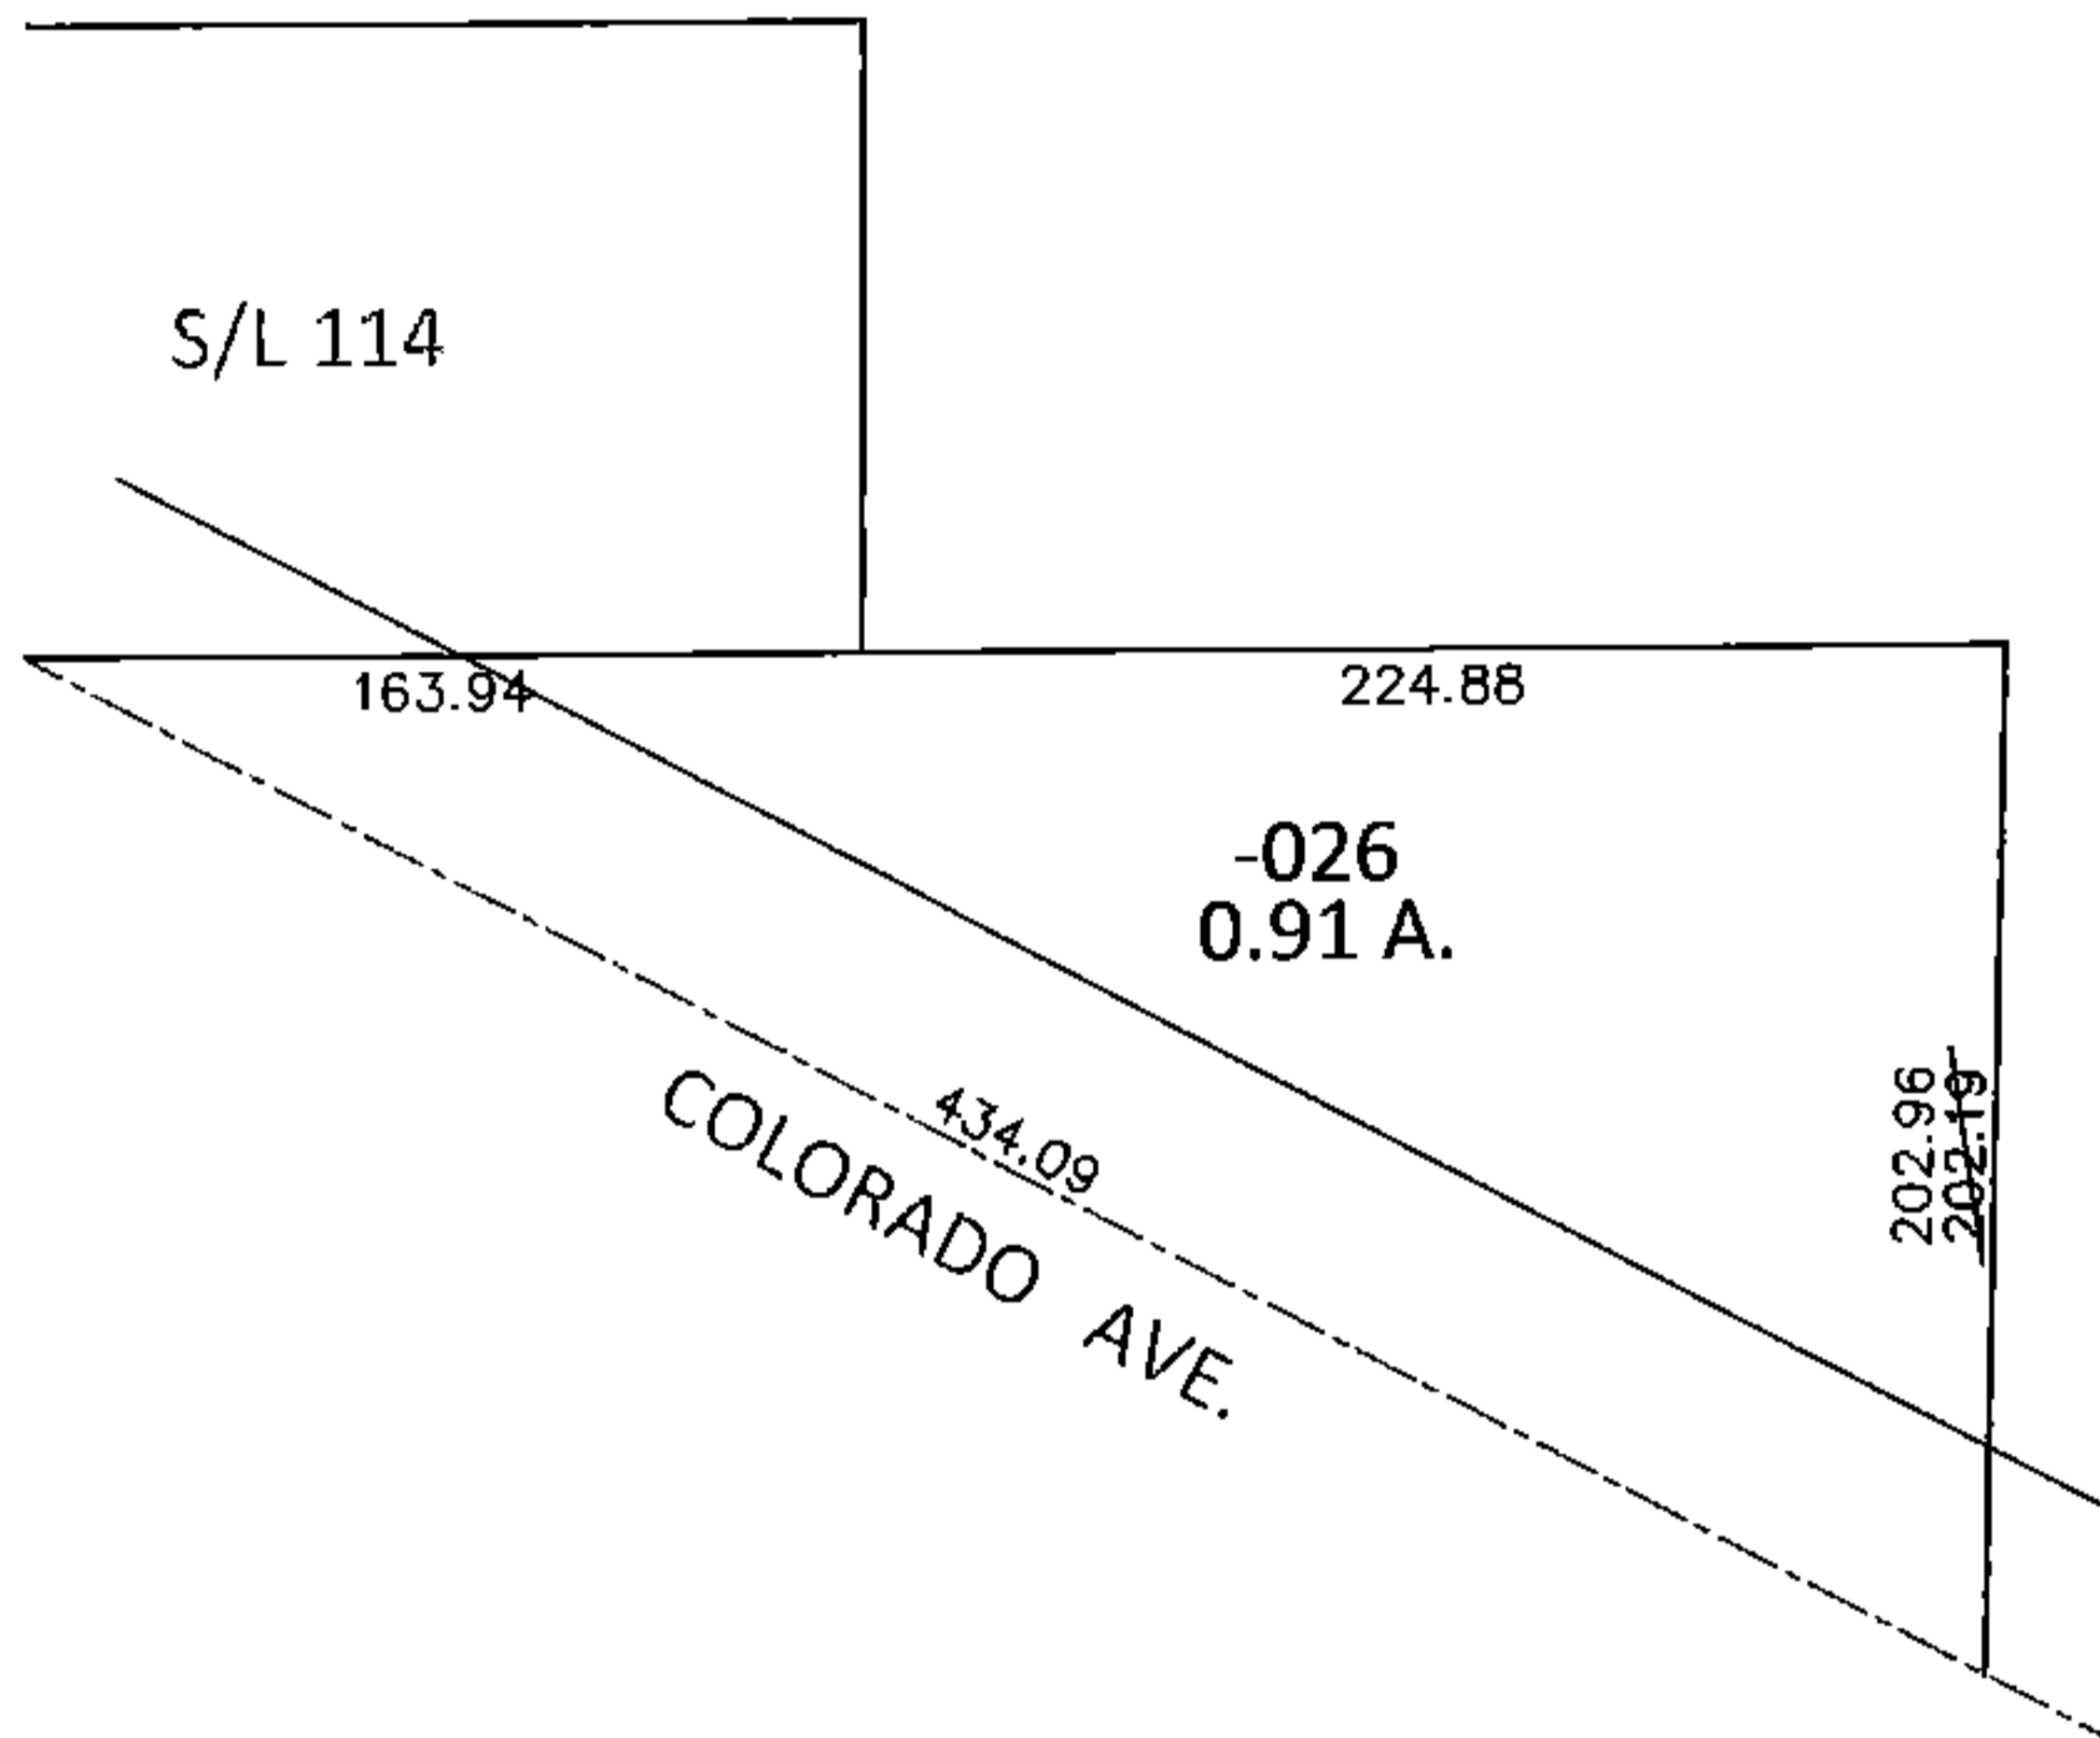


PARENT PARCEL: 04-00-010-106-026


CHILD PARCEL: _____

STARTING POINT: SOUTHEAST CORNER OF S/L 114 IN EATON SUB. NO.3 (VOL.17 PG.36)

14-02951-X

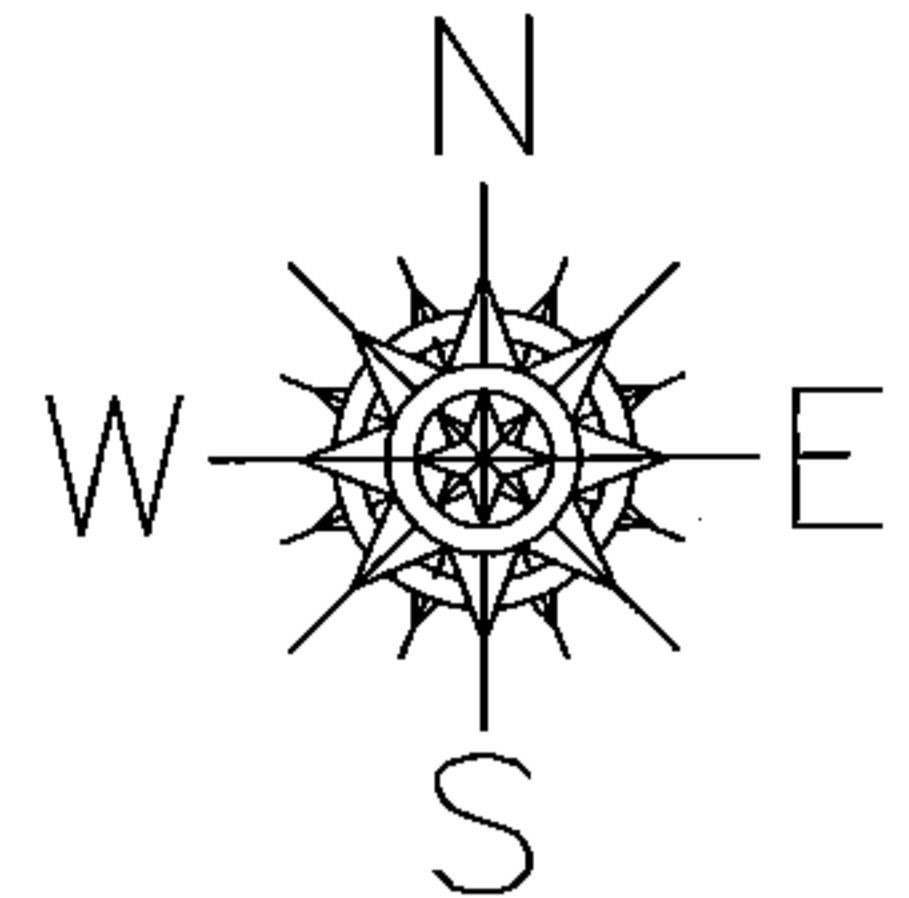

MAP CORRECTION ONLY

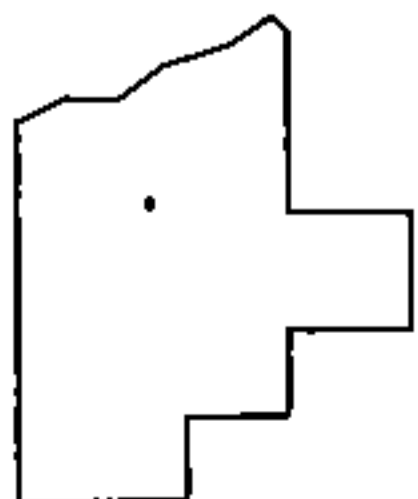

SPLITS/DEEDS PROCESSED

LORAIN COUNTY TAX MAP DEPARTMENT
226 MIDDLE AVE. ELYRIA, OHIO

SURVEYED BY: DALE R. HAYWOOD

CLOSURE: .01:10,000

MAP PAGE(S): 4-00-010-B

APPROVED BY: RRM DATE: 5-30-14

SCALE: 1"= 100 PRIOR INST.: 20140492901