
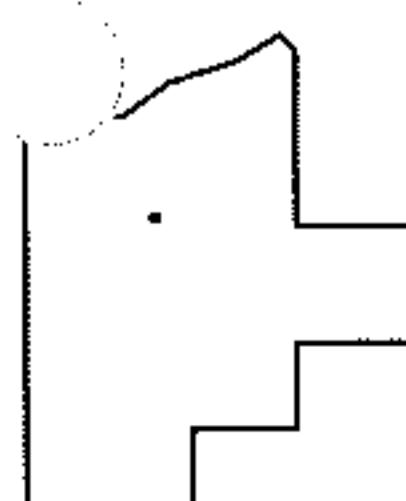
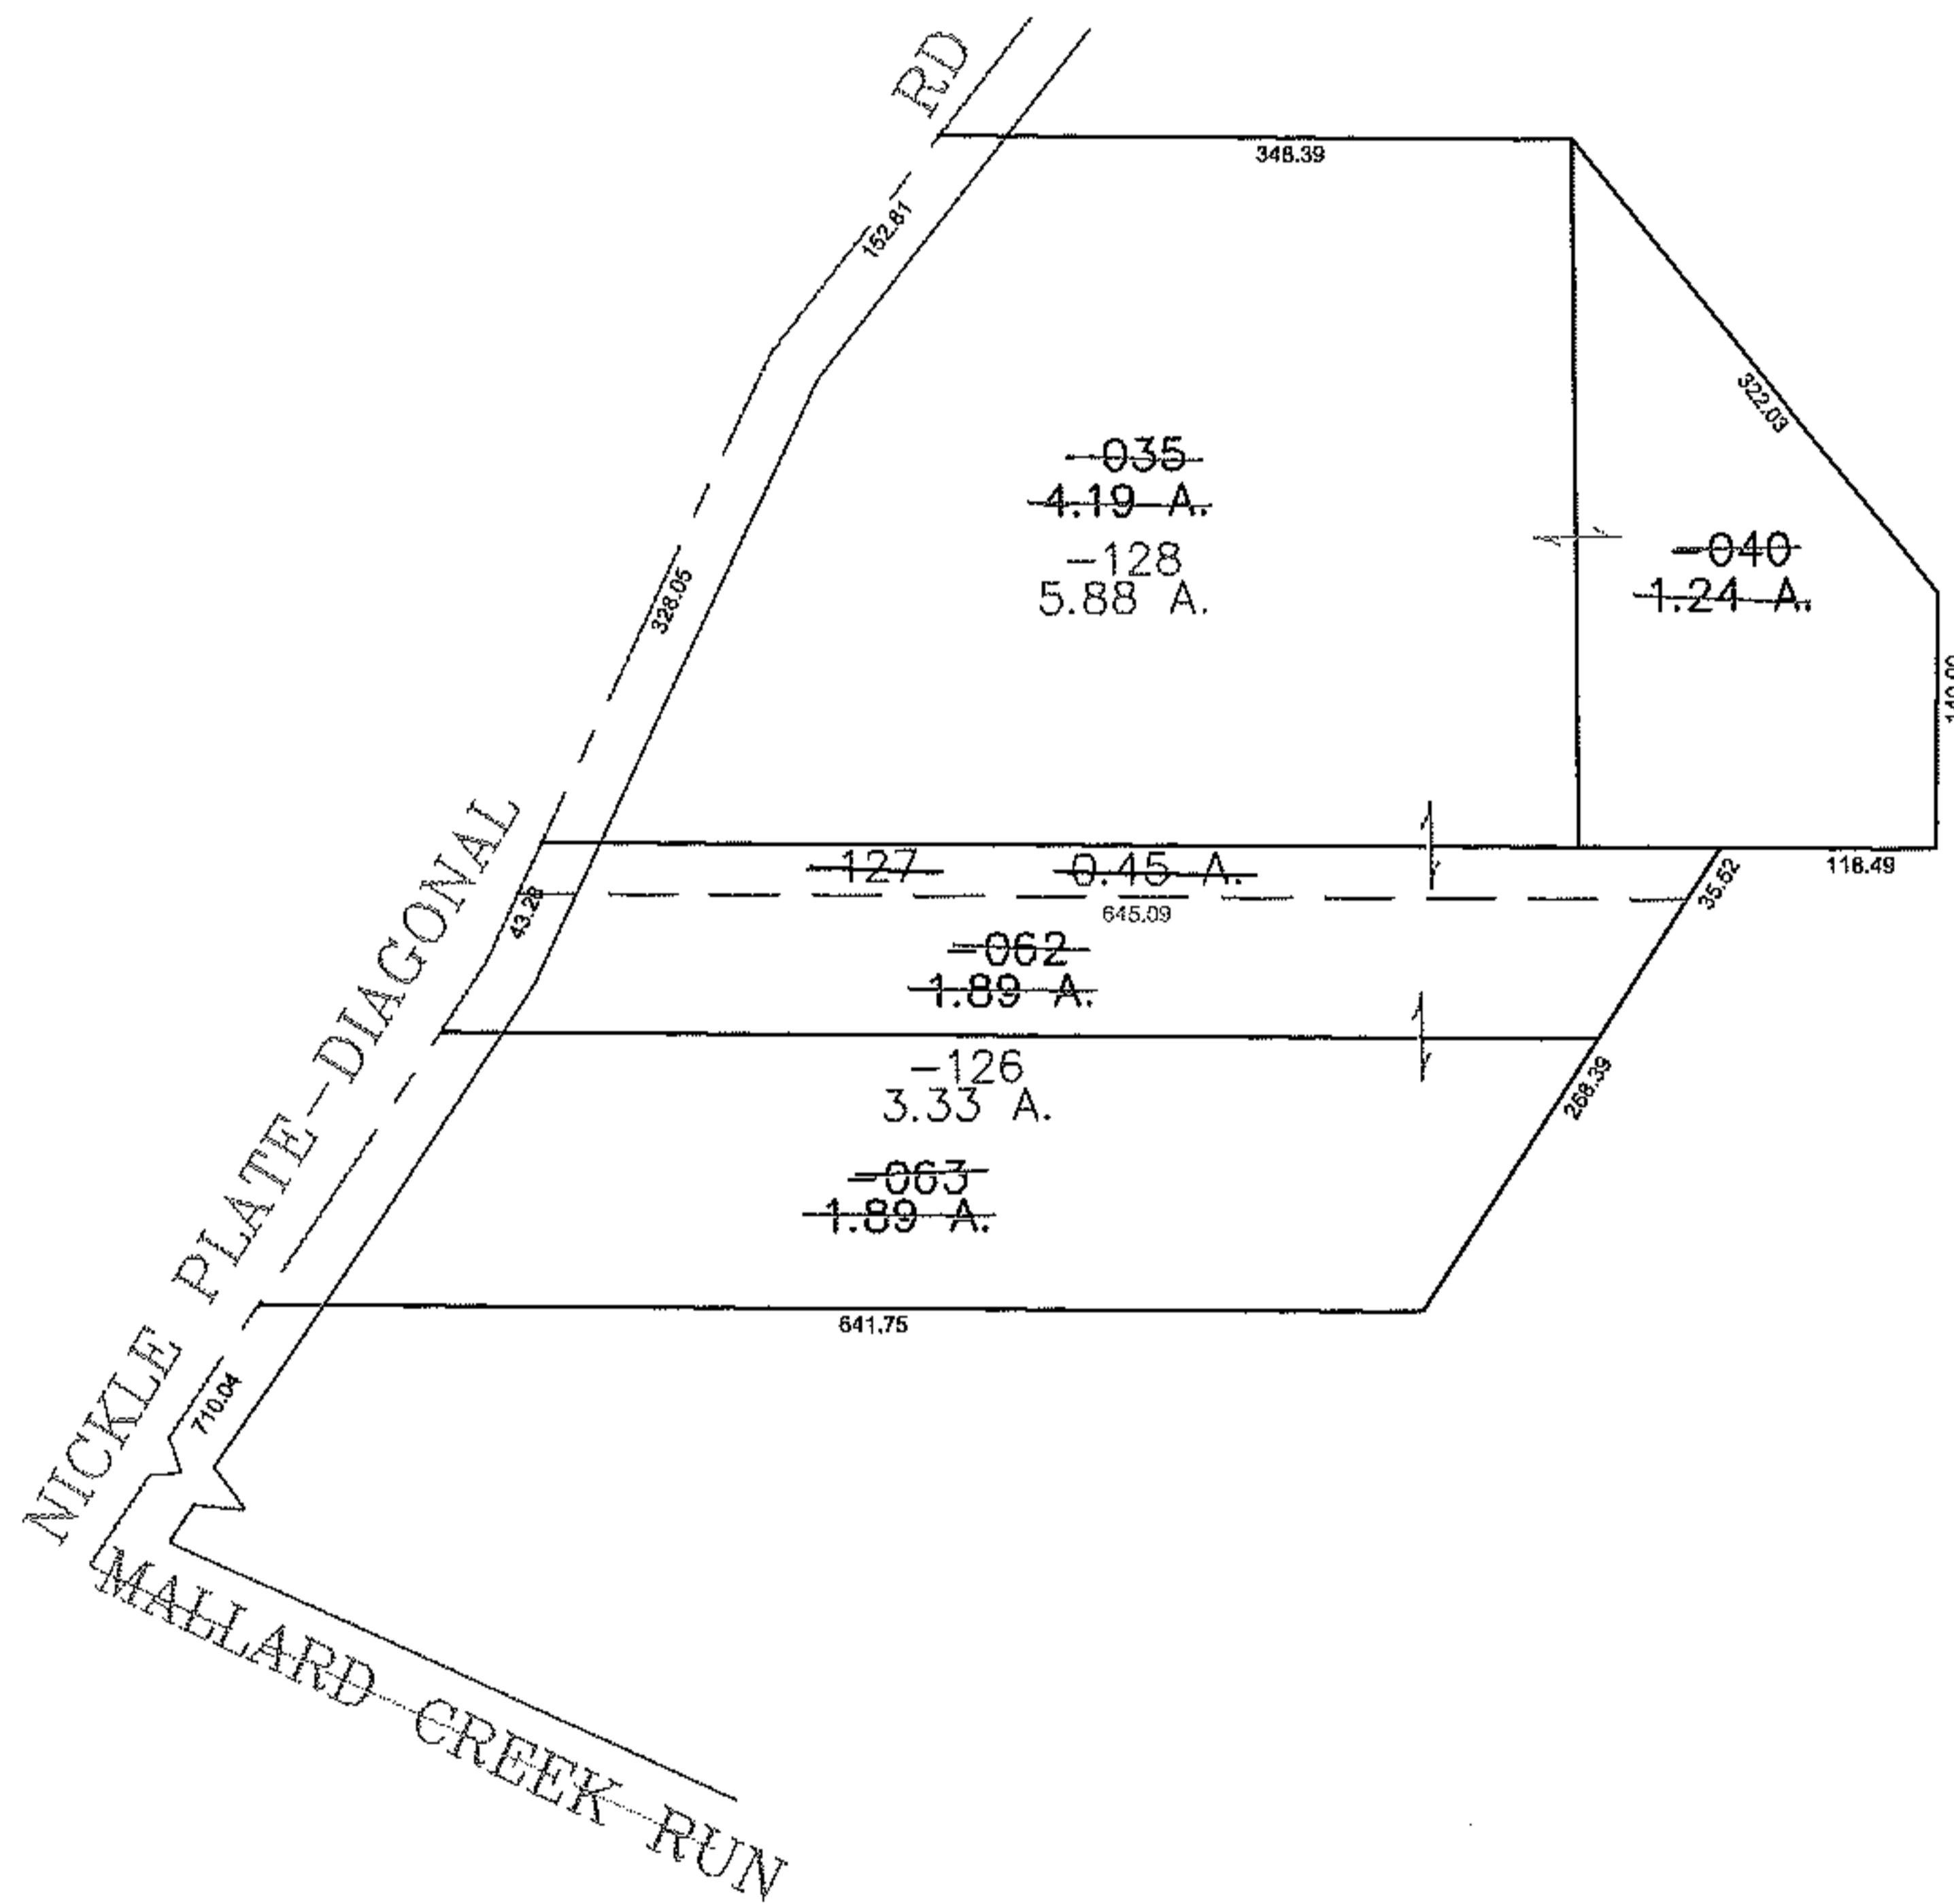


PARENT PARCEL: 10-00-019-000-062, -063, -035, -040

CHILD PARCEL: 10-00-019-000-126, -127, -128

11-02951

STARTING POINT: CENTERLINE OF NICKLE PLATE-DIAGONAL RD & MALLARD CREEK RUN

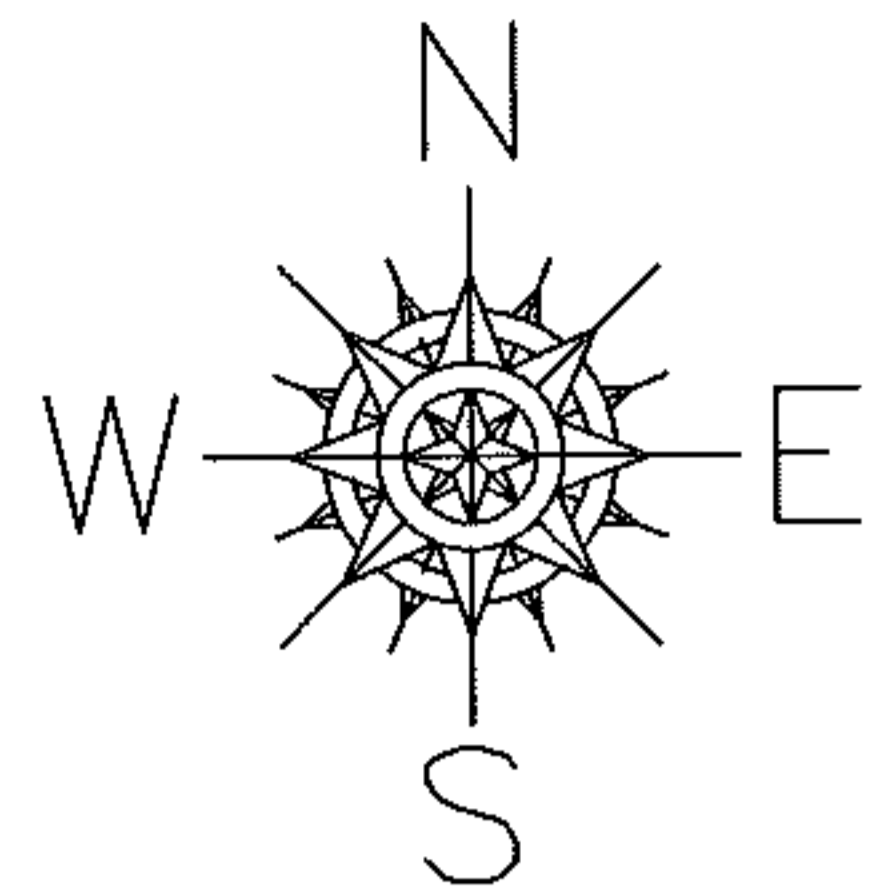

**SPLITS/DEEDS PROCESSED**  
 LORAIN COUNTY TAX MAP DEPARTMENT  
 226 MIDDLE AVE. ELYRIA, OHIO

SURVEYED BY: RICHARD FREDRICKSON  
 CLOSURE: 0.00 : 10,000  
 MAP PAGE(S): 10-F  
 APPROVED BY: JAH DATE: 10-7-2011  
 SCALE: 1" = 200' PRIOR INSTRUMENT: 20090313565