
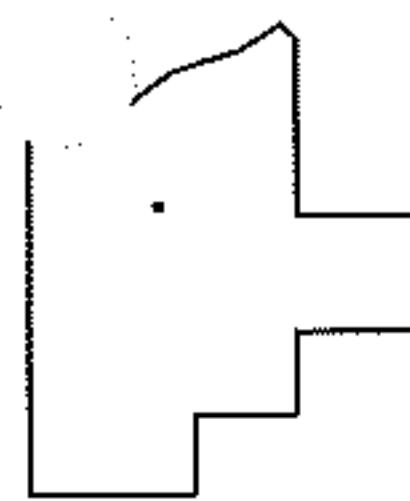


PARENT PARCEL: 10-00-017-000-019 & -040
CHILD PARCEL: 10-00-017-000-051 THRU -054
STARTING POINT: MON. BOX, CL OF SLIFE RD. & N.W. CORNER OF SECTION 17

11-02953

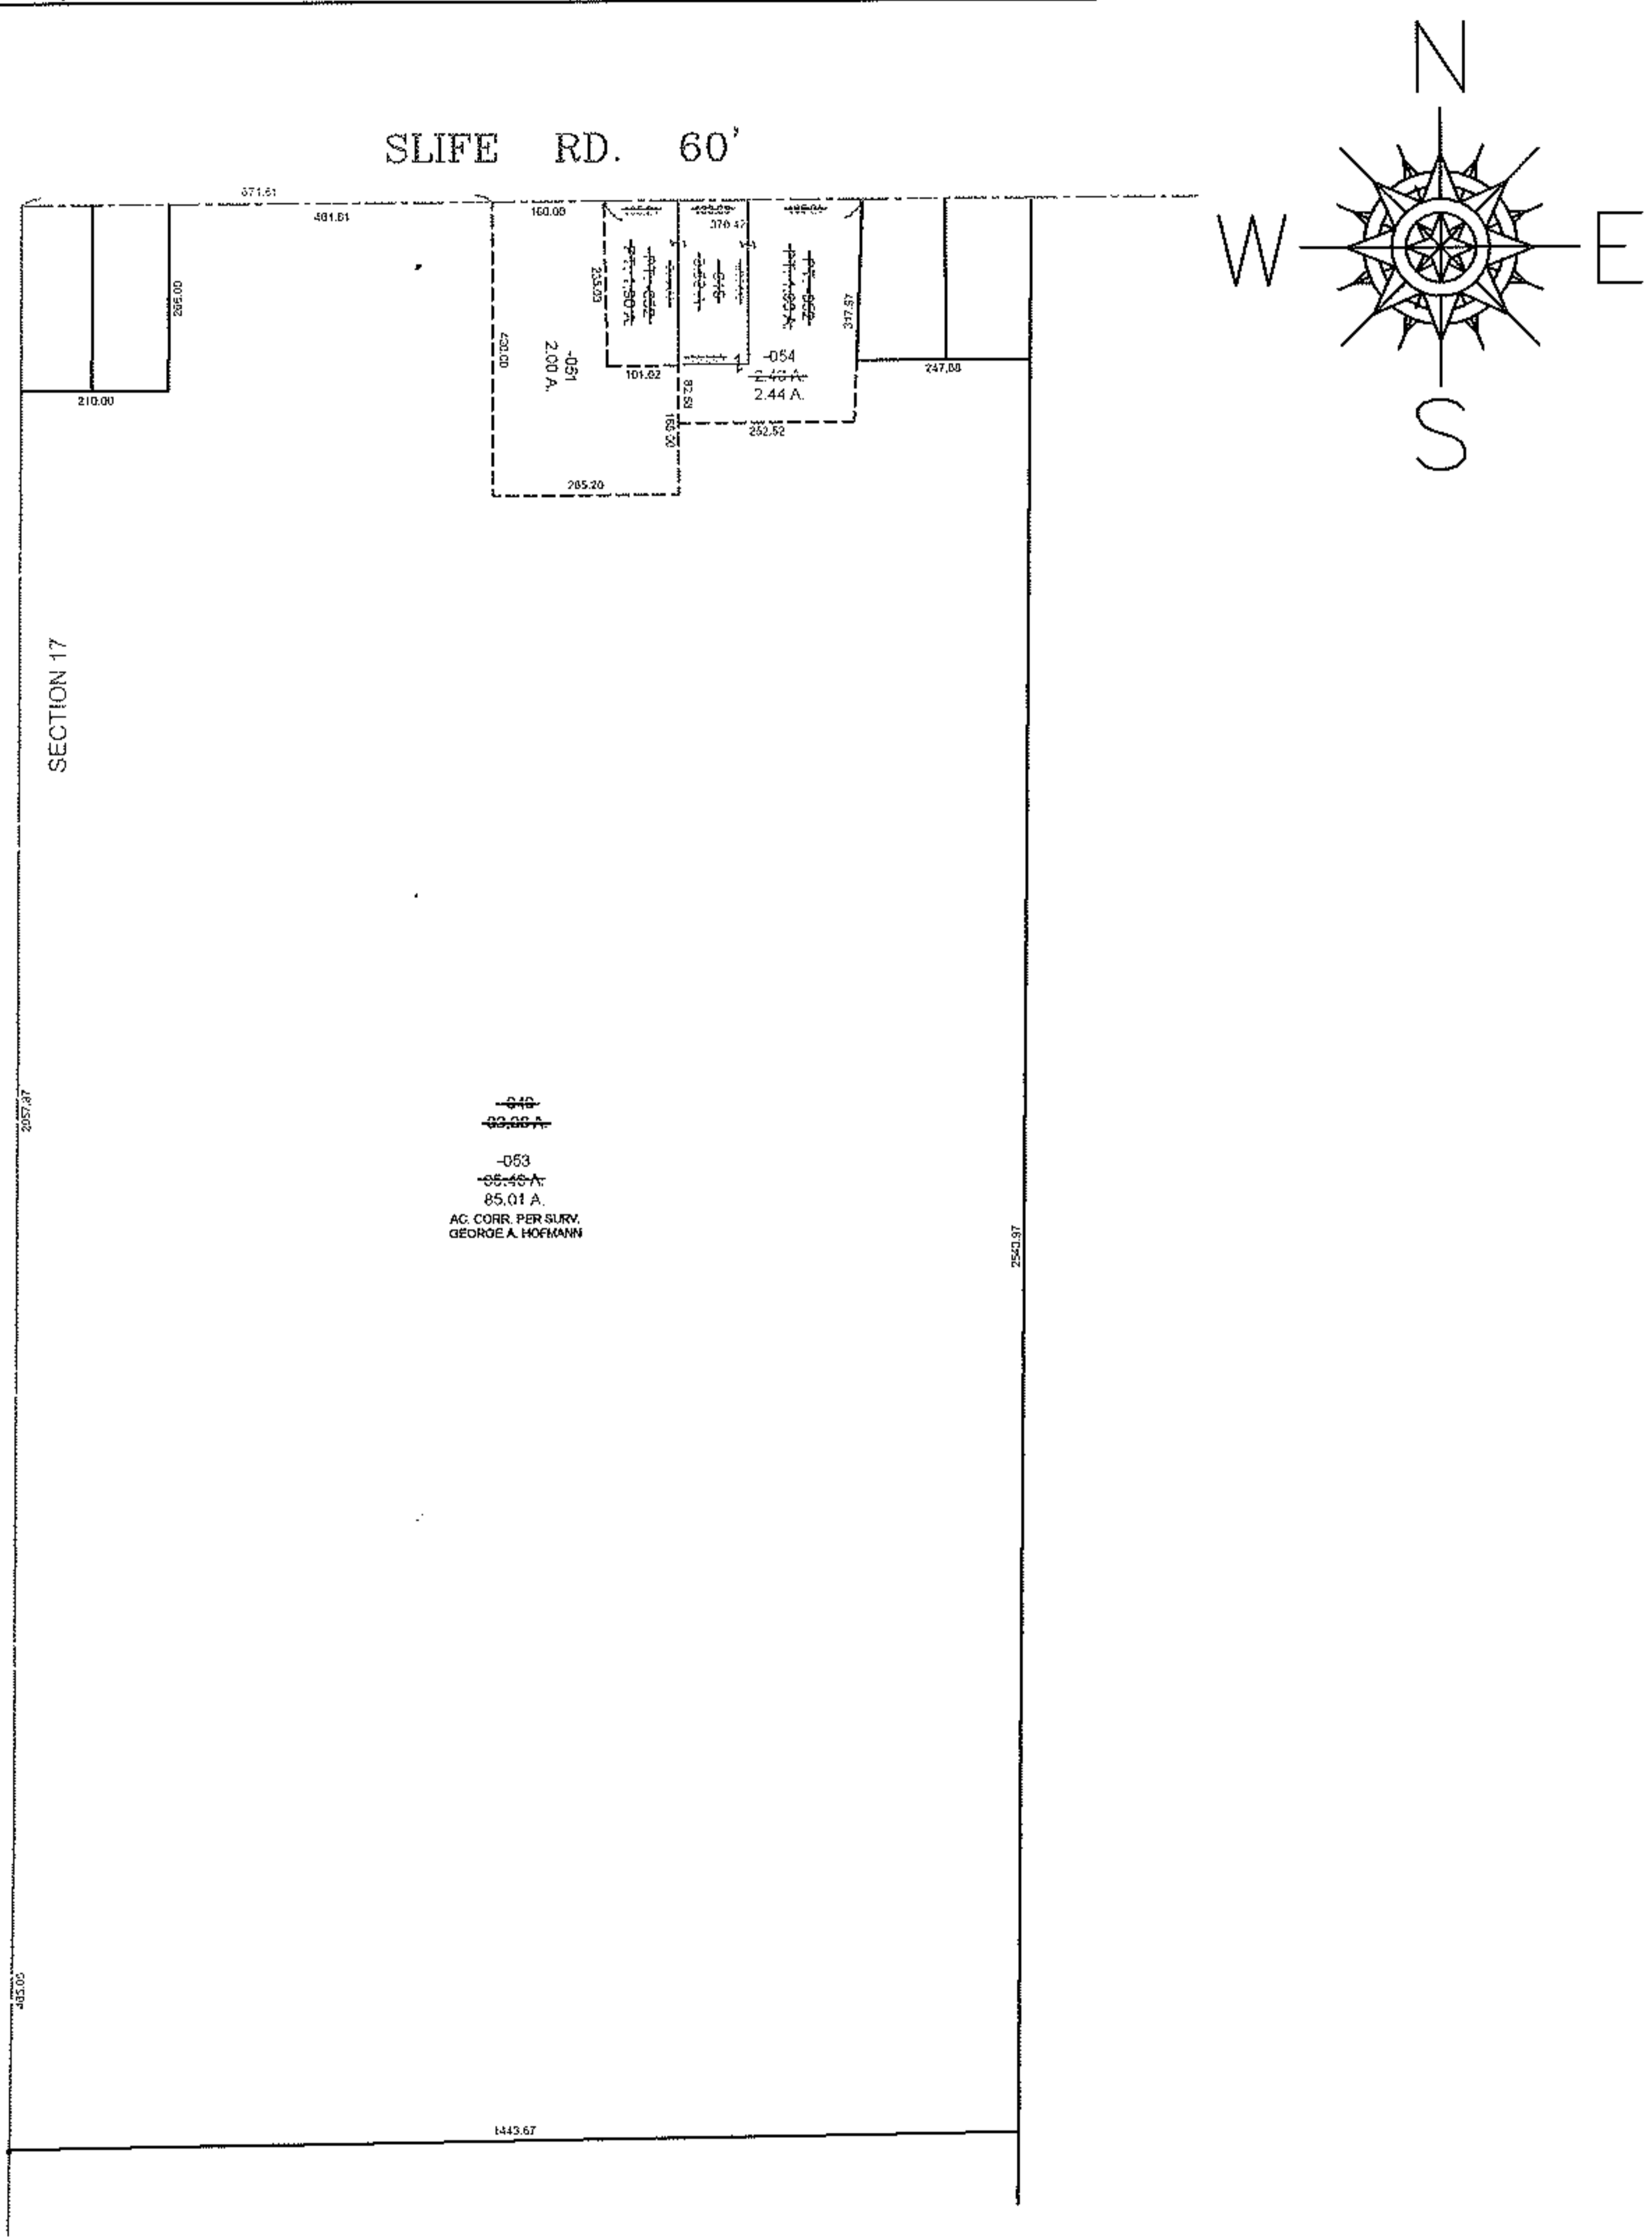

SPLITS/DEEDS PROCESSED
LORAIN COUNTY TAX MAP DEPARTMENT
226 MIDDLE AVE. ELYRIA, OHIO

SURVEYED BY: GEORGE A. HOFMANN
CLOSURE: 0.01 : 10,000
MAP PAGE(S): 10-G
APPROVED BY: TJS DATE: 10/17/11
SCALE: 1" = 400 PRIOR INST.: 20110387620