
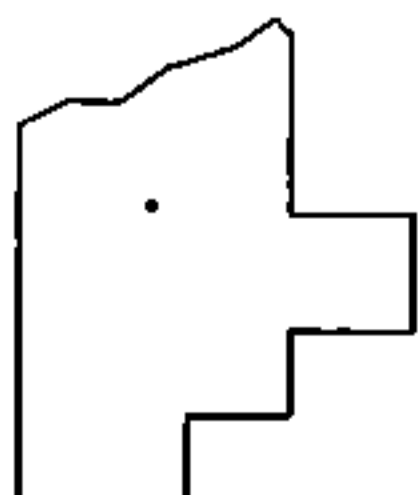
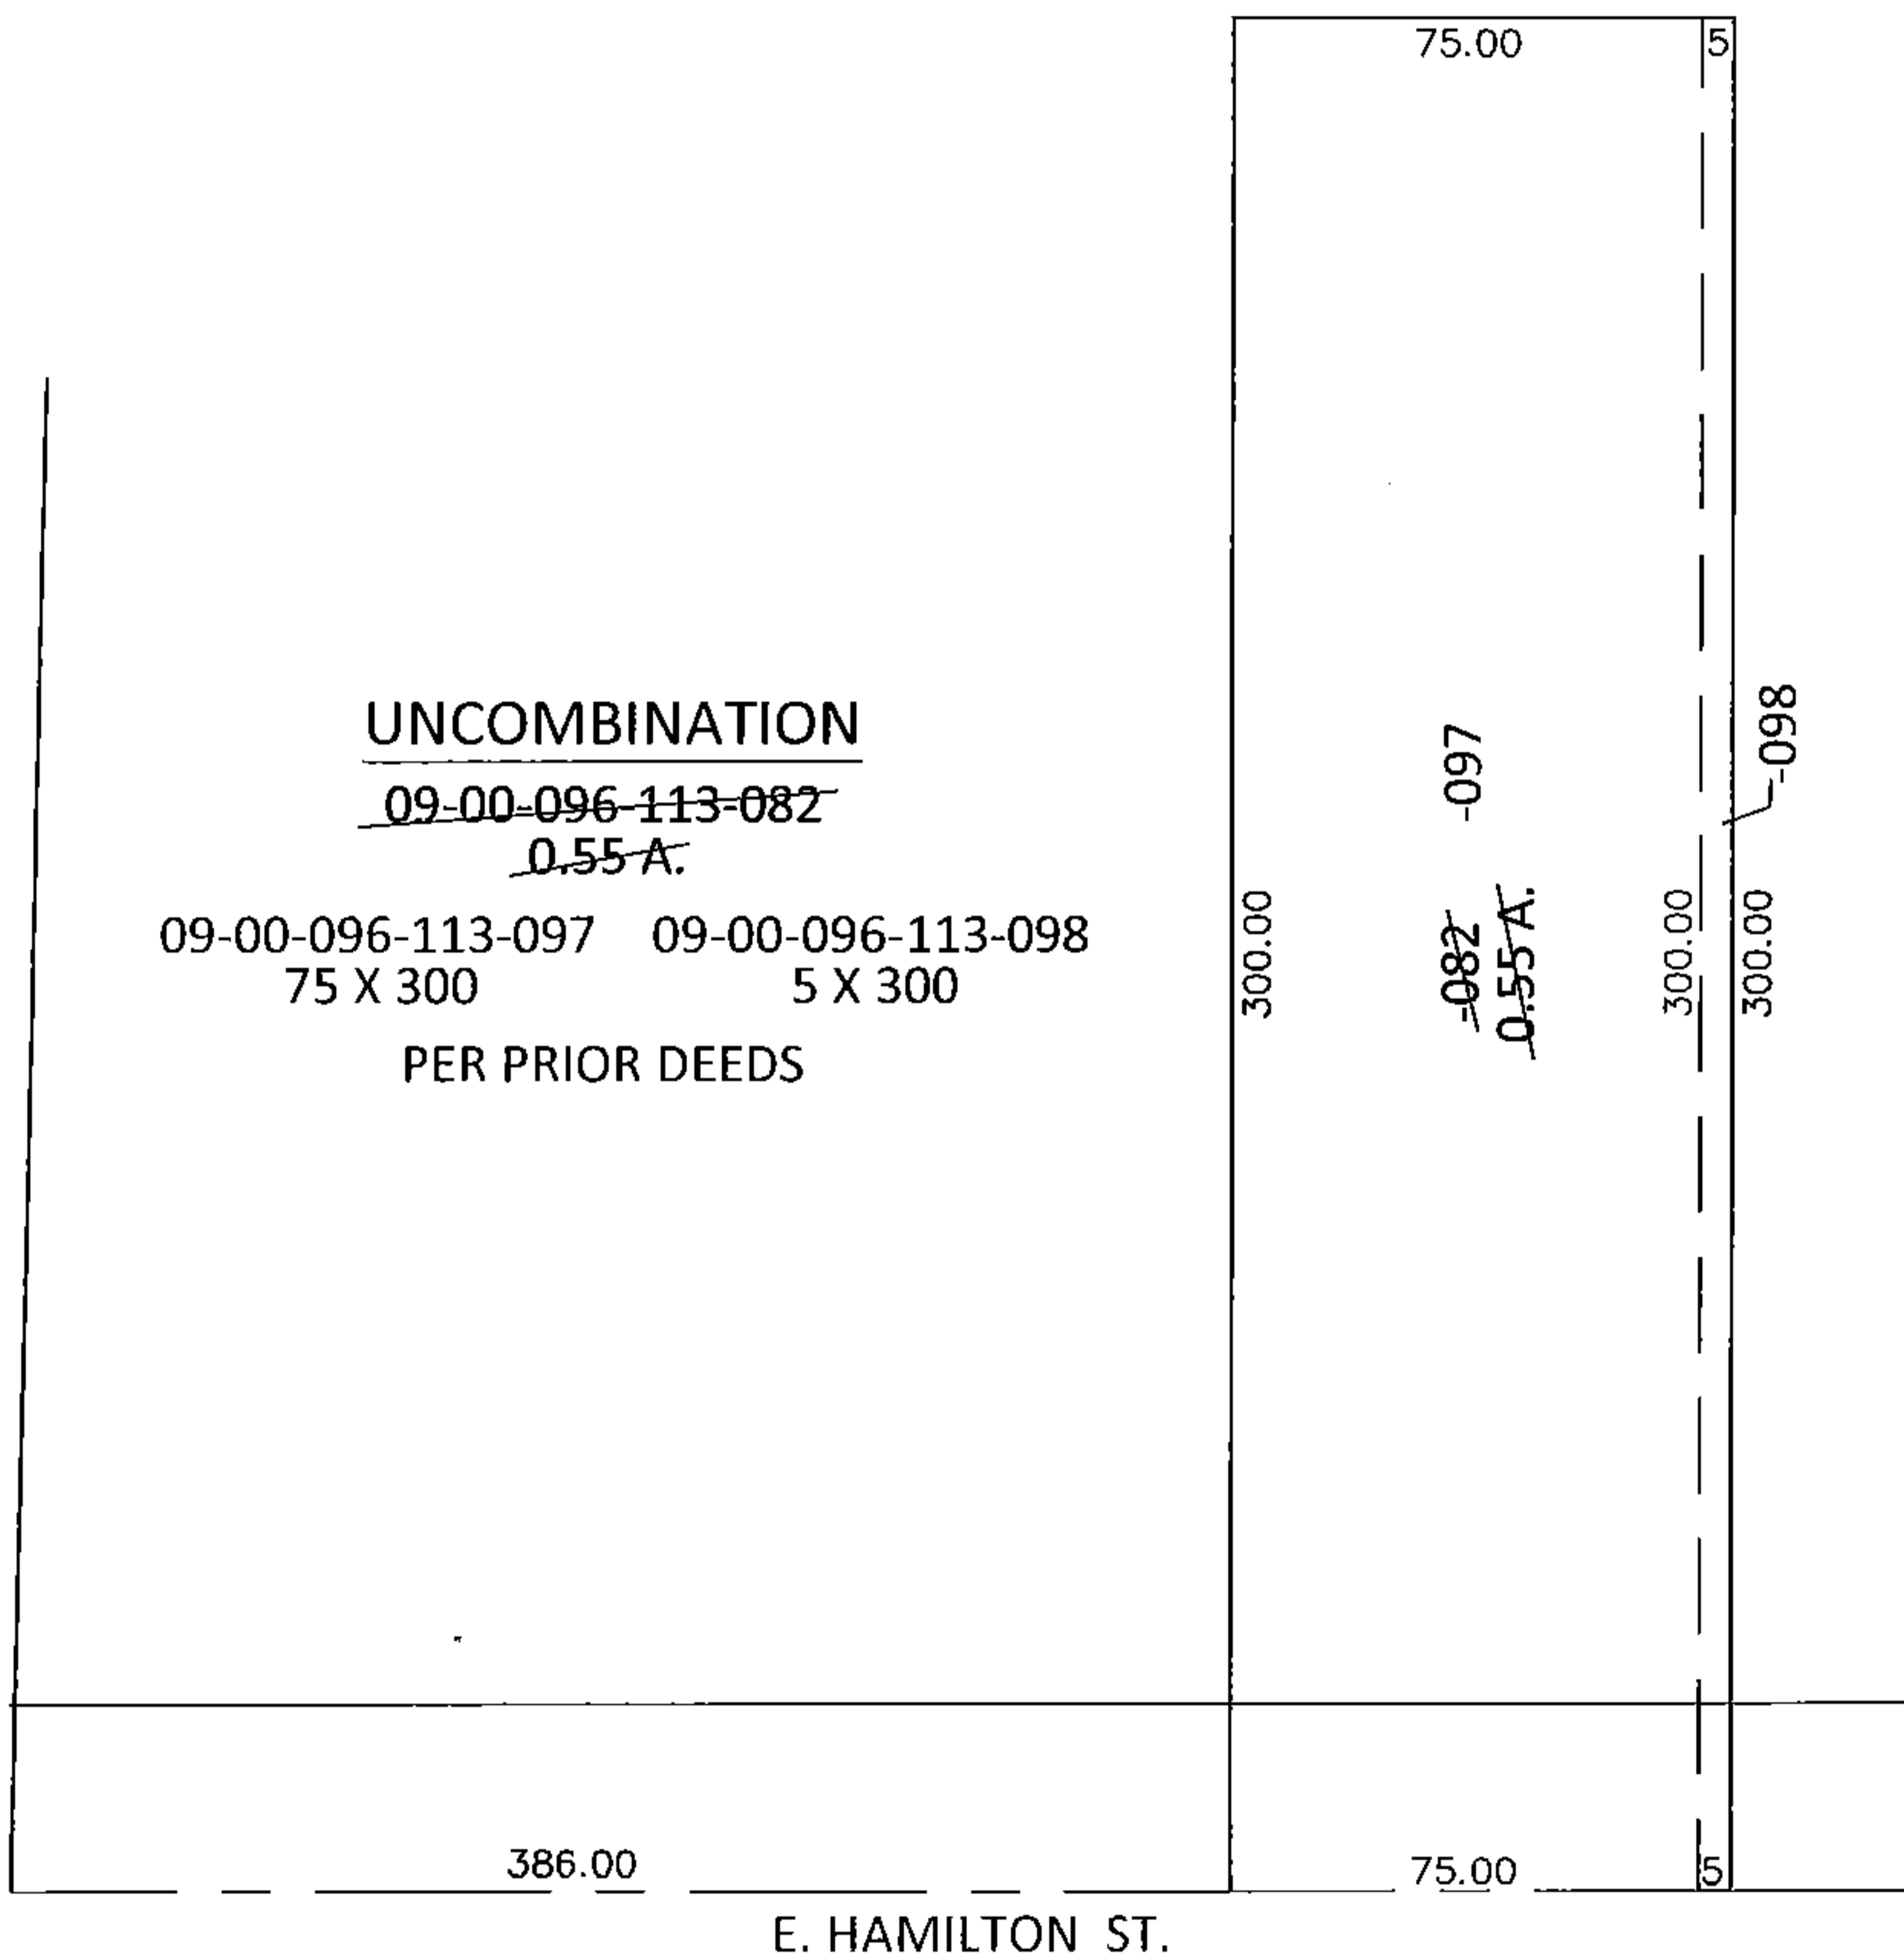


PARENT PARCEL: 09-00-096-113-082

CHILD PARCEL: 09-00-096-113-097, -098

14-02955-X

STARTING POINT: SOUTHEAST CORNER OF LAND CONVEYED TO DOLLINE DOUB & RUBY JONES (DV 426/230)

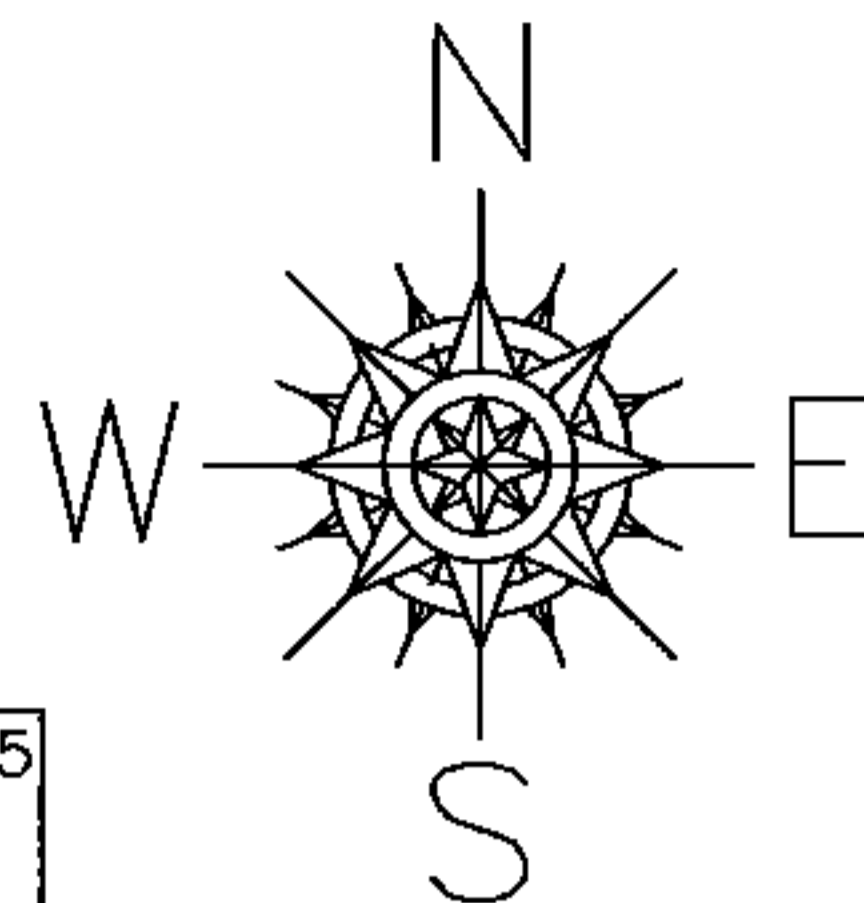

SPLITS/DEEDS PROCESSED

LORAIN COUNTY TAX MAP DEPARTMENT
226 MIDDLE AVE. ELYRIA, OHIO

SURVEYED BY: N/A

CLOSURE: N/A

MAP PAGE(S): 9-00-096-B

APPROVED BY: RRM DATE: 6-9-14

SCALE: 1"= 50' PRIOR INST.: 20140501321