
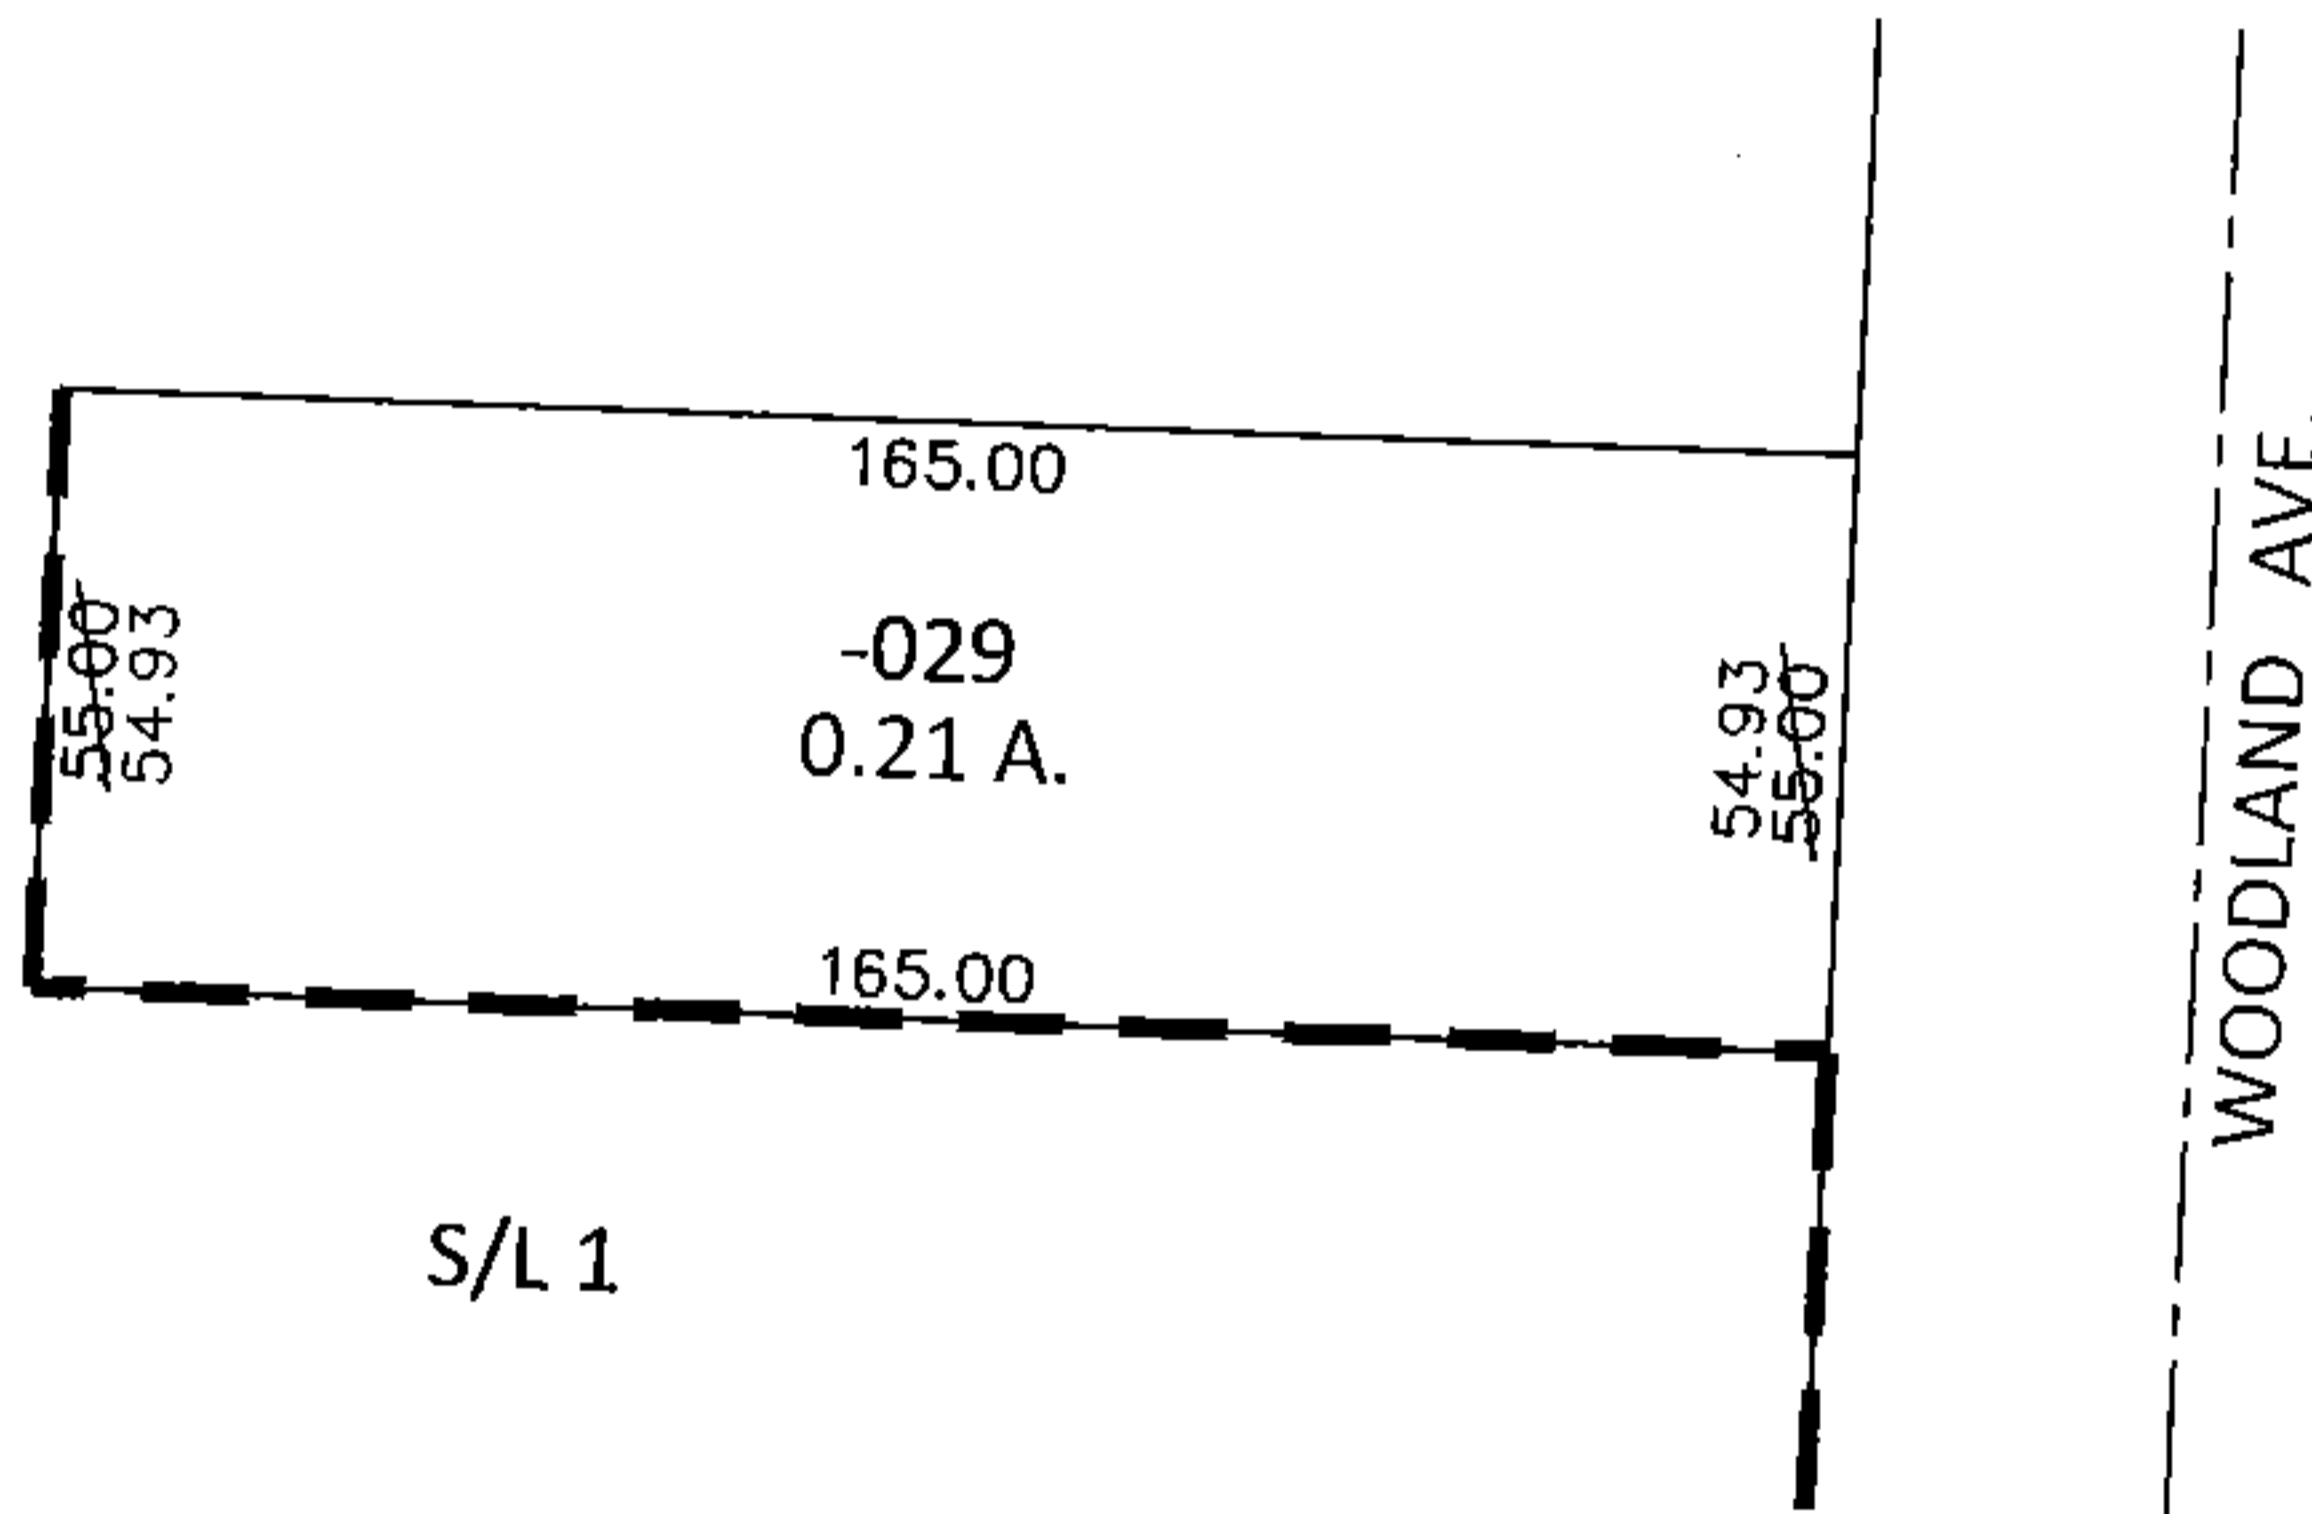


PARENT PARCEL: 06-24-026-116-029

CHILD PARCEL: \_\_\_\_\_


STARTING POINT: NORTHEAST CORNER OF S/L 1 IN J & C SCHAIBLE'S ALLOT. (VOL.8 PG.22)

14-02960-D

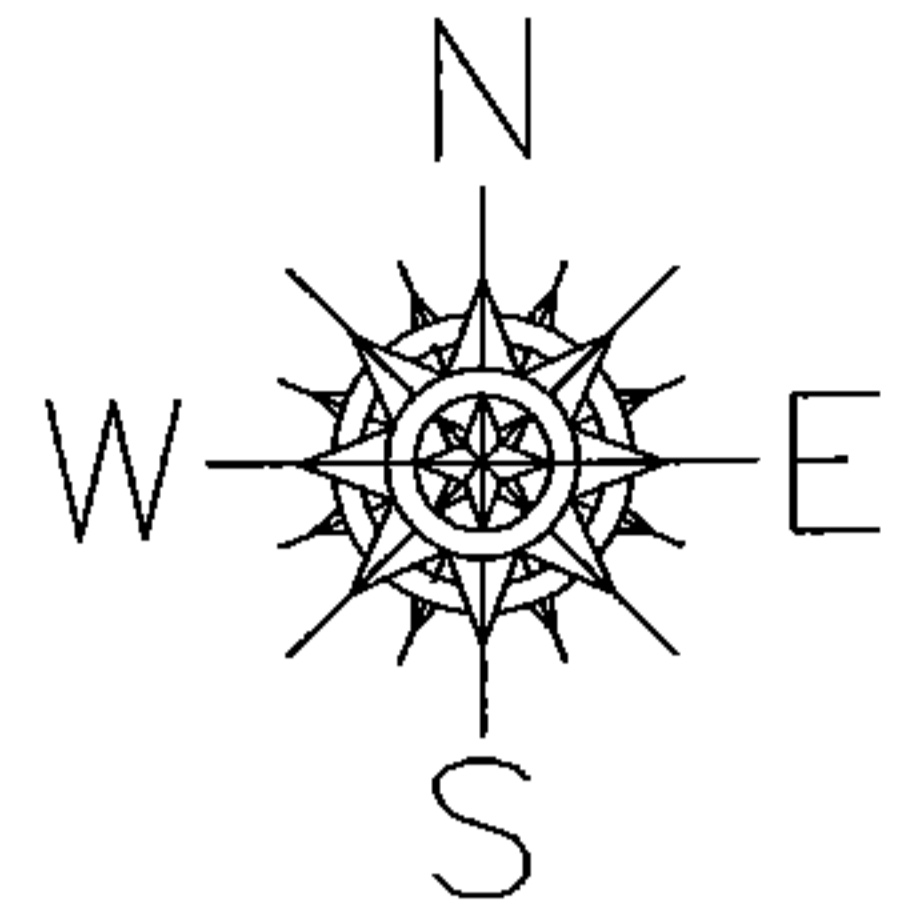

FRONTAGE AND DEPTH TO ACREAGE CORRECTION

06-24-026-116-029  
0.21 A.  
~~55 X 165~~  
PER SURV. M.MACKAY

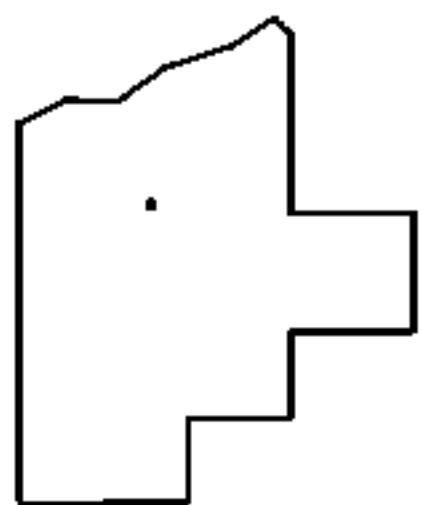

SPLITS/DEEDS PROCESSED

LORAIN COUNTY TAX MAP DEPARTMENT  
226 MIDDLE AVE. ELYRIA, OHIO

SURVEYED BY: MICHAEL MACKAY

CLOSURE: .00:10,000

MAP PAGE(S): 6-79

APPROVED BY: RRM DATE: 6-12-14

SCALE: 1" = 50' PRIOR INST.: 20130490932