
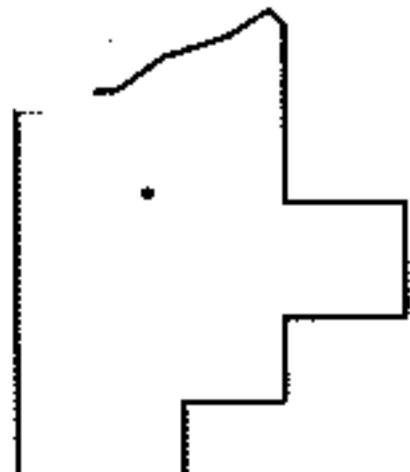
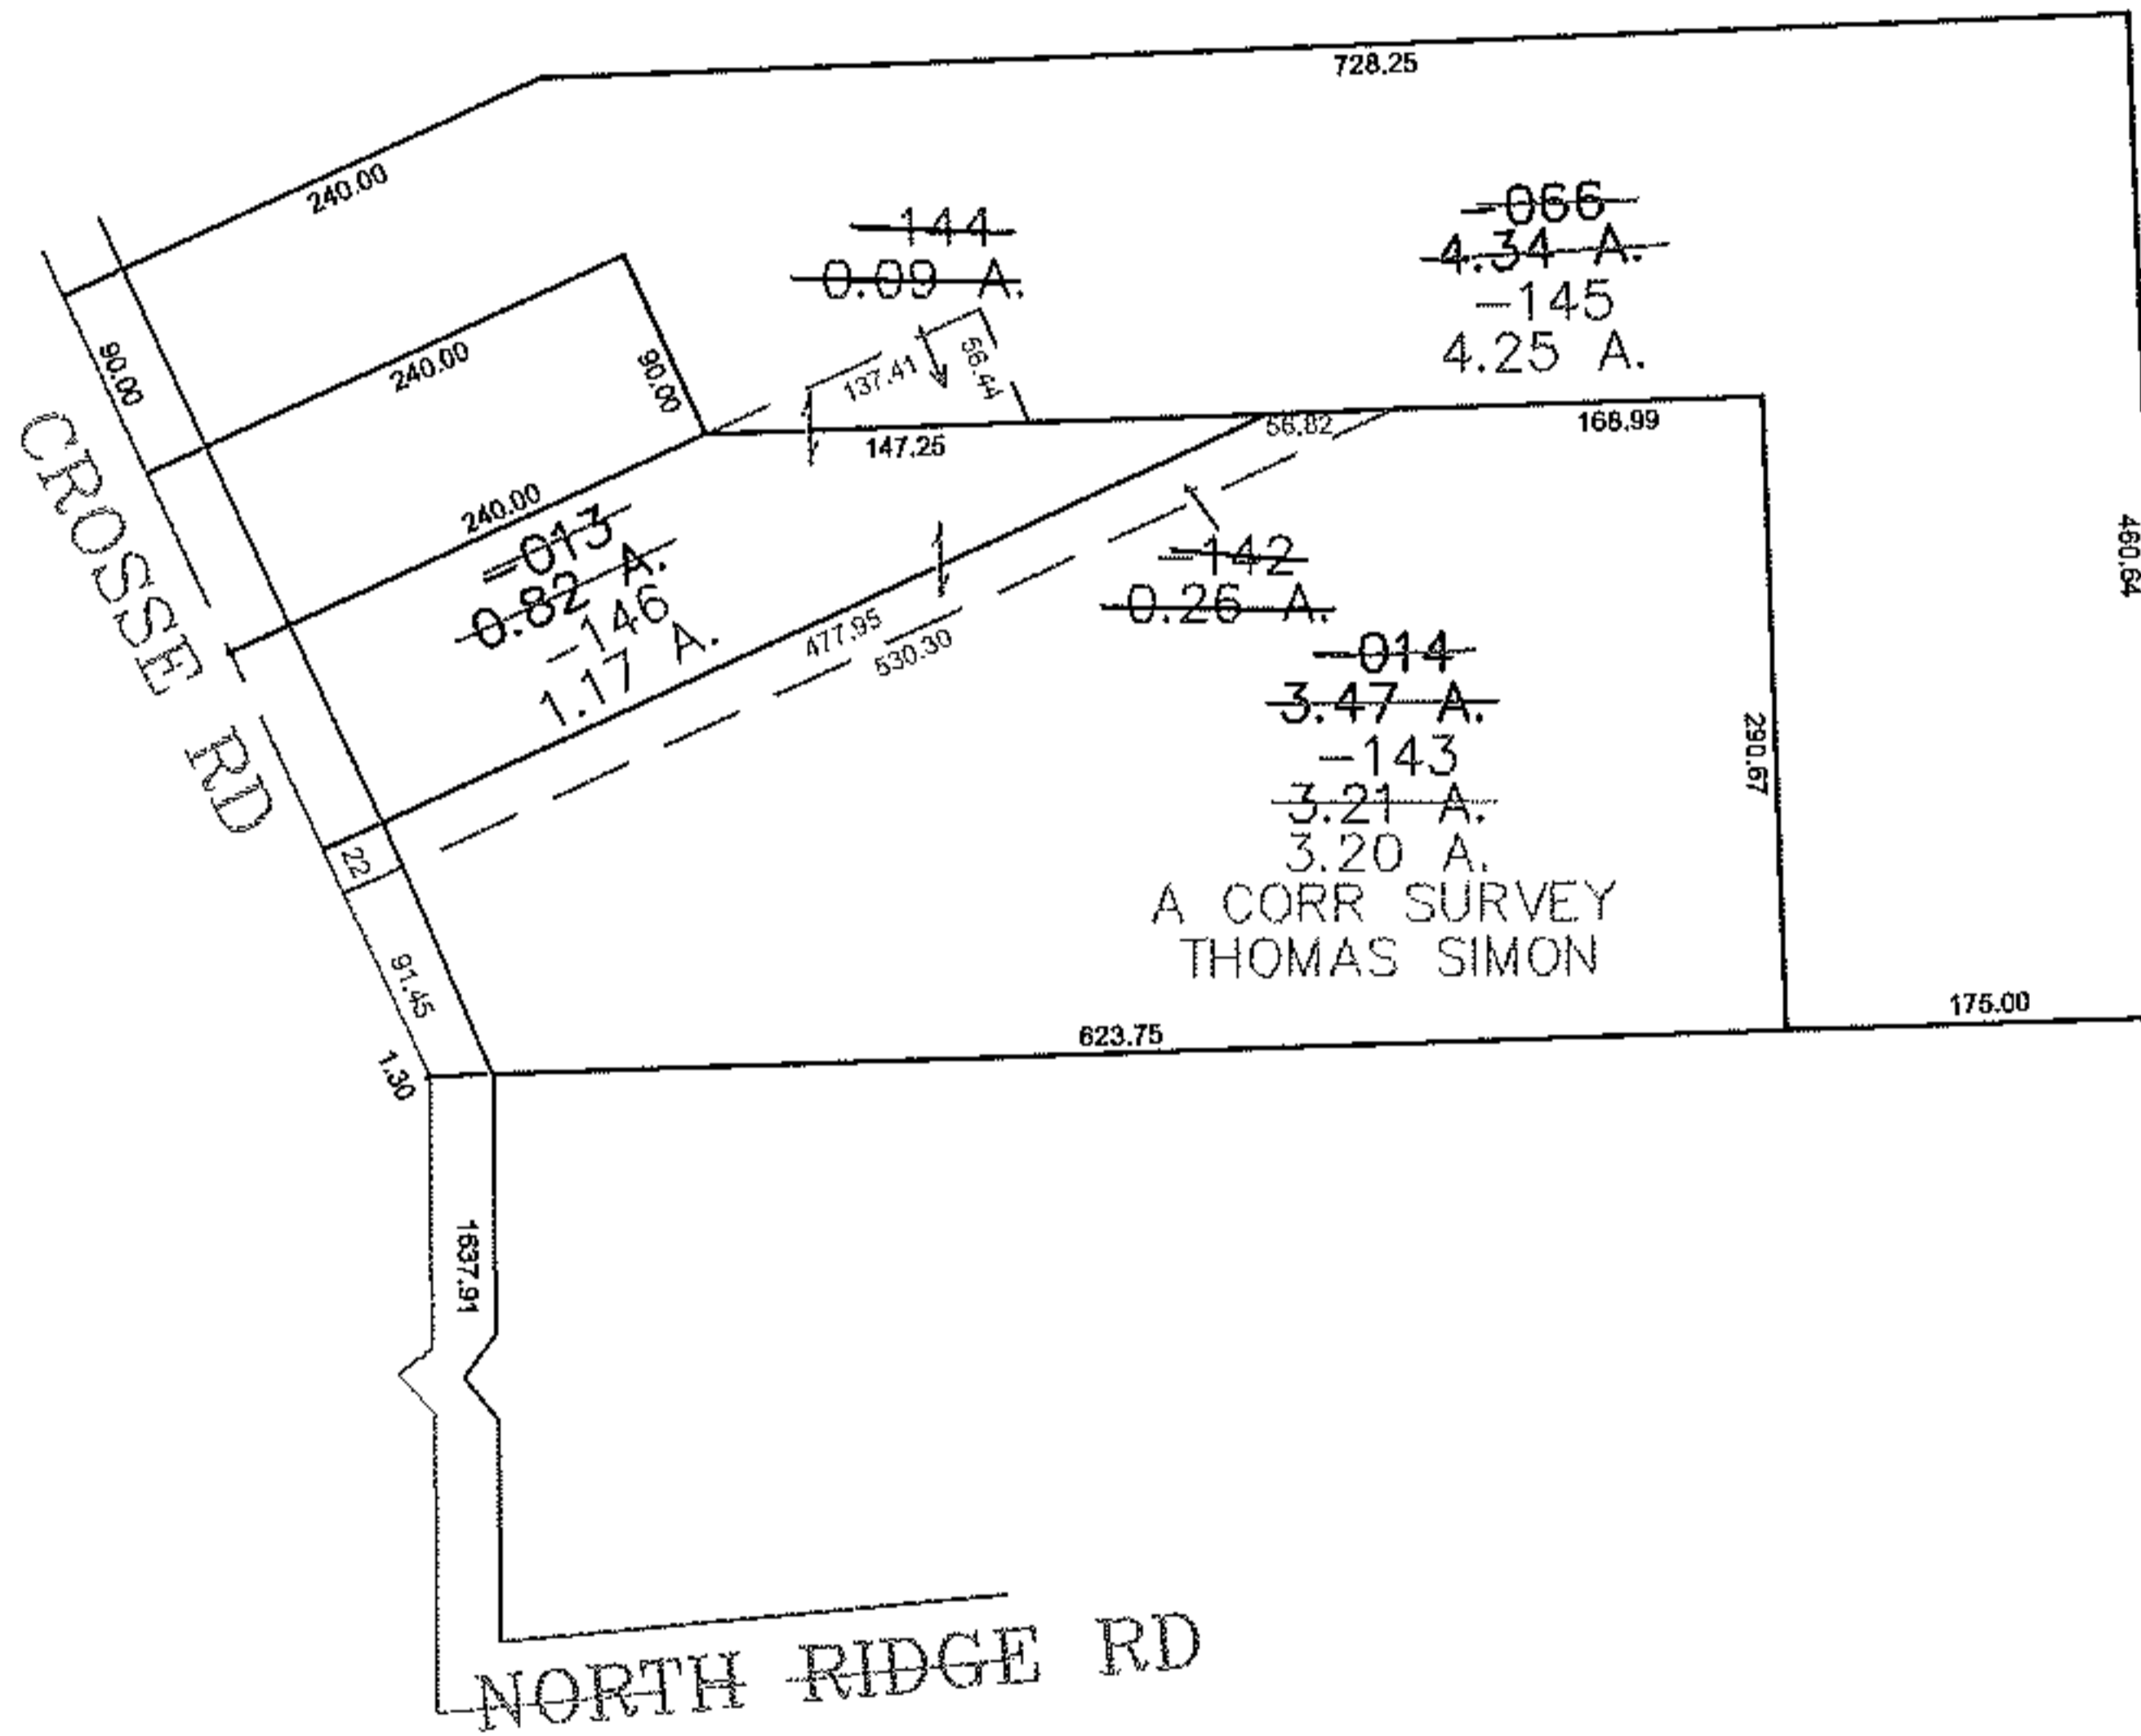


PARENT PARCEL: 05-00-098-000-014, -066, -013

CHILD PARCEL: 05-00-098-000-142 THRU -146

11-02960

STARTING POINT: CENTERLINE OF CROSSE RD & NORTH RIDGE RD

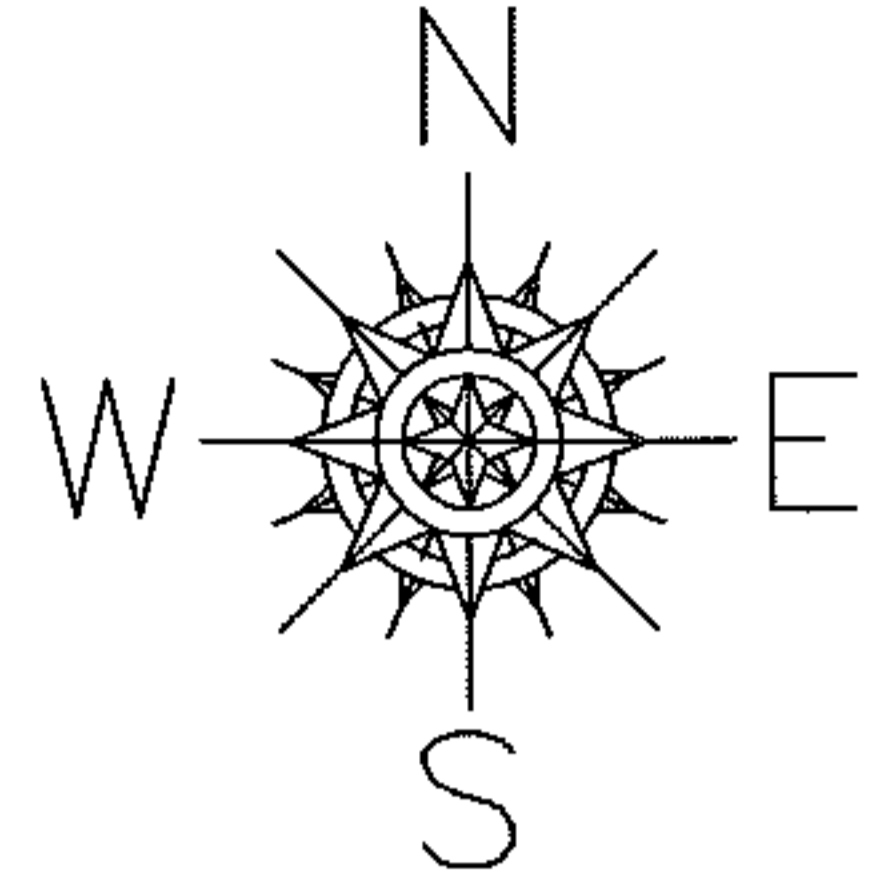

SPLITS/DEEDS PROCESSED
LORAIN COUNTY TAX MAP DEPARTMENT
226 MIDDLE AVE. ELYRIA, OHIO

SURVEYED BY: THOMAS SIMON
CLOSURE: 0.00 : 10.000
MAP PAGE(S): 05-00-098-B
APPROVED BY: JAH DATE: 11/2/2011
SCALE: 1" = 200 PRIOR INSTRUMENT: 2004095996