


RASTER

PARENT PARCEL: 02-01-003-501-034 & -038

CHILD PARCEL: 02-01-003-501-055 THRU -057

11-02962

STARTING POINT: N.W. CORNER OF BLOCK 22 S/L 1 IN SELAH CHAMBERLAIN TRUSTEE ALLOT.
& S.E. CORNER OF BLOCK 31 S/L 8 IN SELAH CHAMBERLAIN TRUSTEE ALLOT.

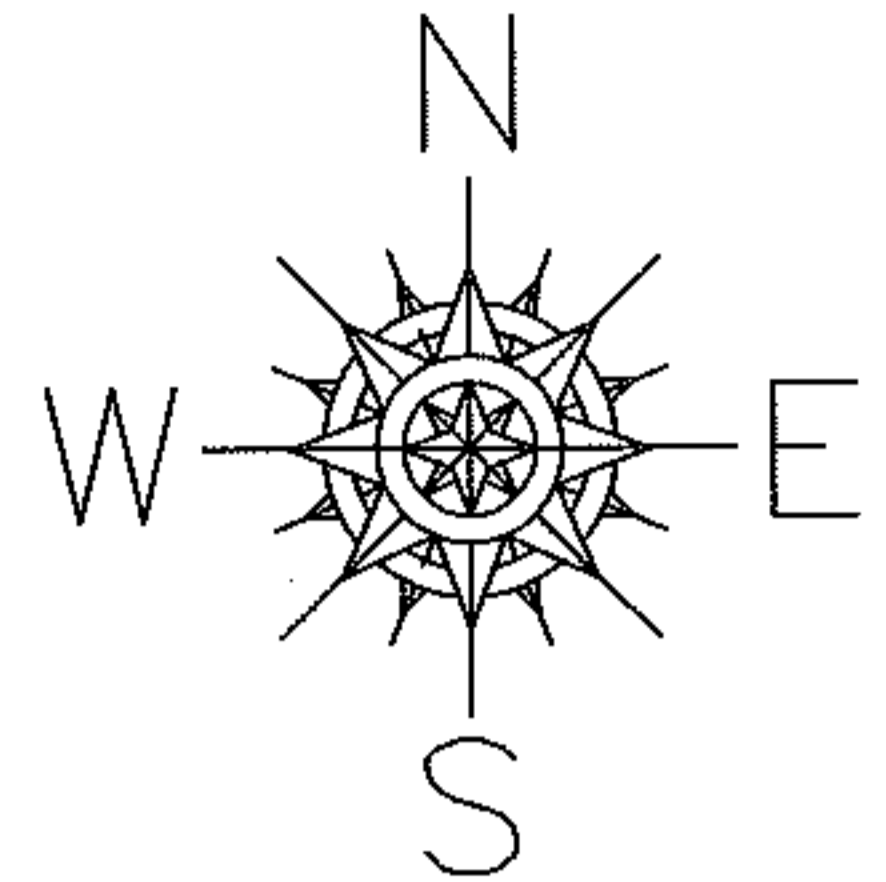

NORFOLK & SOUTHERN R.R.

SPLIT

~~02-01-003-501-034~~

~~1.31 A.~~

02-01-003-501-055

0.09 A.

02-01-003-501-056

~~1.12 A.~~

1.12 A.

AC. CORR. PER SURV.
JAMES P. YURKSCHATT

COMBINATION

~~02-01-003-501-038~~

~~0.30 A.~~

&

~~02-01-003-501-055~~

~~0.09 A.~~

02-01-003-501-057

~~0.39 A.~~


0.41 A.

AC. CORR. PER SURV.
JAMES P. YURKSCHATT

BROADWAY AVE. 80'

PRIOR INST.: DV 77/95

PRIOR INST.: DV 66/194

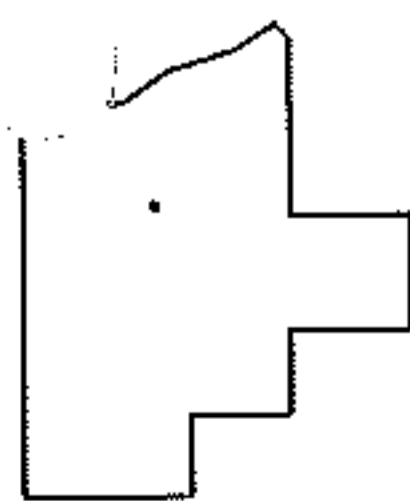

SPLITS/DEEDS PROCESSED

LORAIN COUNTY TAX MAP DEPARTMENT
226 MIDDLE AVE. ELYRIA, OHIO

SURVEYED BY: JAMES P. YURKSCHATT

CLOSURE: 0.05 : 10,000

MAP PAGE(S): 2-01-003-C

APPROVED BY: TJS DATE: 11/3/11

SCALE: 1"= 300