

PARENT PARCEL: 05-00-008-000-011, 05-00-008-500-002



CHILD PARCEL: 05-00-008-000-016

PARENT PARCEL: 05-00-093-000-012, -016, -018, -021

CHILD PARCEL: 05-00-093-000-022

STARTING POINT: STONE FD. S.E. CORNER OF BROWNHelm TWP.

11-02964

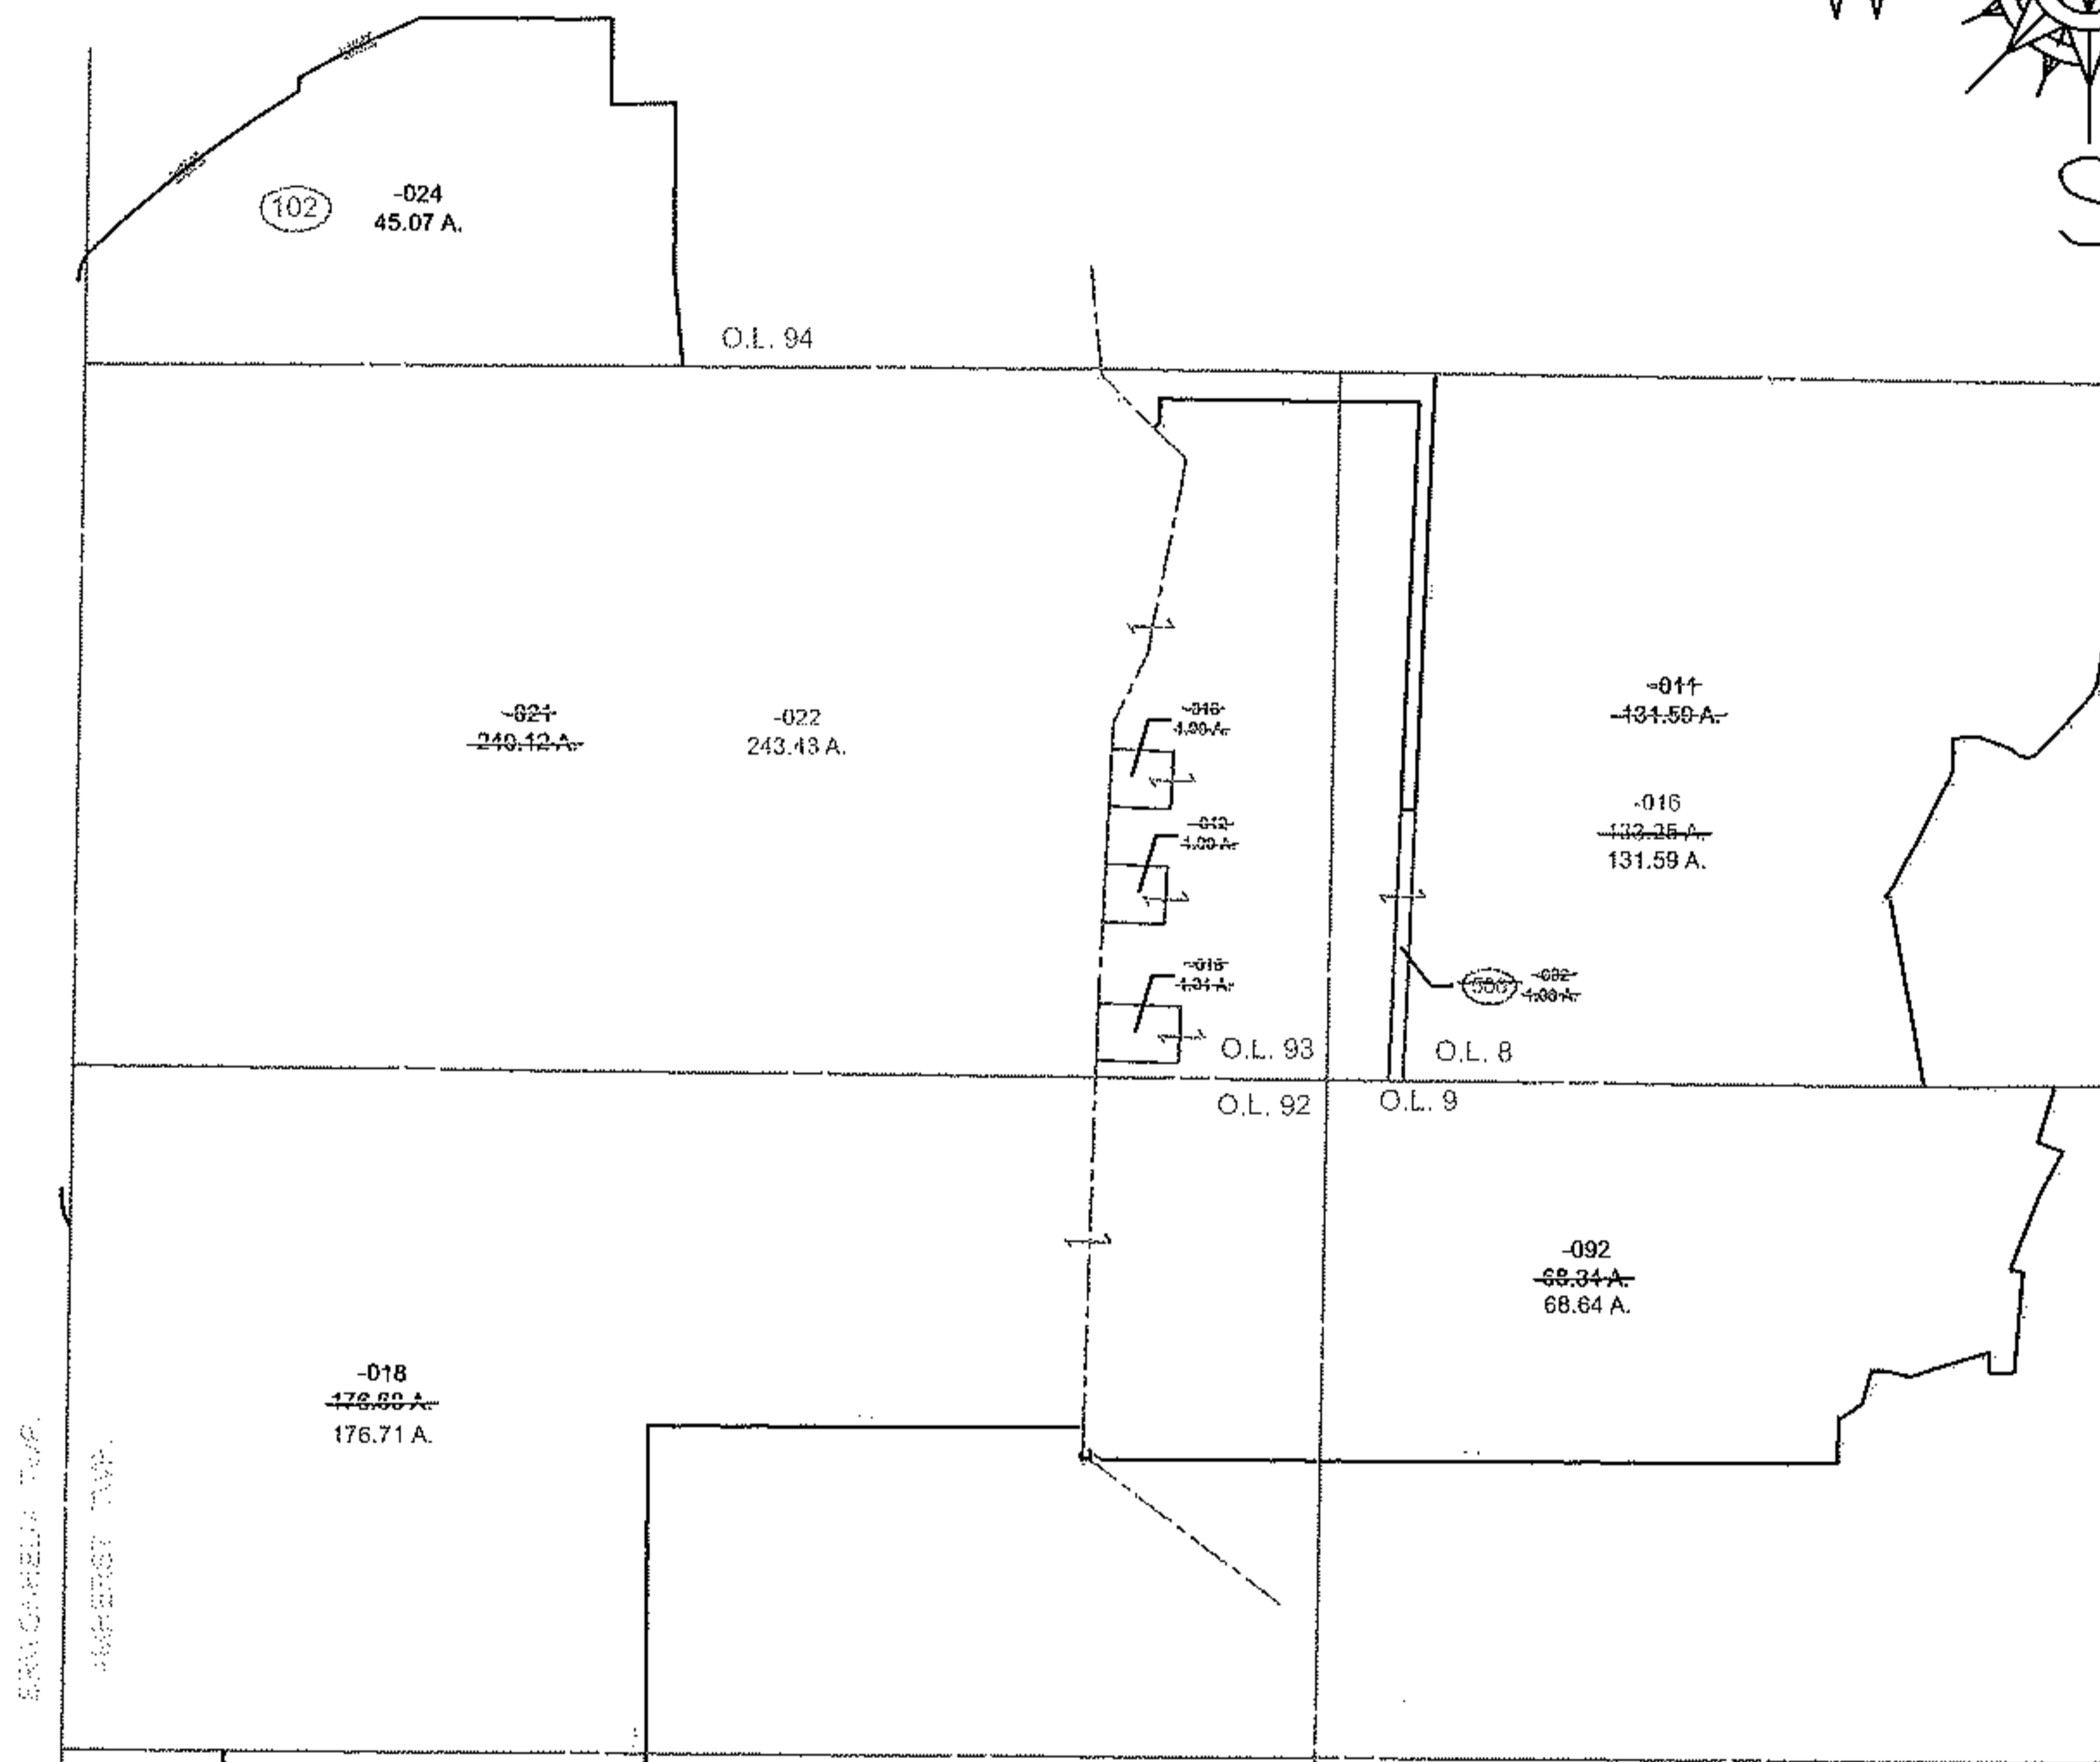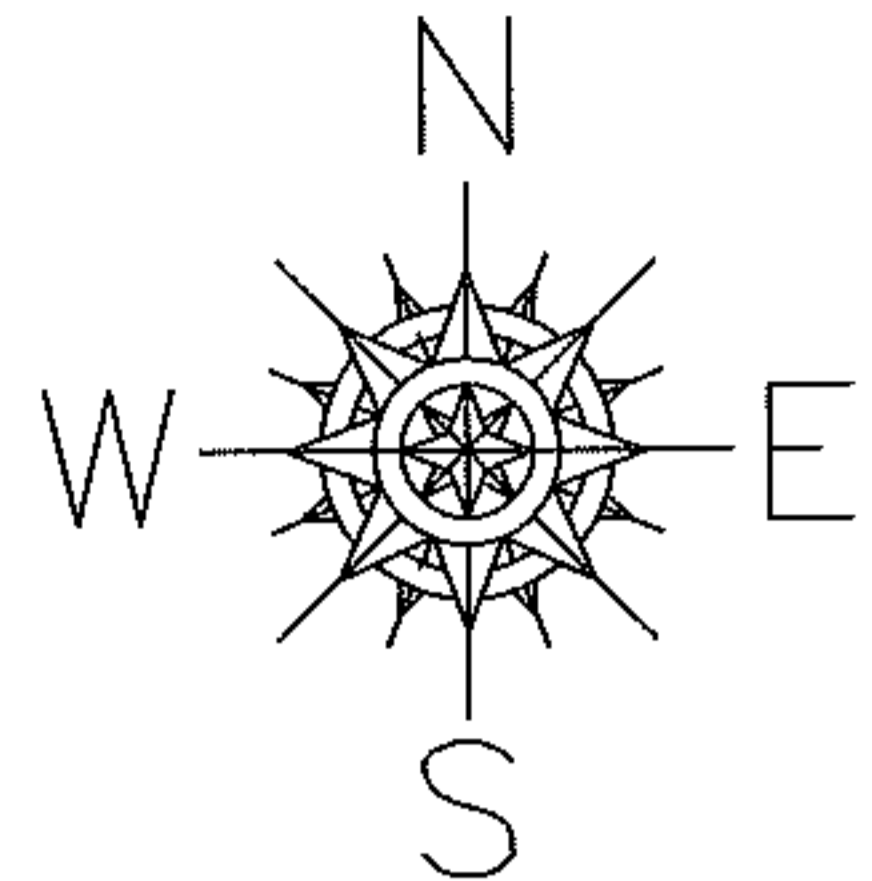

BRUNNEN TWP.
BROWNHELM TWP.

ACREAGE CORR.

05-00-092-000-018
~~176.68 A.~~
176.71 A.

ACREAGE CORR.

05-00-009-000-092
~~68.34 A.~~
68.64 A.

ACREAGE CORR.

05-00-091-101-014
~~21.32 A.~~
21.42 A.

COMBINATION

~~05-00-093-000-012~~
~~1.00 A.~~
~~05-00-093-000-016~~
~~1.31 A.~~
~~05-00-093-000-018~~
~~1.00 A.~~
~~05-00-093-000-021~~
~~240.12 A.~~
05-00-093-000-022
243.43 A.

COMBINATION

~~05-00-008-000-011~~
~~131.59 A.~~
~~05-00-008-500-002~~
~~1.00 A.~~
05-00-008-000-016
133.25 A.
CORR. PER SURV.
M. SHELESTOVICH

STONE FD.
S.E. CORNER
BROWNHelm TWP.

SPLITS/DEEDS PROCESSED

LORAIN COUNTY TAX MAP DEPARTMENT
226 MIDDLE AVE. ELYRIA, OHIO

SURVEYED BY: MICHAEL R. SHELESTOVICH

CLOSURE: 0.01 : 10,000

MAP PAGE(S): 5-E

APPROVED BY: TJS DATE: 11/11/11

SCALE: 1" = 1200 PRIOR INSTRUMENT: 20110381202