


RASTER

PARENT PARCEL: 04-00-006-105-060

CHILD PARCEL: 04-00-006-105-061, -062

STARTING POINT: CENTERLINE OF WALKER RD & MILLER RD

11-02965

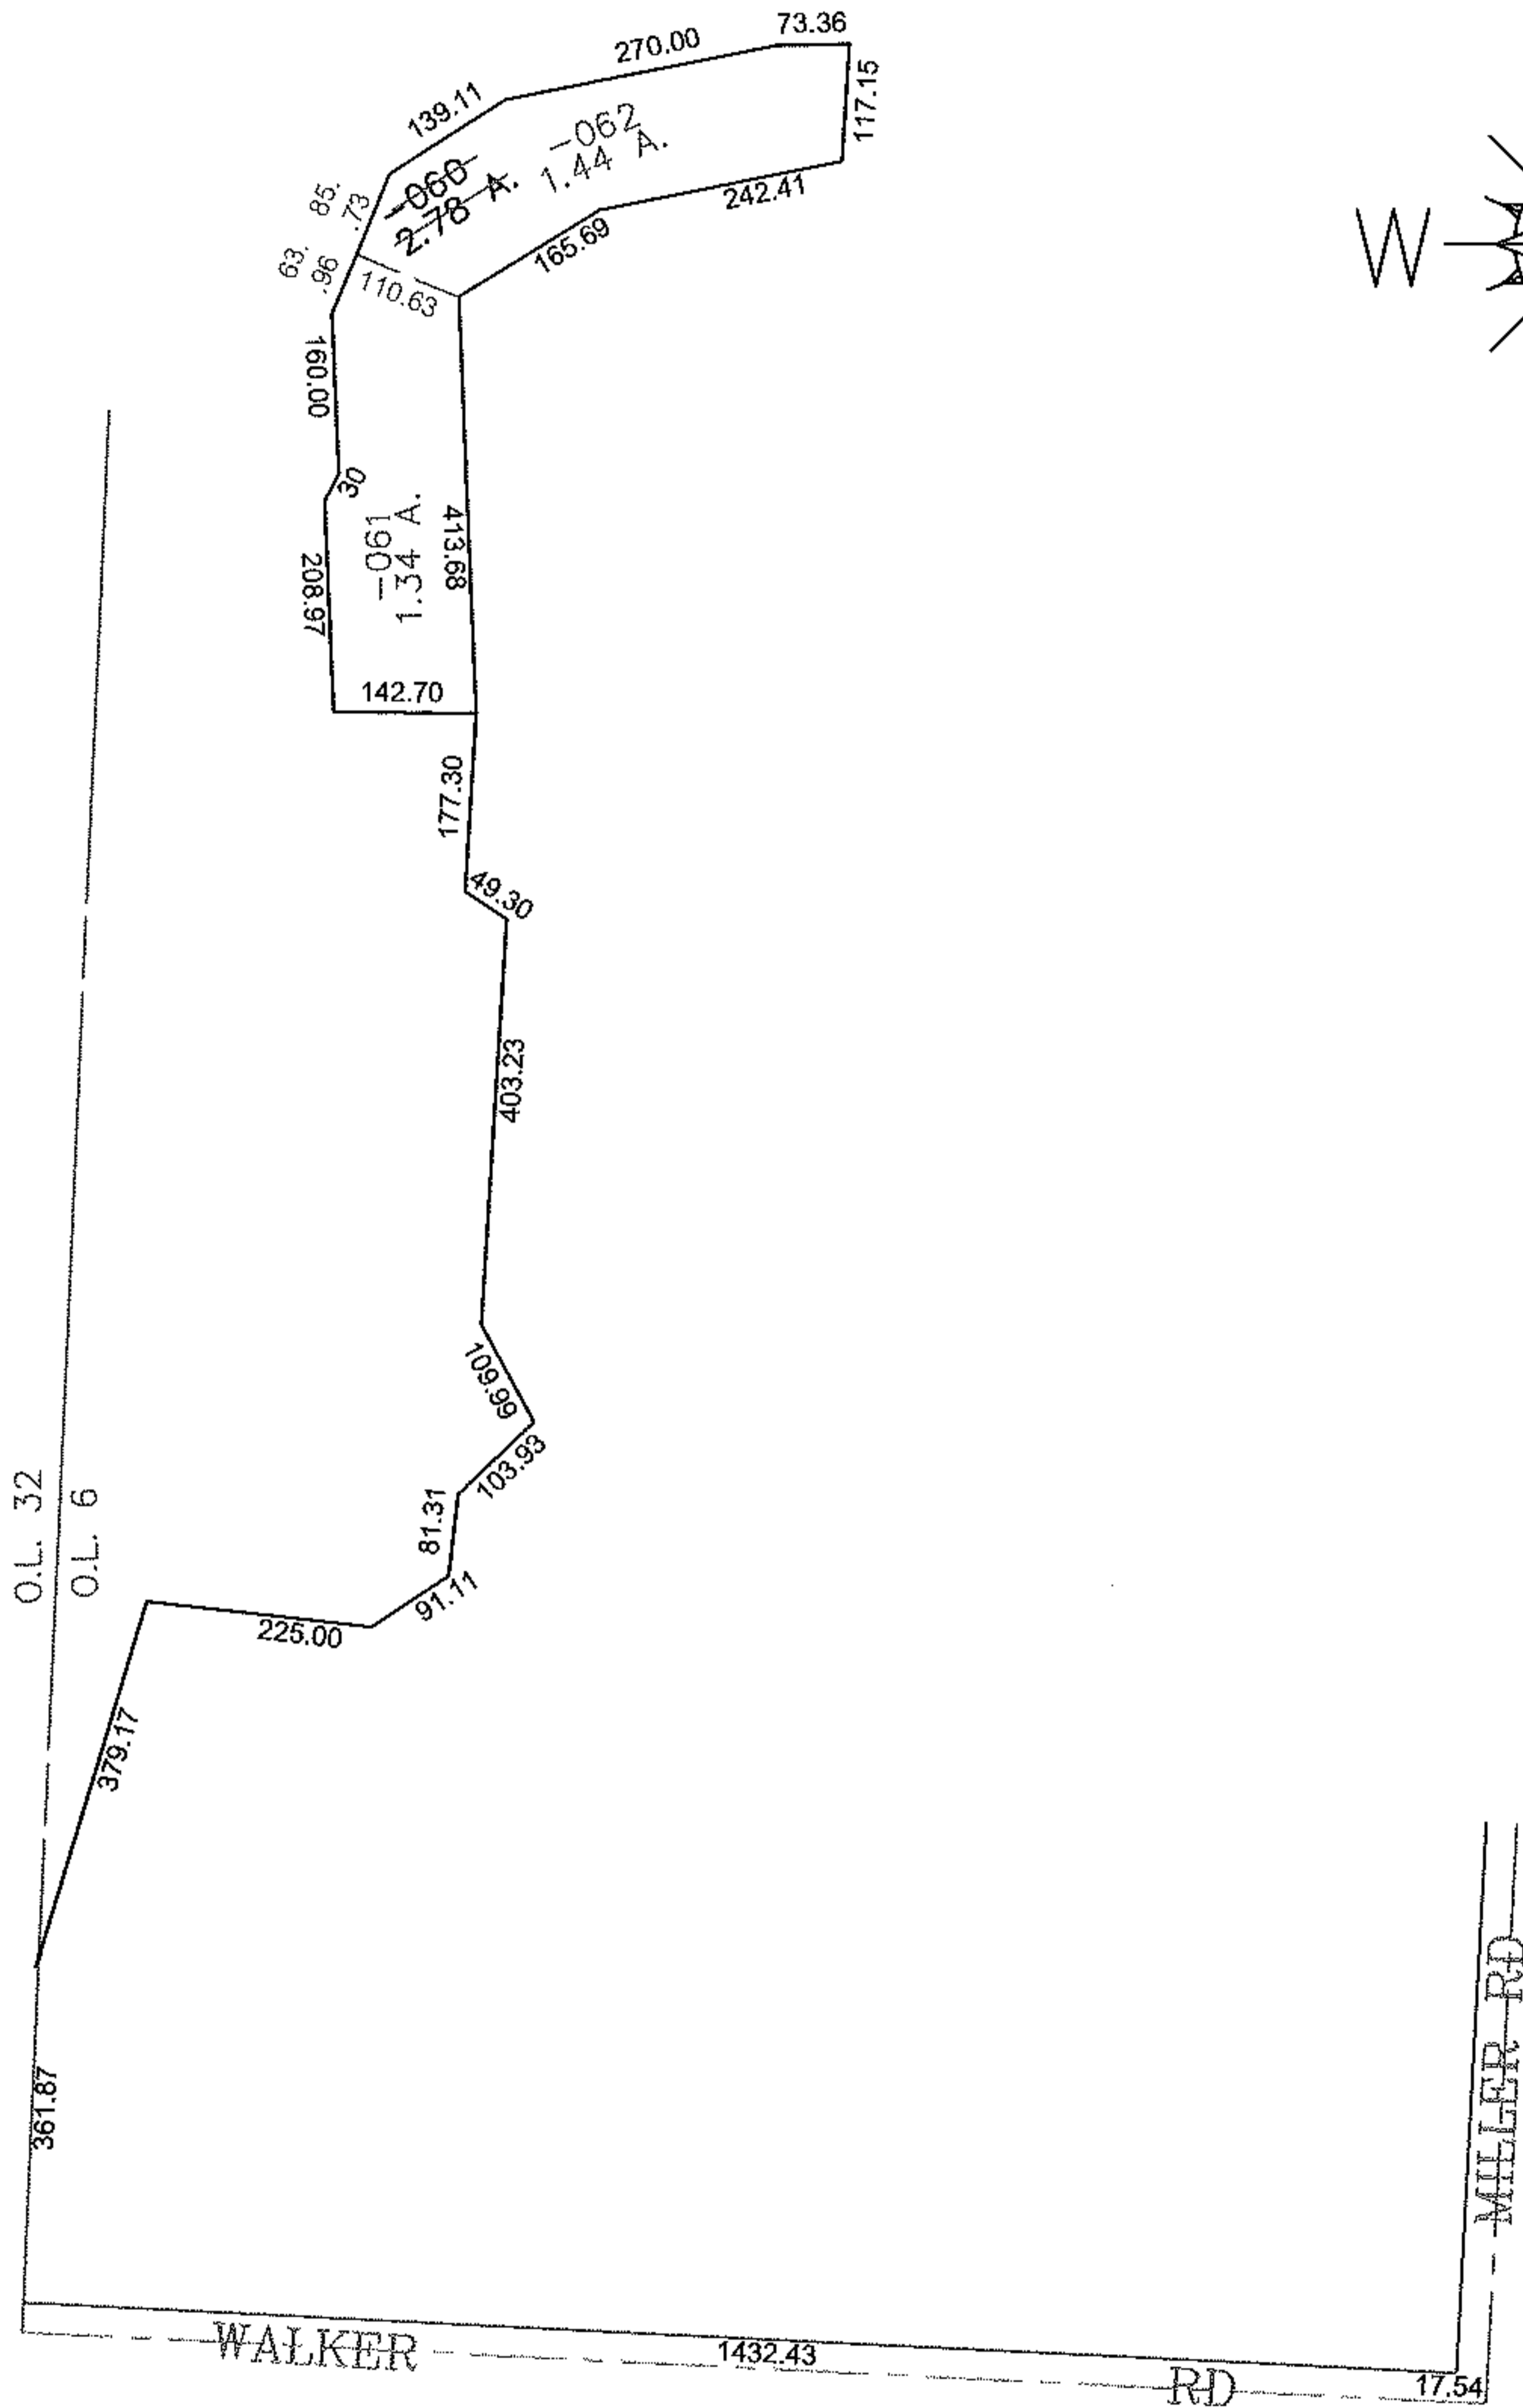

SPLITS/DEEDS PROCESSED

LORAIN COUNTY TAX MAP DEPARTMENT
226 MIDDLE AVE. ELYRIA, OHIO

SURVEYED BY: JAMES T SAYLER

CLOSURE: 0.00 : 10.000

MAP PAGE(S): 04-00-006-E

APPROVED BY: JAH DATE: 11-10-2011

SCALE: 1" = 300 PRIOR INSTRUMENT: 20110388544