

PARENT PARCEL: 12-00-041-000-023

CHILD PARCEL: 12-00-040-630-005 & 12-00-041-630-005

STARTING POINT: XXXXXX

14-02966-A

ADD TO DUPLICATE

12-00-040-630-005

10 X 10


API# 34093212530

ADD TO DUPLICATE


12-00-041-630-005

10 X 10

API# 34093212220

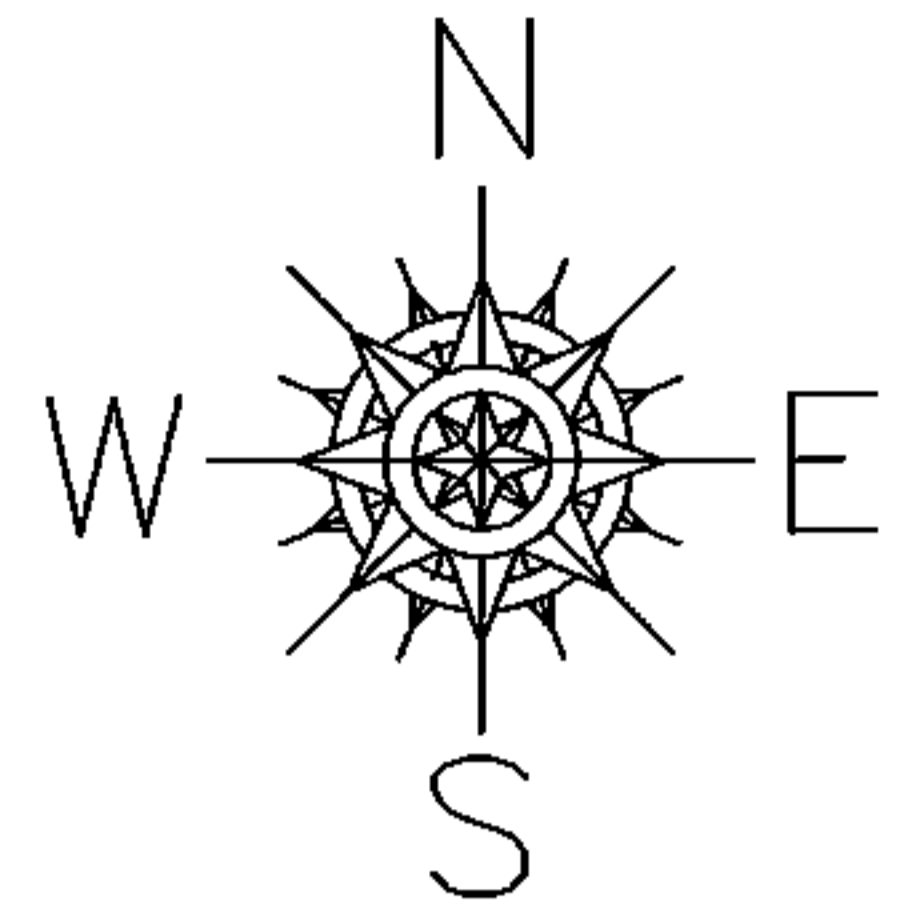

*Correct API # in site address  
- to many zero's at end of #.*

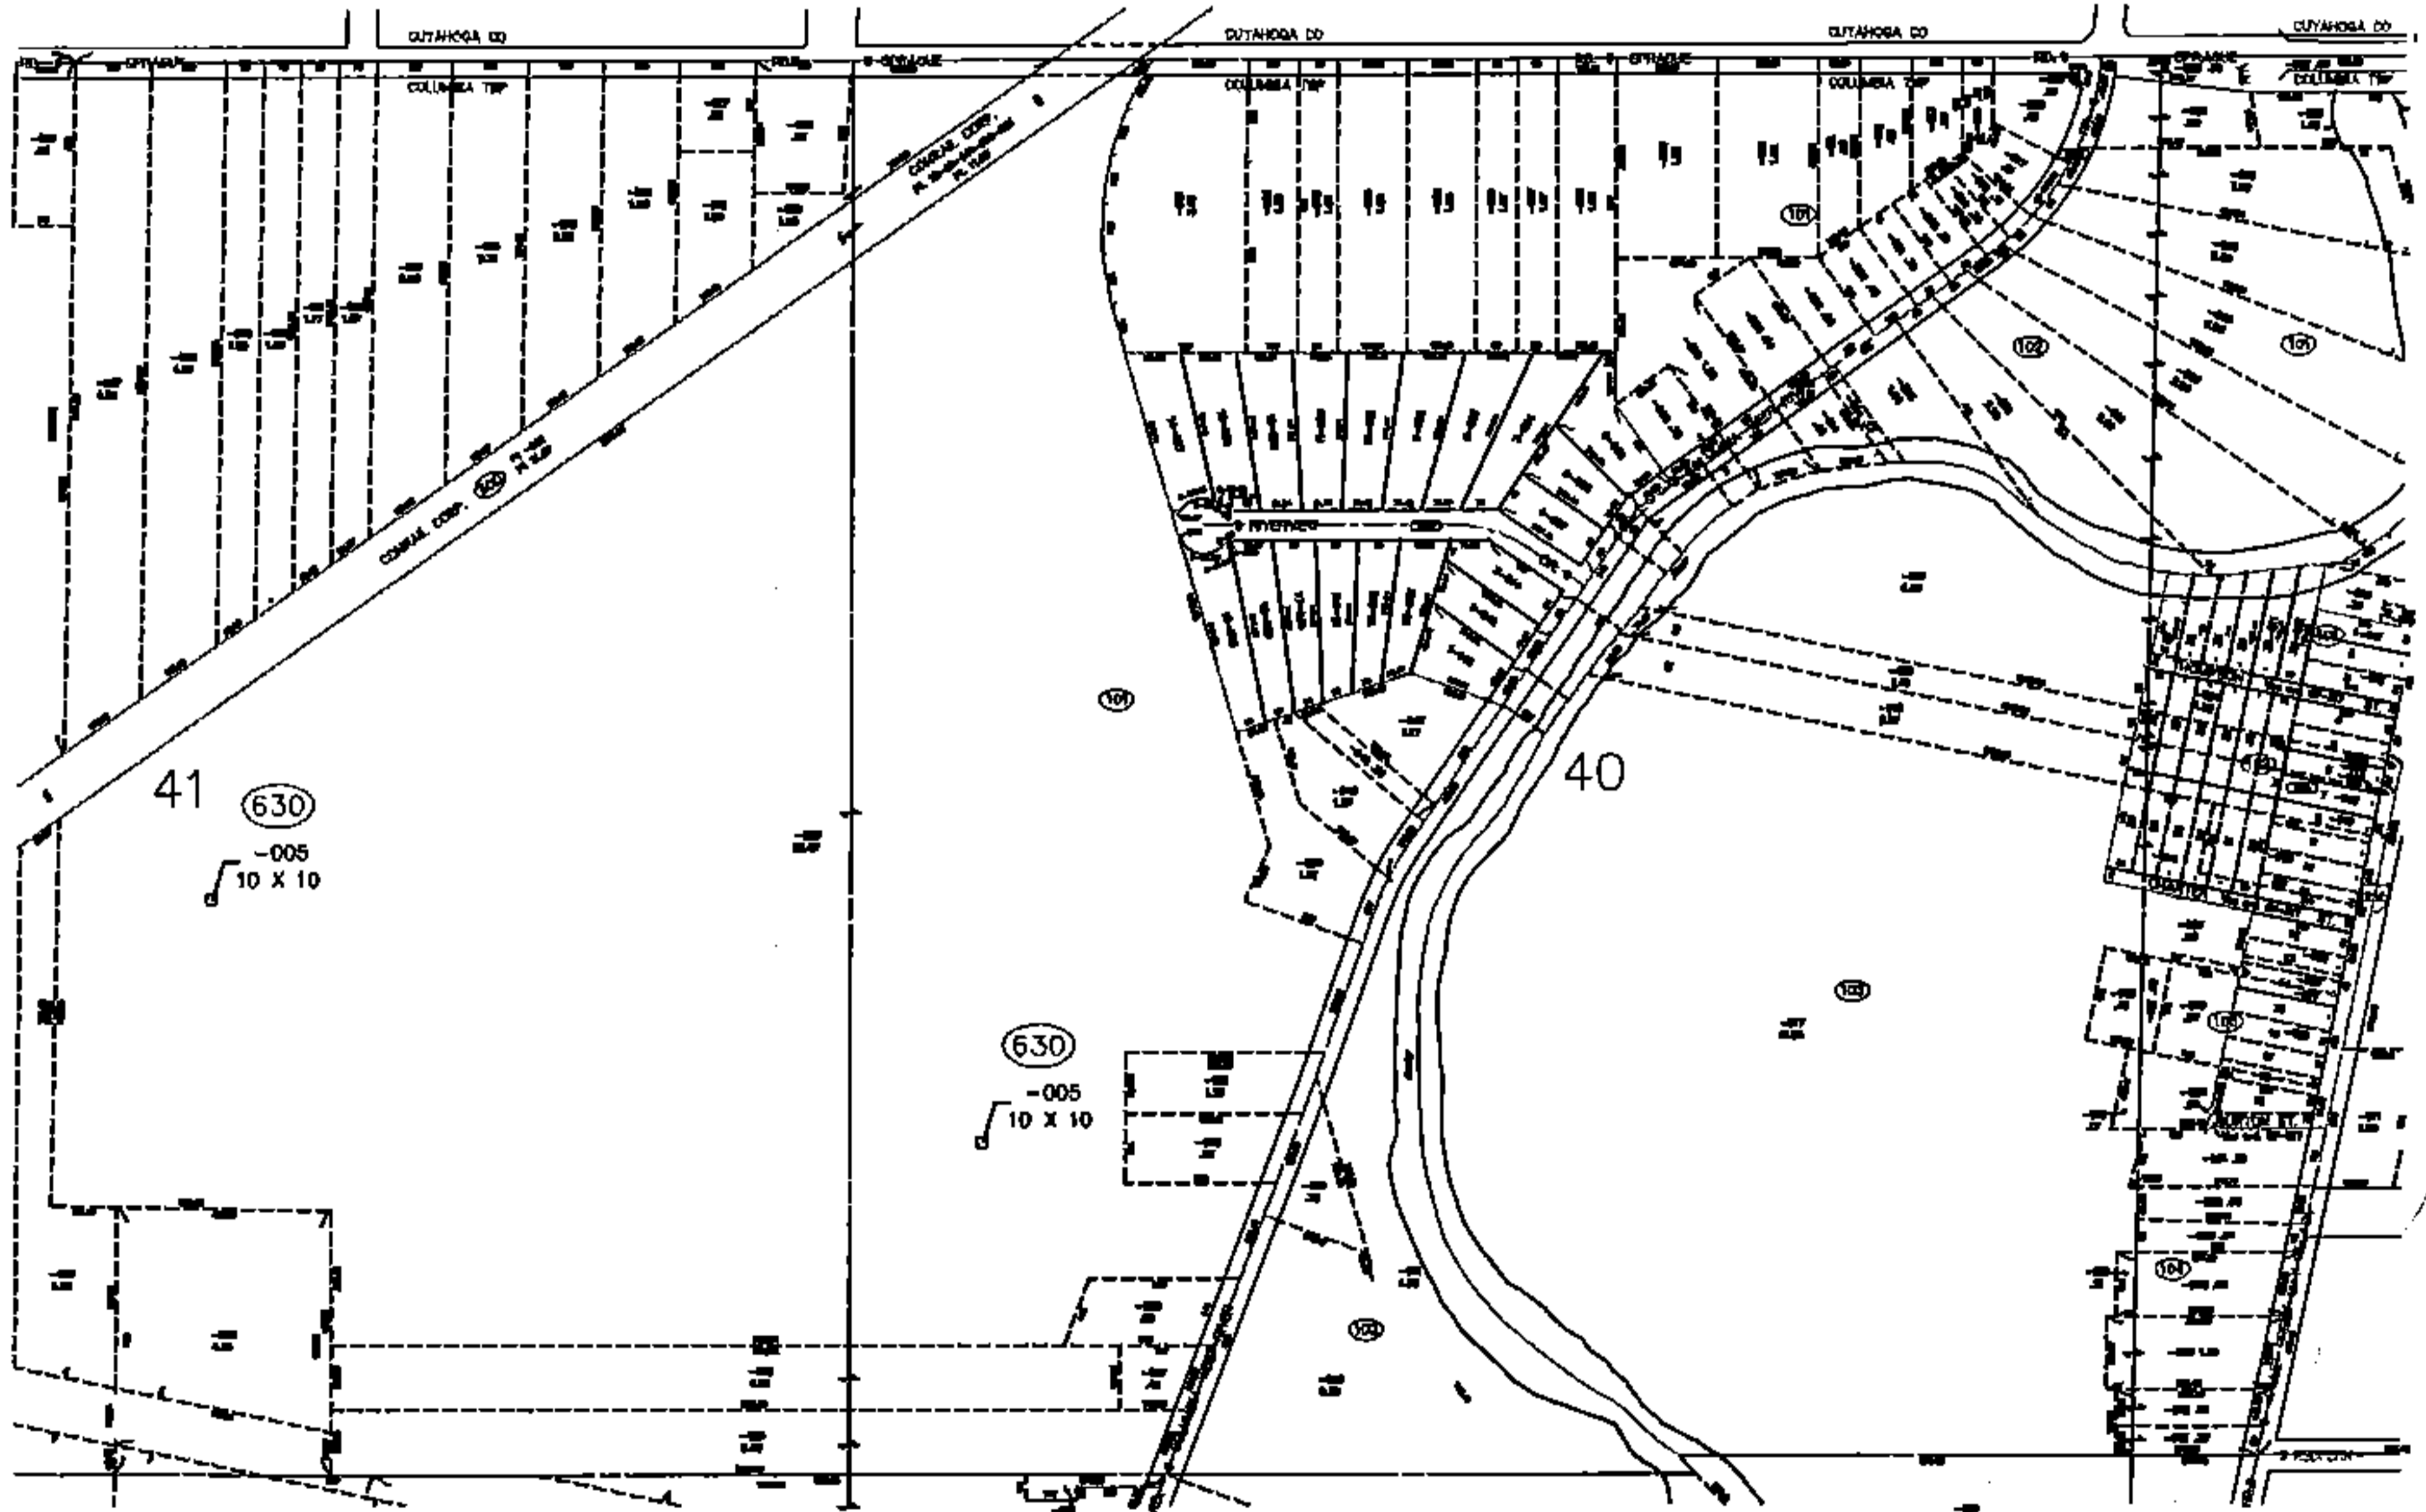

*21  
4/8/16*

SPLITS/DEEDS PROCESSED

LORAIN COUNTY TAX MAP DEPARTMENT  
226 MIDDLE AVE. ELYRIA, OHIO

SURVEYED BY: NA  
CLOSURE: NA  
MAP PAGE(S): 12-00-040 & -041  
APPROVED BY: TJS DATE: 6/16/14  
SCALE: 1" = 700' PRIOR INSTRUMENT: NA