
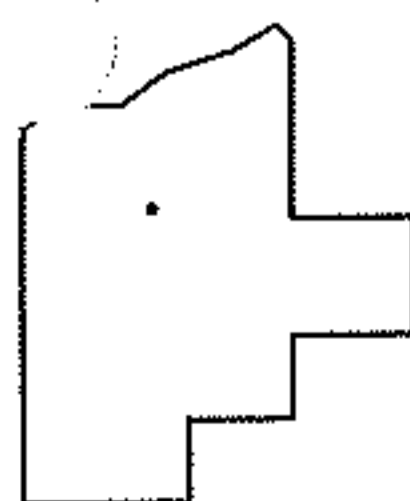
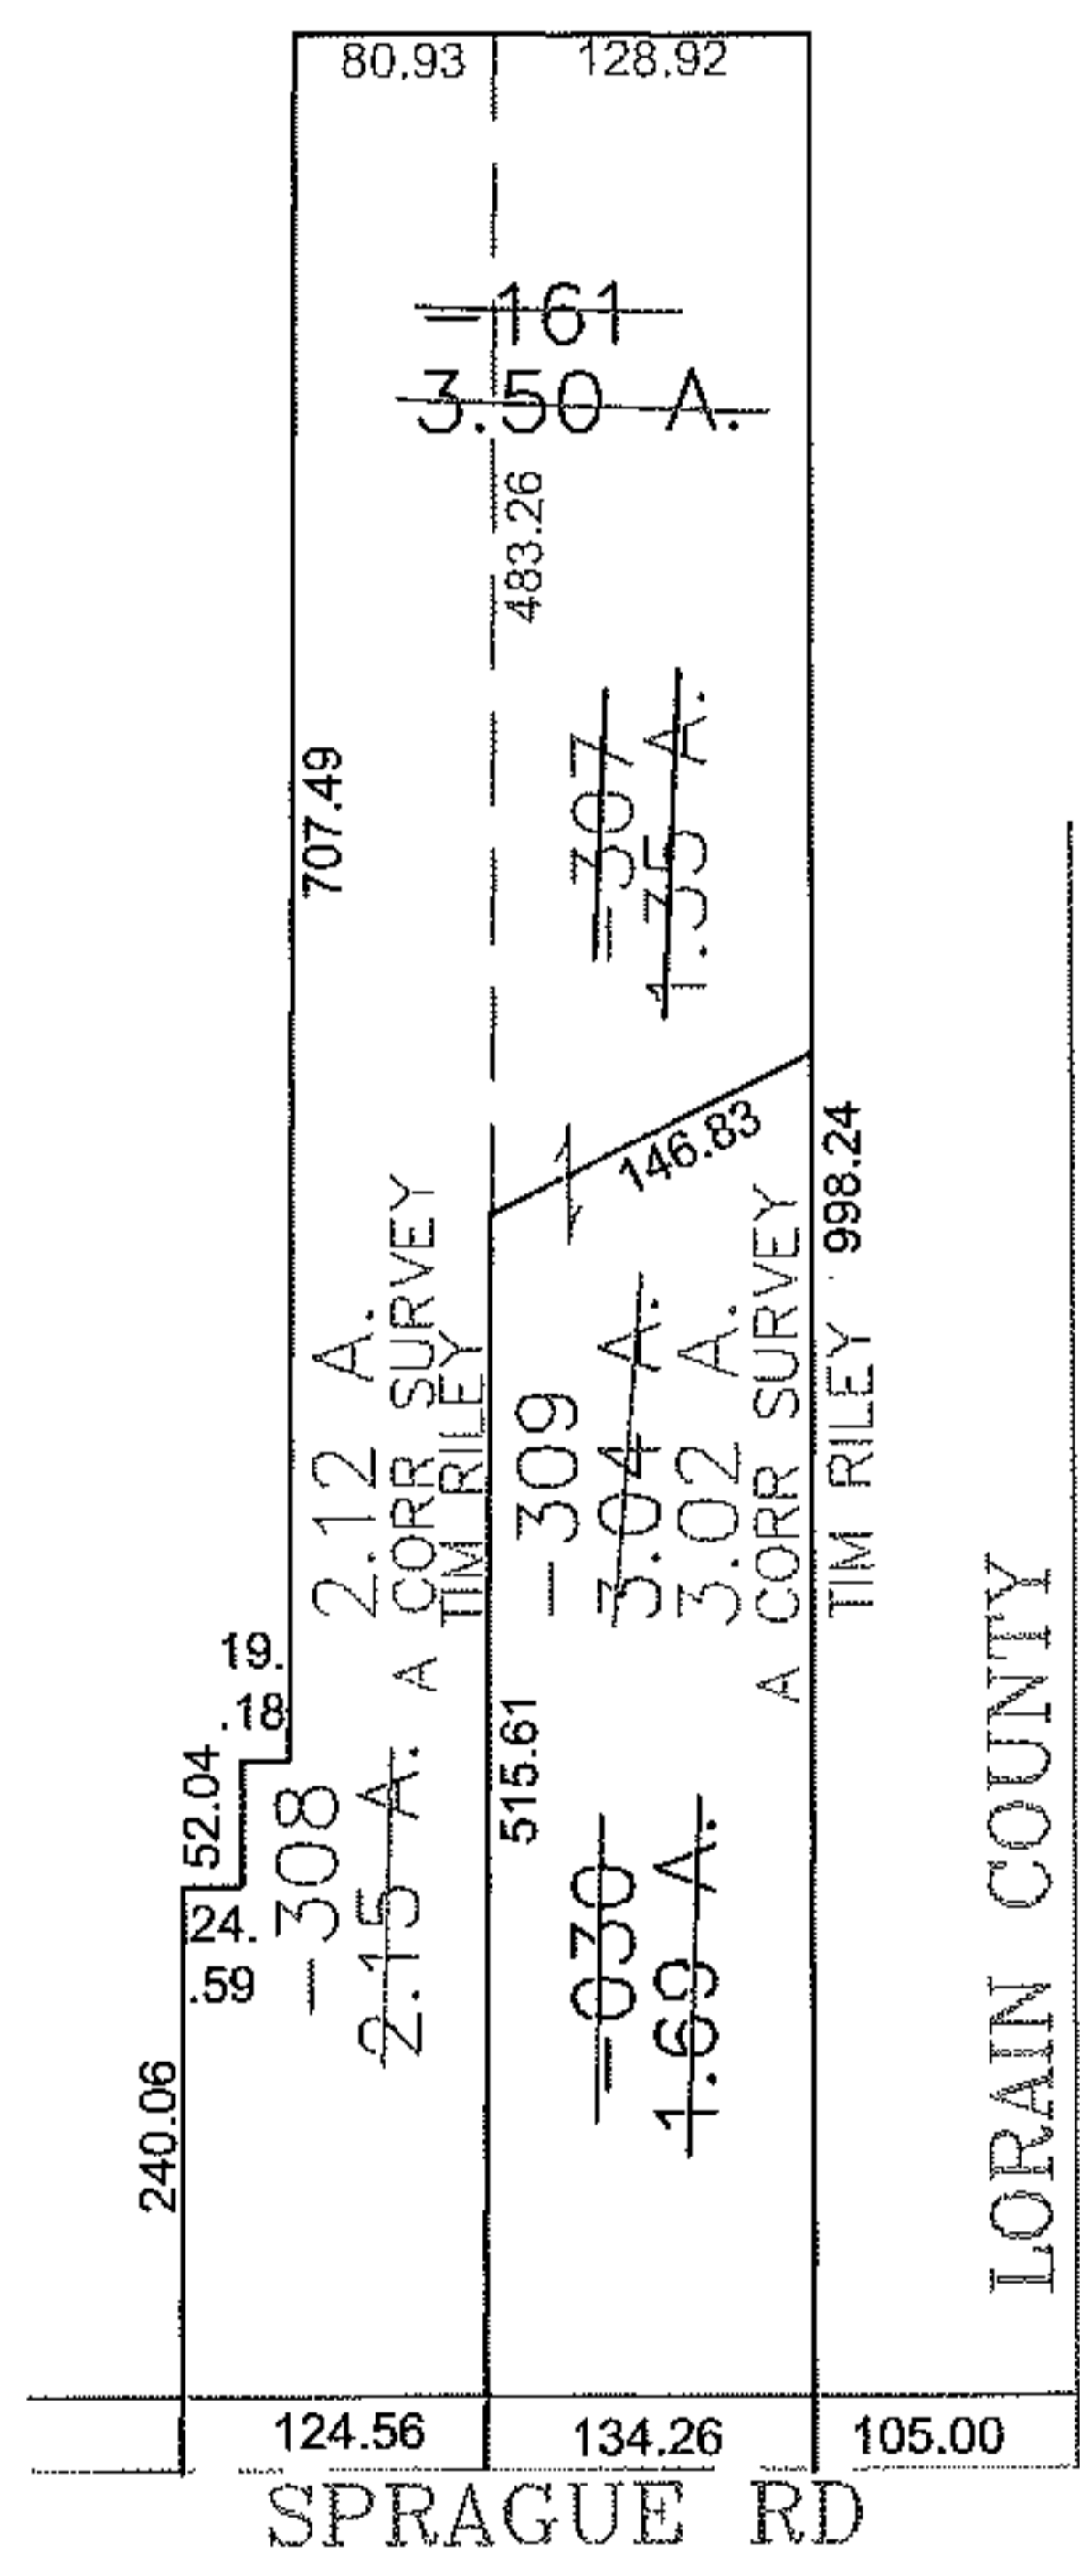


RAS VER

PARENT PARCEL: 07-00-001-000-161, -030
CHILD PARCEL: 07-00-001-000-307 THRU -309
STARTING POINT: CENTERLINE OF SPRAGUE RD & O.L. 1

11-02967

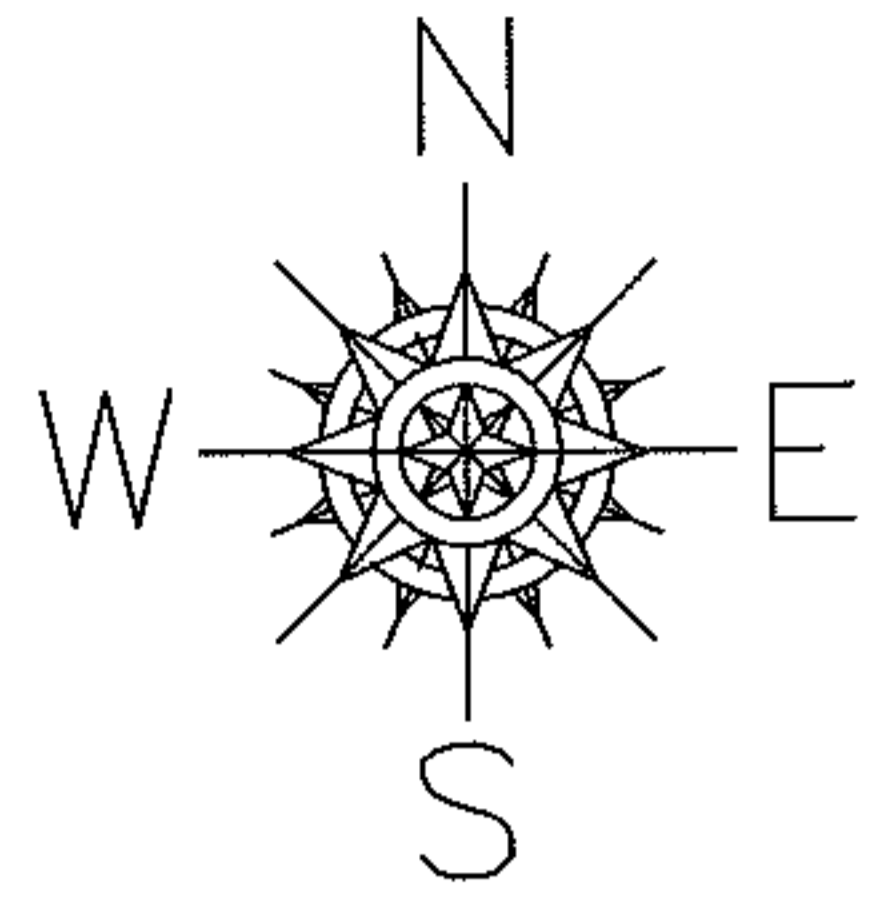

SPLITS/DEEDS PROCESSED
LORAIN COUNTY TAX MAP DEPARTMENT
226 MIDDLE AVE. ELYRIA, OHIO

SURVEYED BY: TIM RILEY
CLOSURE: 0.00 : 10,000
MAP PAGE(S): 07-00-001-D
APPROVED BY: JAH DATE: 11-16-2011
SCALE: 1" = 200 PRIOR INSTRUMENT: 20080244671