
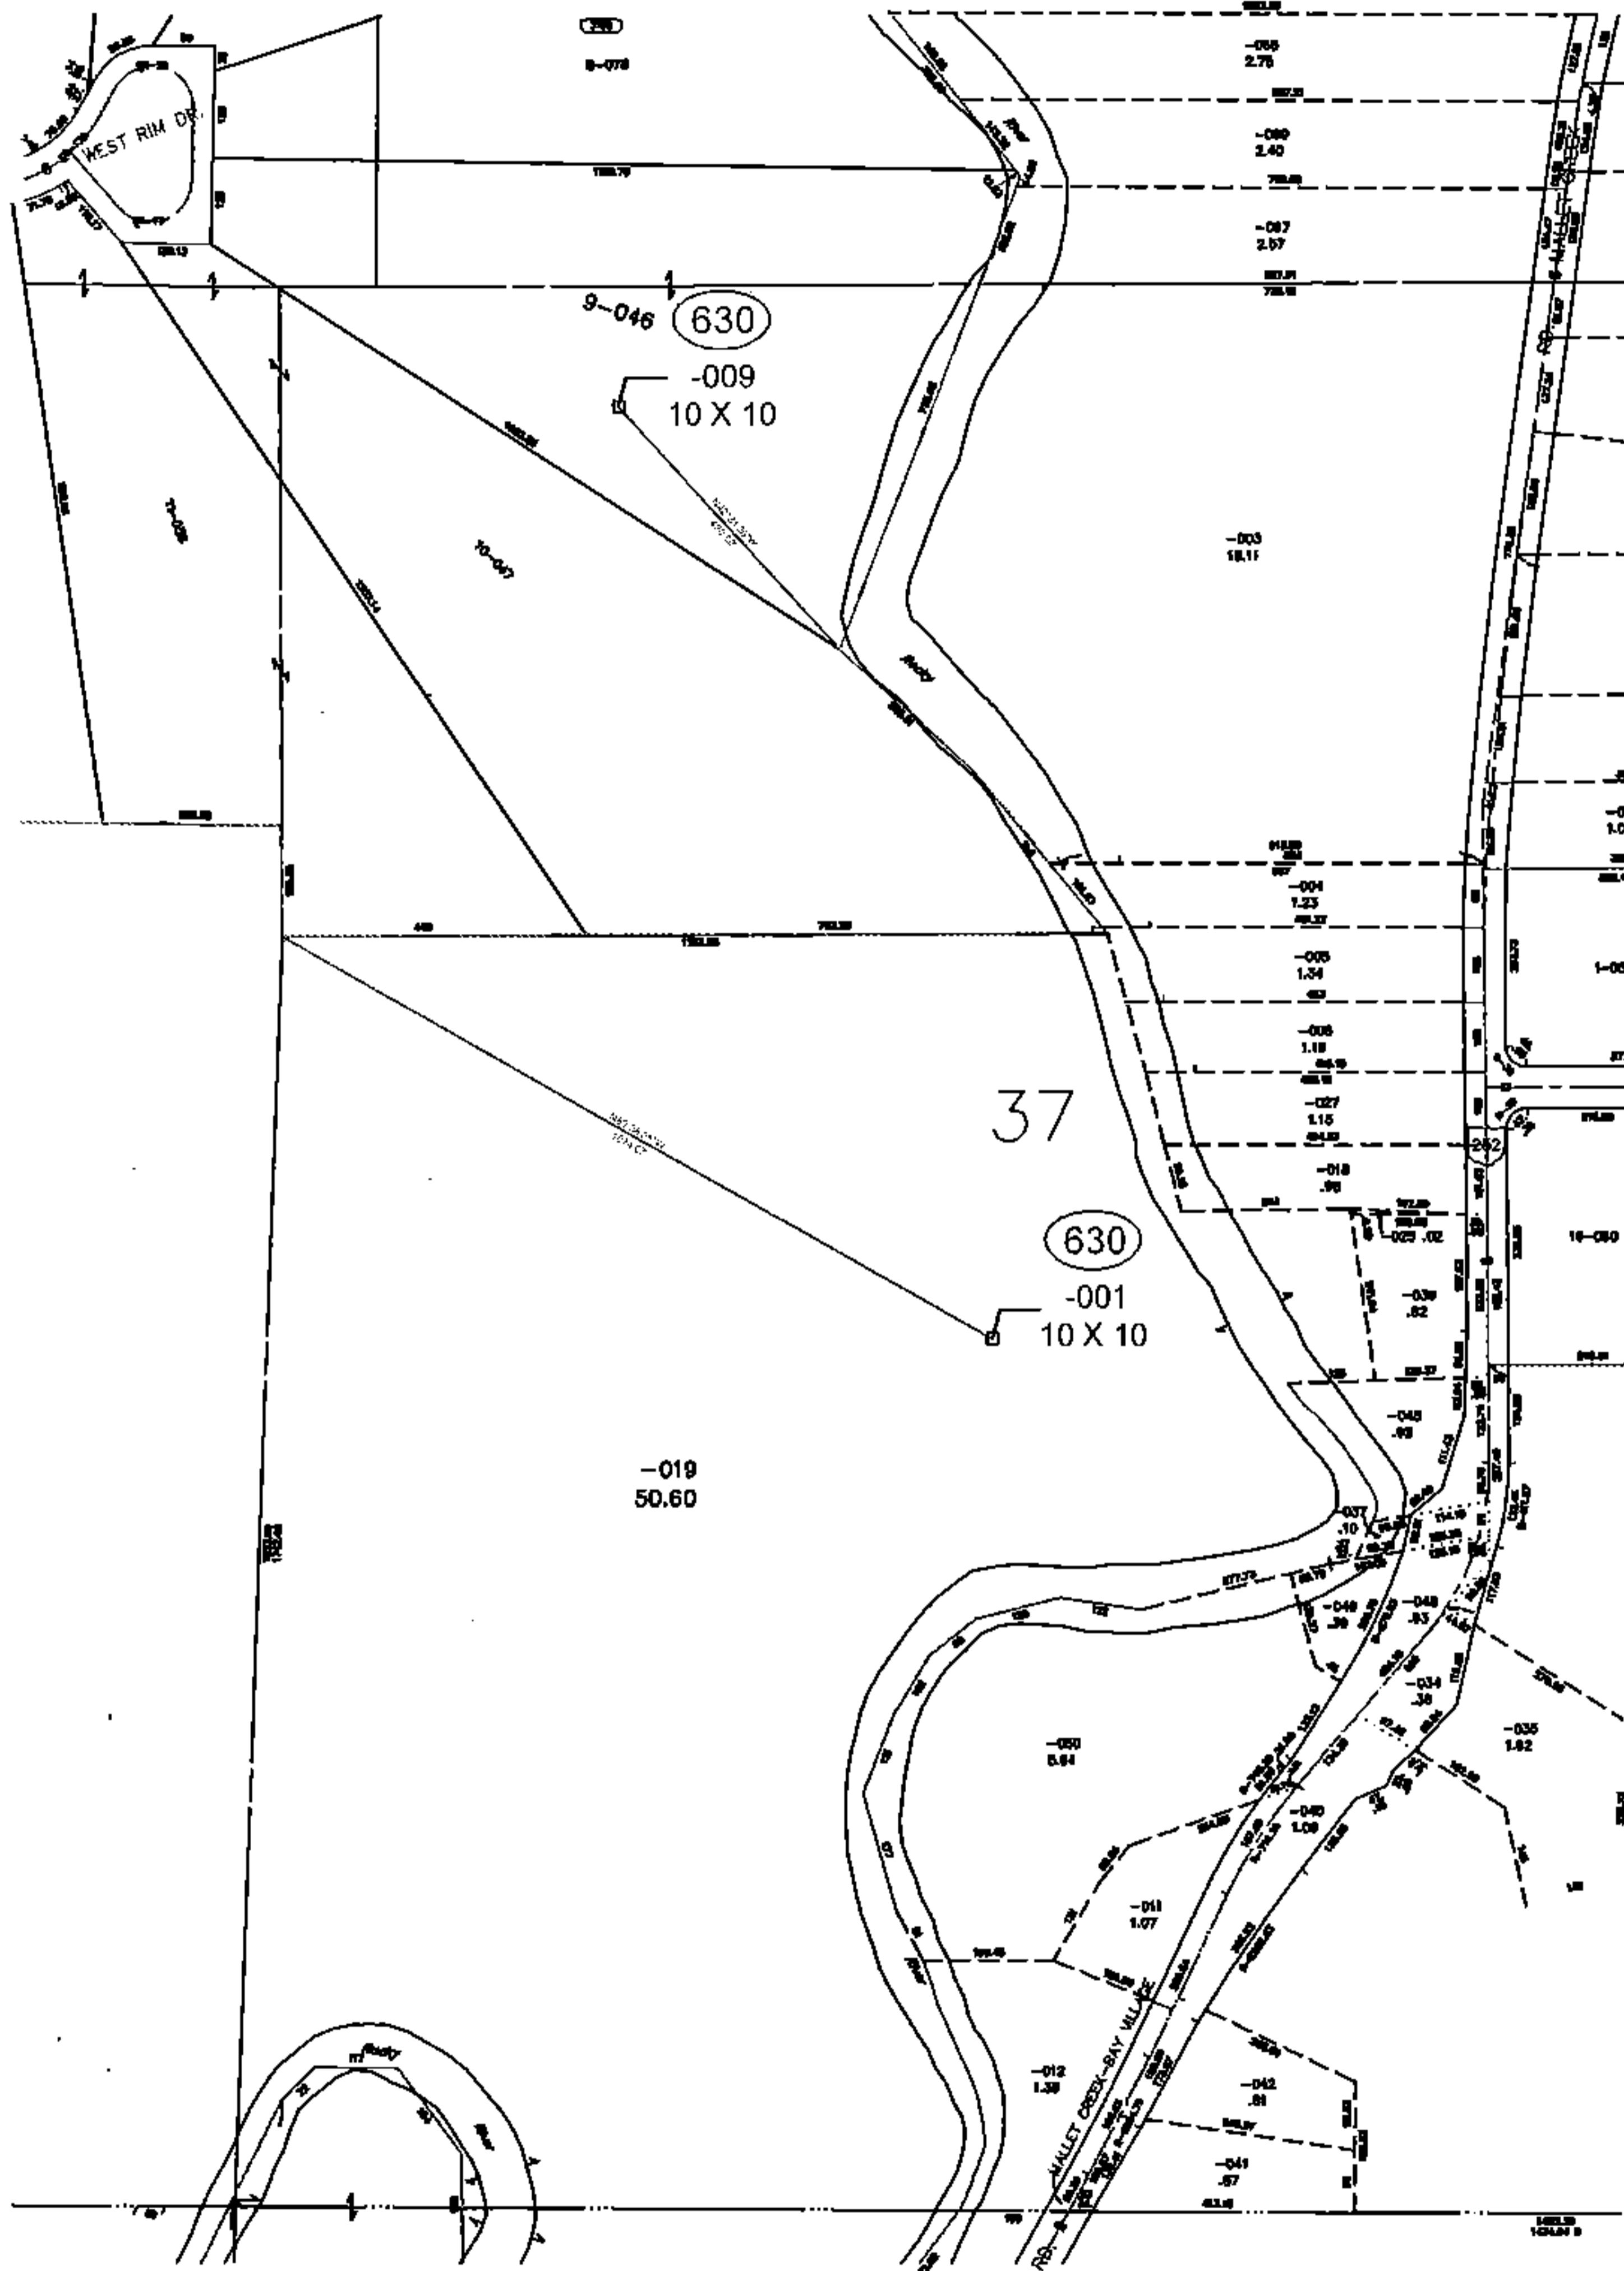


PARENT PARCEL: 12-00-037-000-019 & -046

CHILD PARCEL: 12-00-037-630-001 & -009

STARTING POINT: XXXXXX

14-02968-A

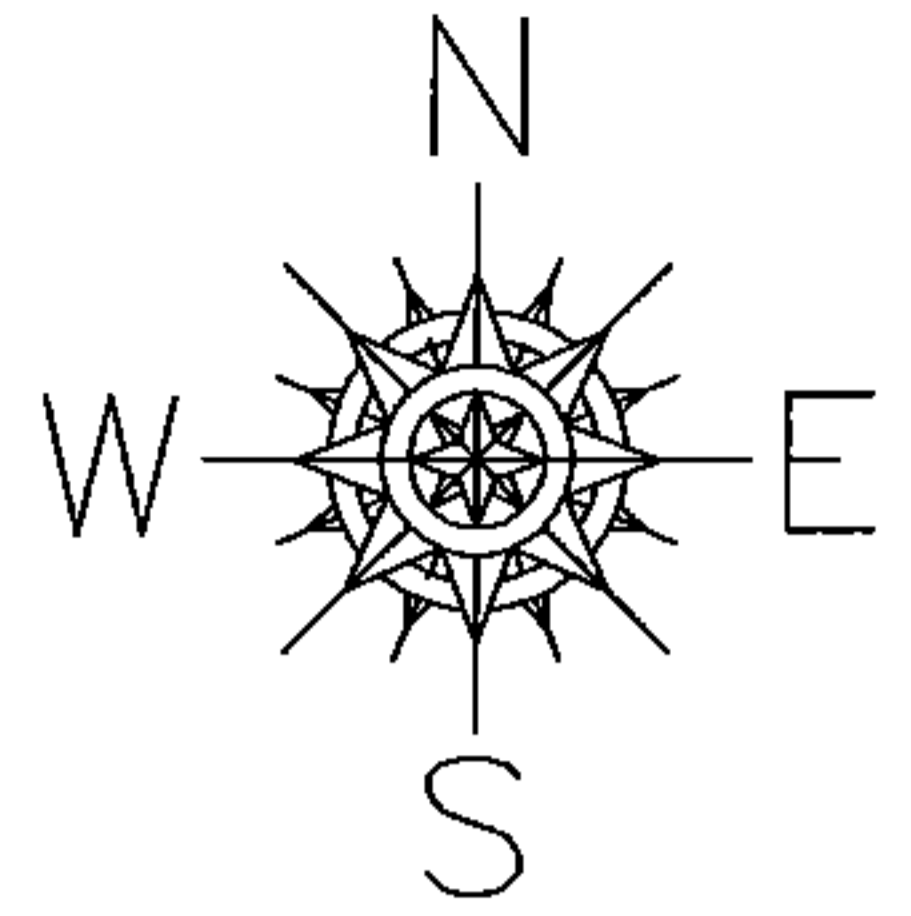


ADD TO DUPLICATE

12-00-037-630-001
10 X 10
API# 34093212480

ADD TO DUPLICATE

12-00-037-630-009
10 X 10
API# 34093212340

4/8/16

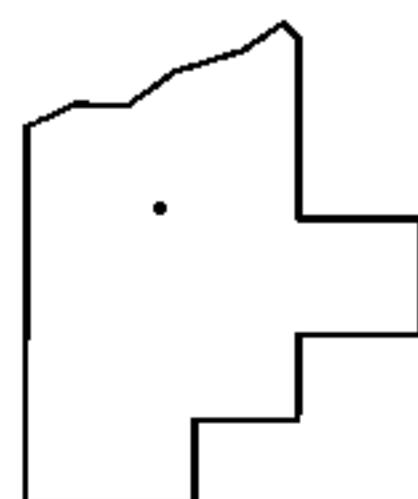

SPLITS/DEEDS PROCESSED

LORAIN COUNTY TAX MAP DEPARTMENT
226 MIDDLE AVE. ELYRIA, OHIO

SURVEYED BY: NA
CLOSURE: NA
MAP PAGE(S): 12-00-037
APPROVED BY: TJS DATE: 6/16/14
SCALE: 1"=400 PRIOR INST.: NA