
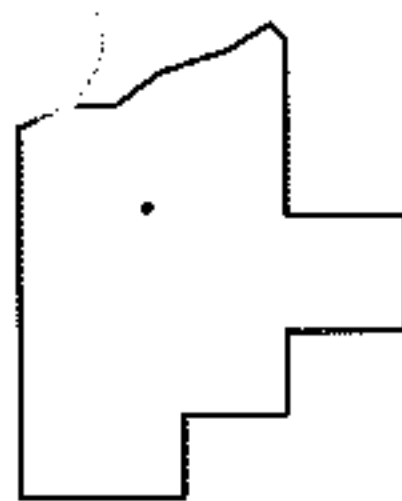
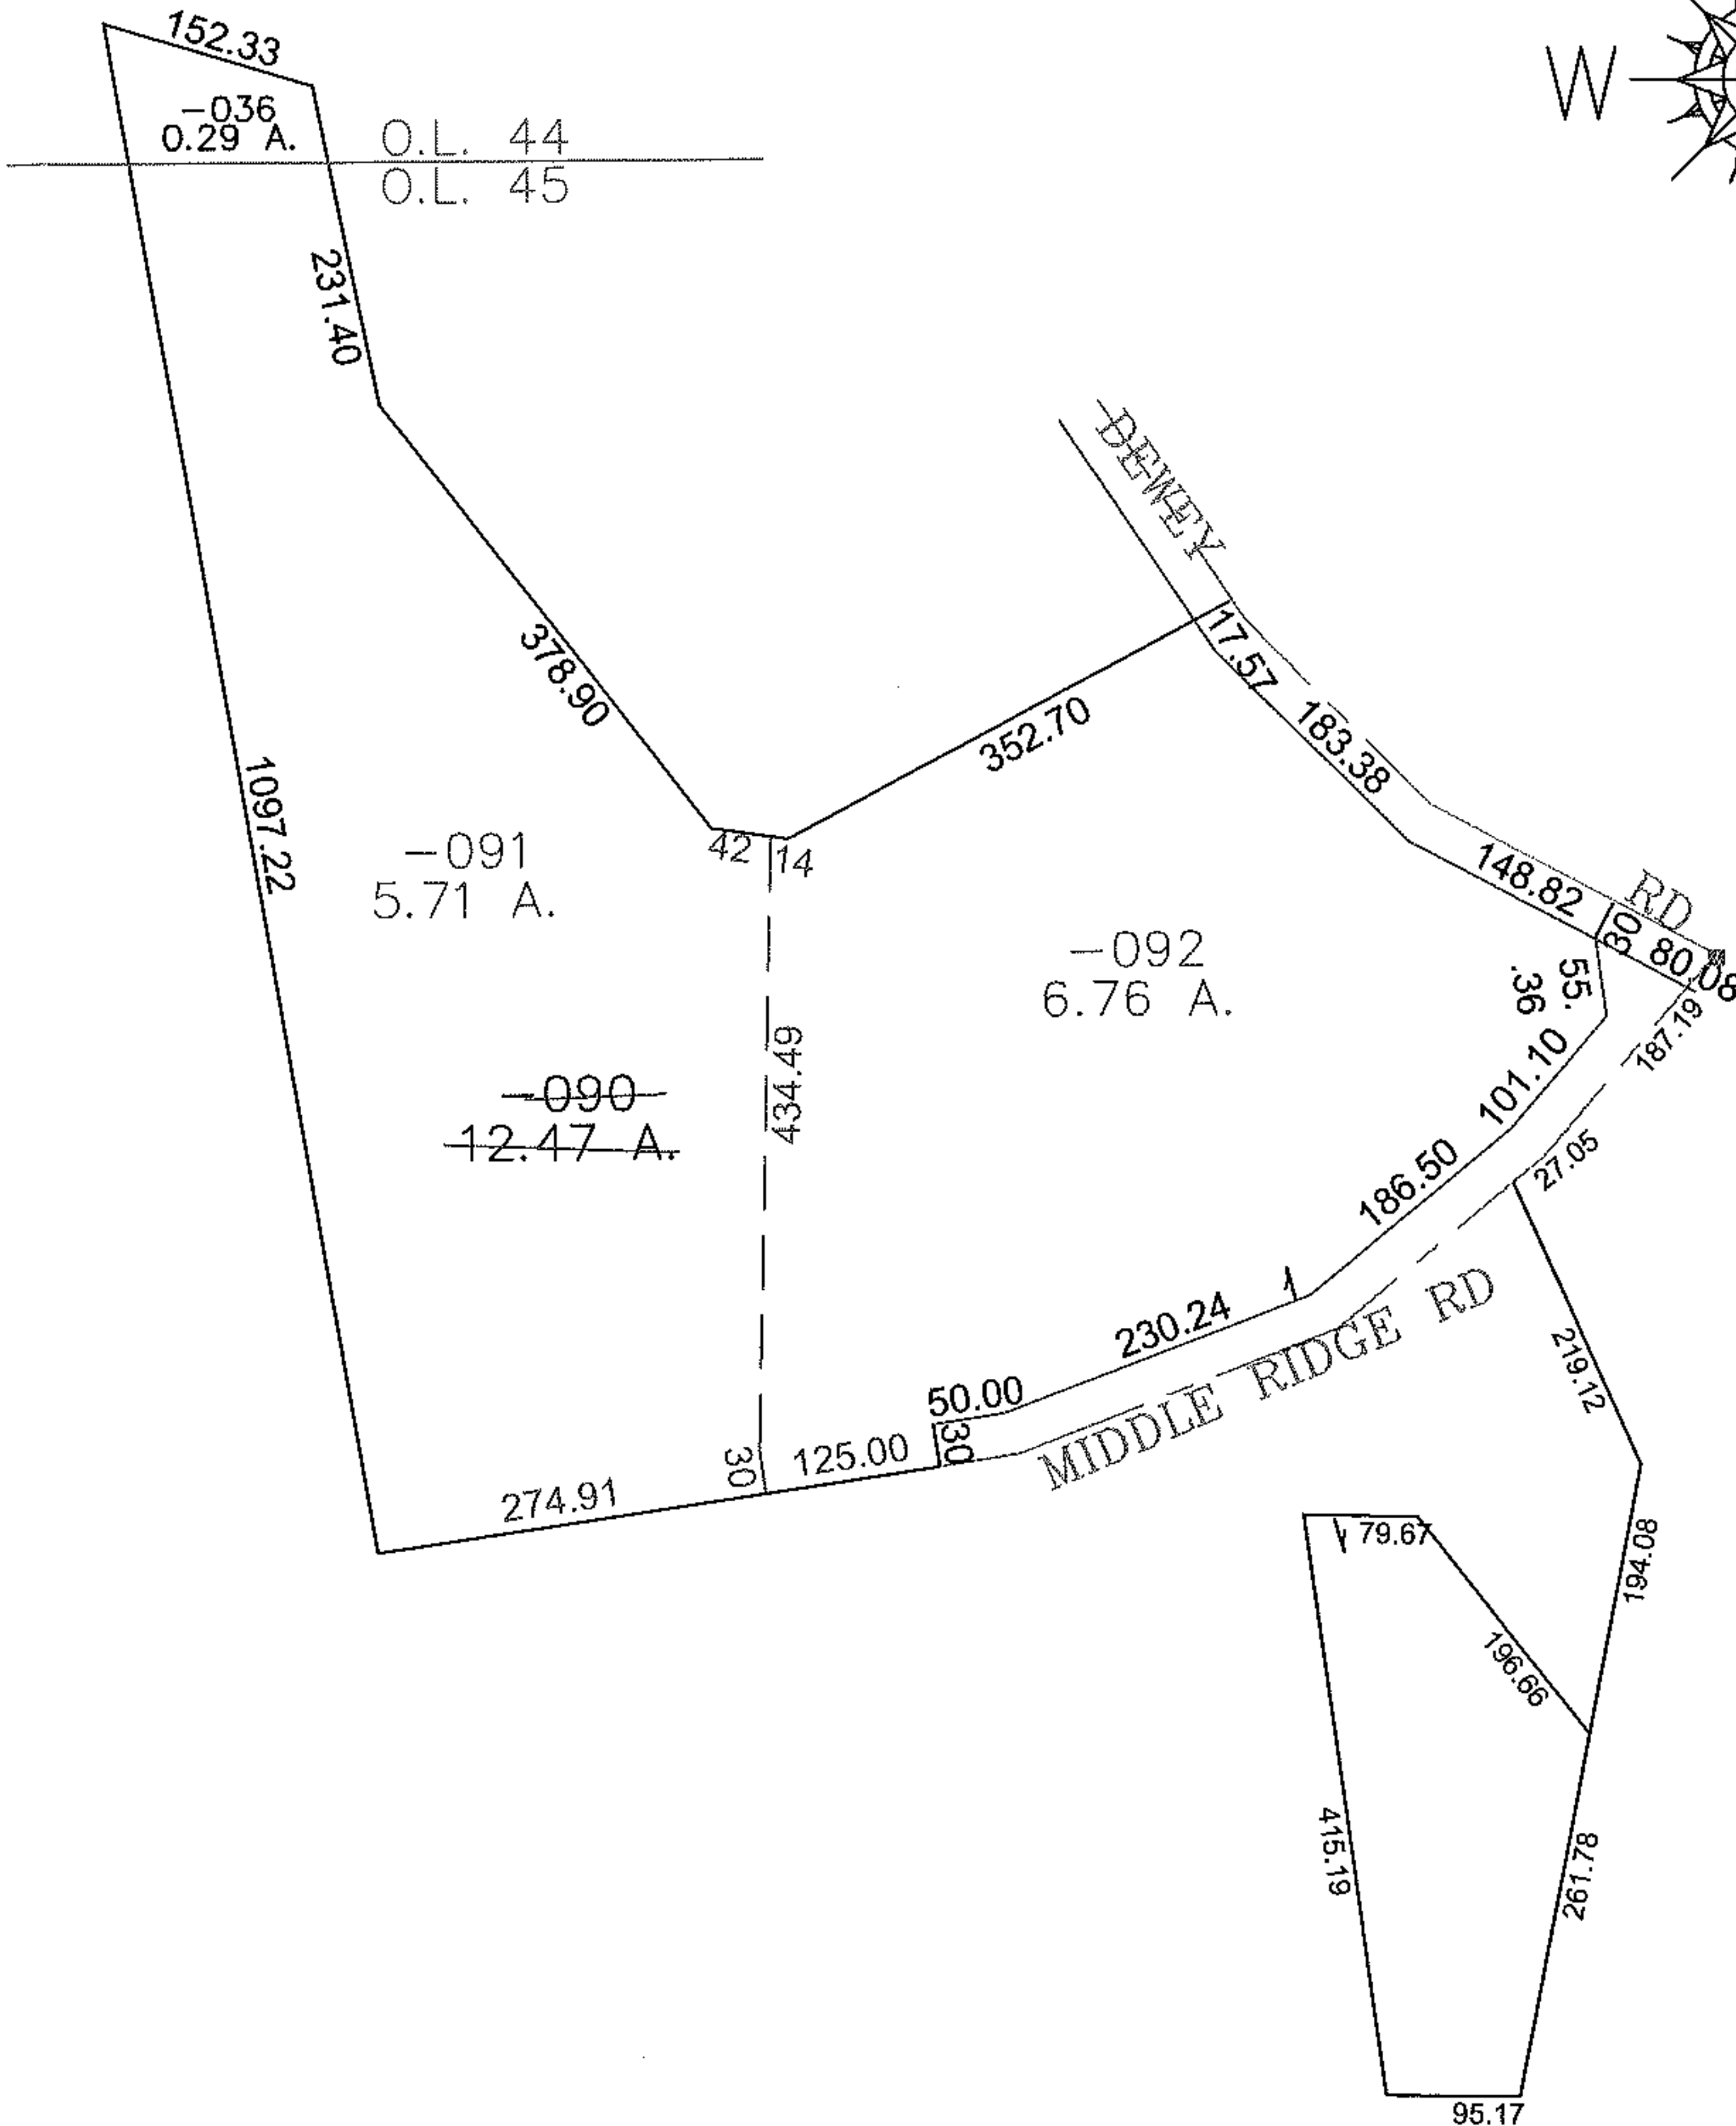


PARENT PARCEL: 05-00-044-000-036, 05-00-045-000-090

CHILD PARCEL: 05-00-045-000-091, -092

STARTING POINT: CENTERLINE OF DEWEY RD & MIDDLE RIDGE RD

11-02969

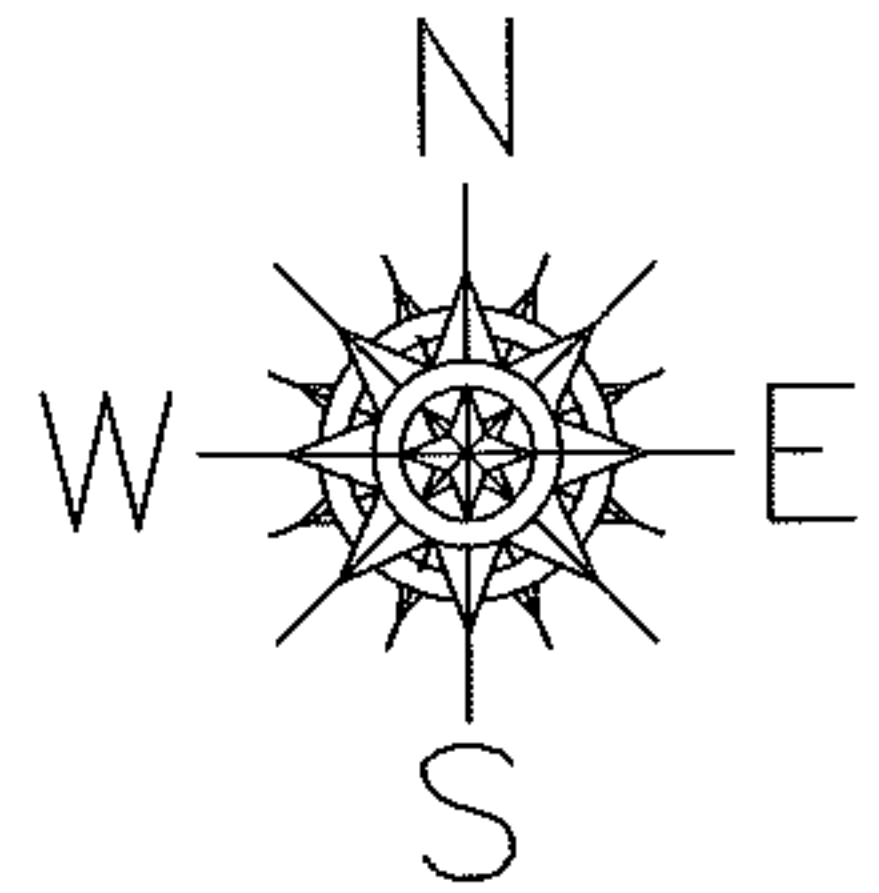

SPLITS/DEEDS PROCESSED
 LORAIN COUNTY TAX MAP DEPARTMENT
 226 MIDDLE AVE. ELYRIA, OHIO

SURVEYED BY: THOMAS SIMON
 CLOSURE: 0.00 : 10,000
 MAP PAGE(S): 05-00-044-A
 APPROVED BY: JAH DATE: 11/17/2011
 SCALE: 1" = 200 PRIOR INSTRUMENT: 20000700117